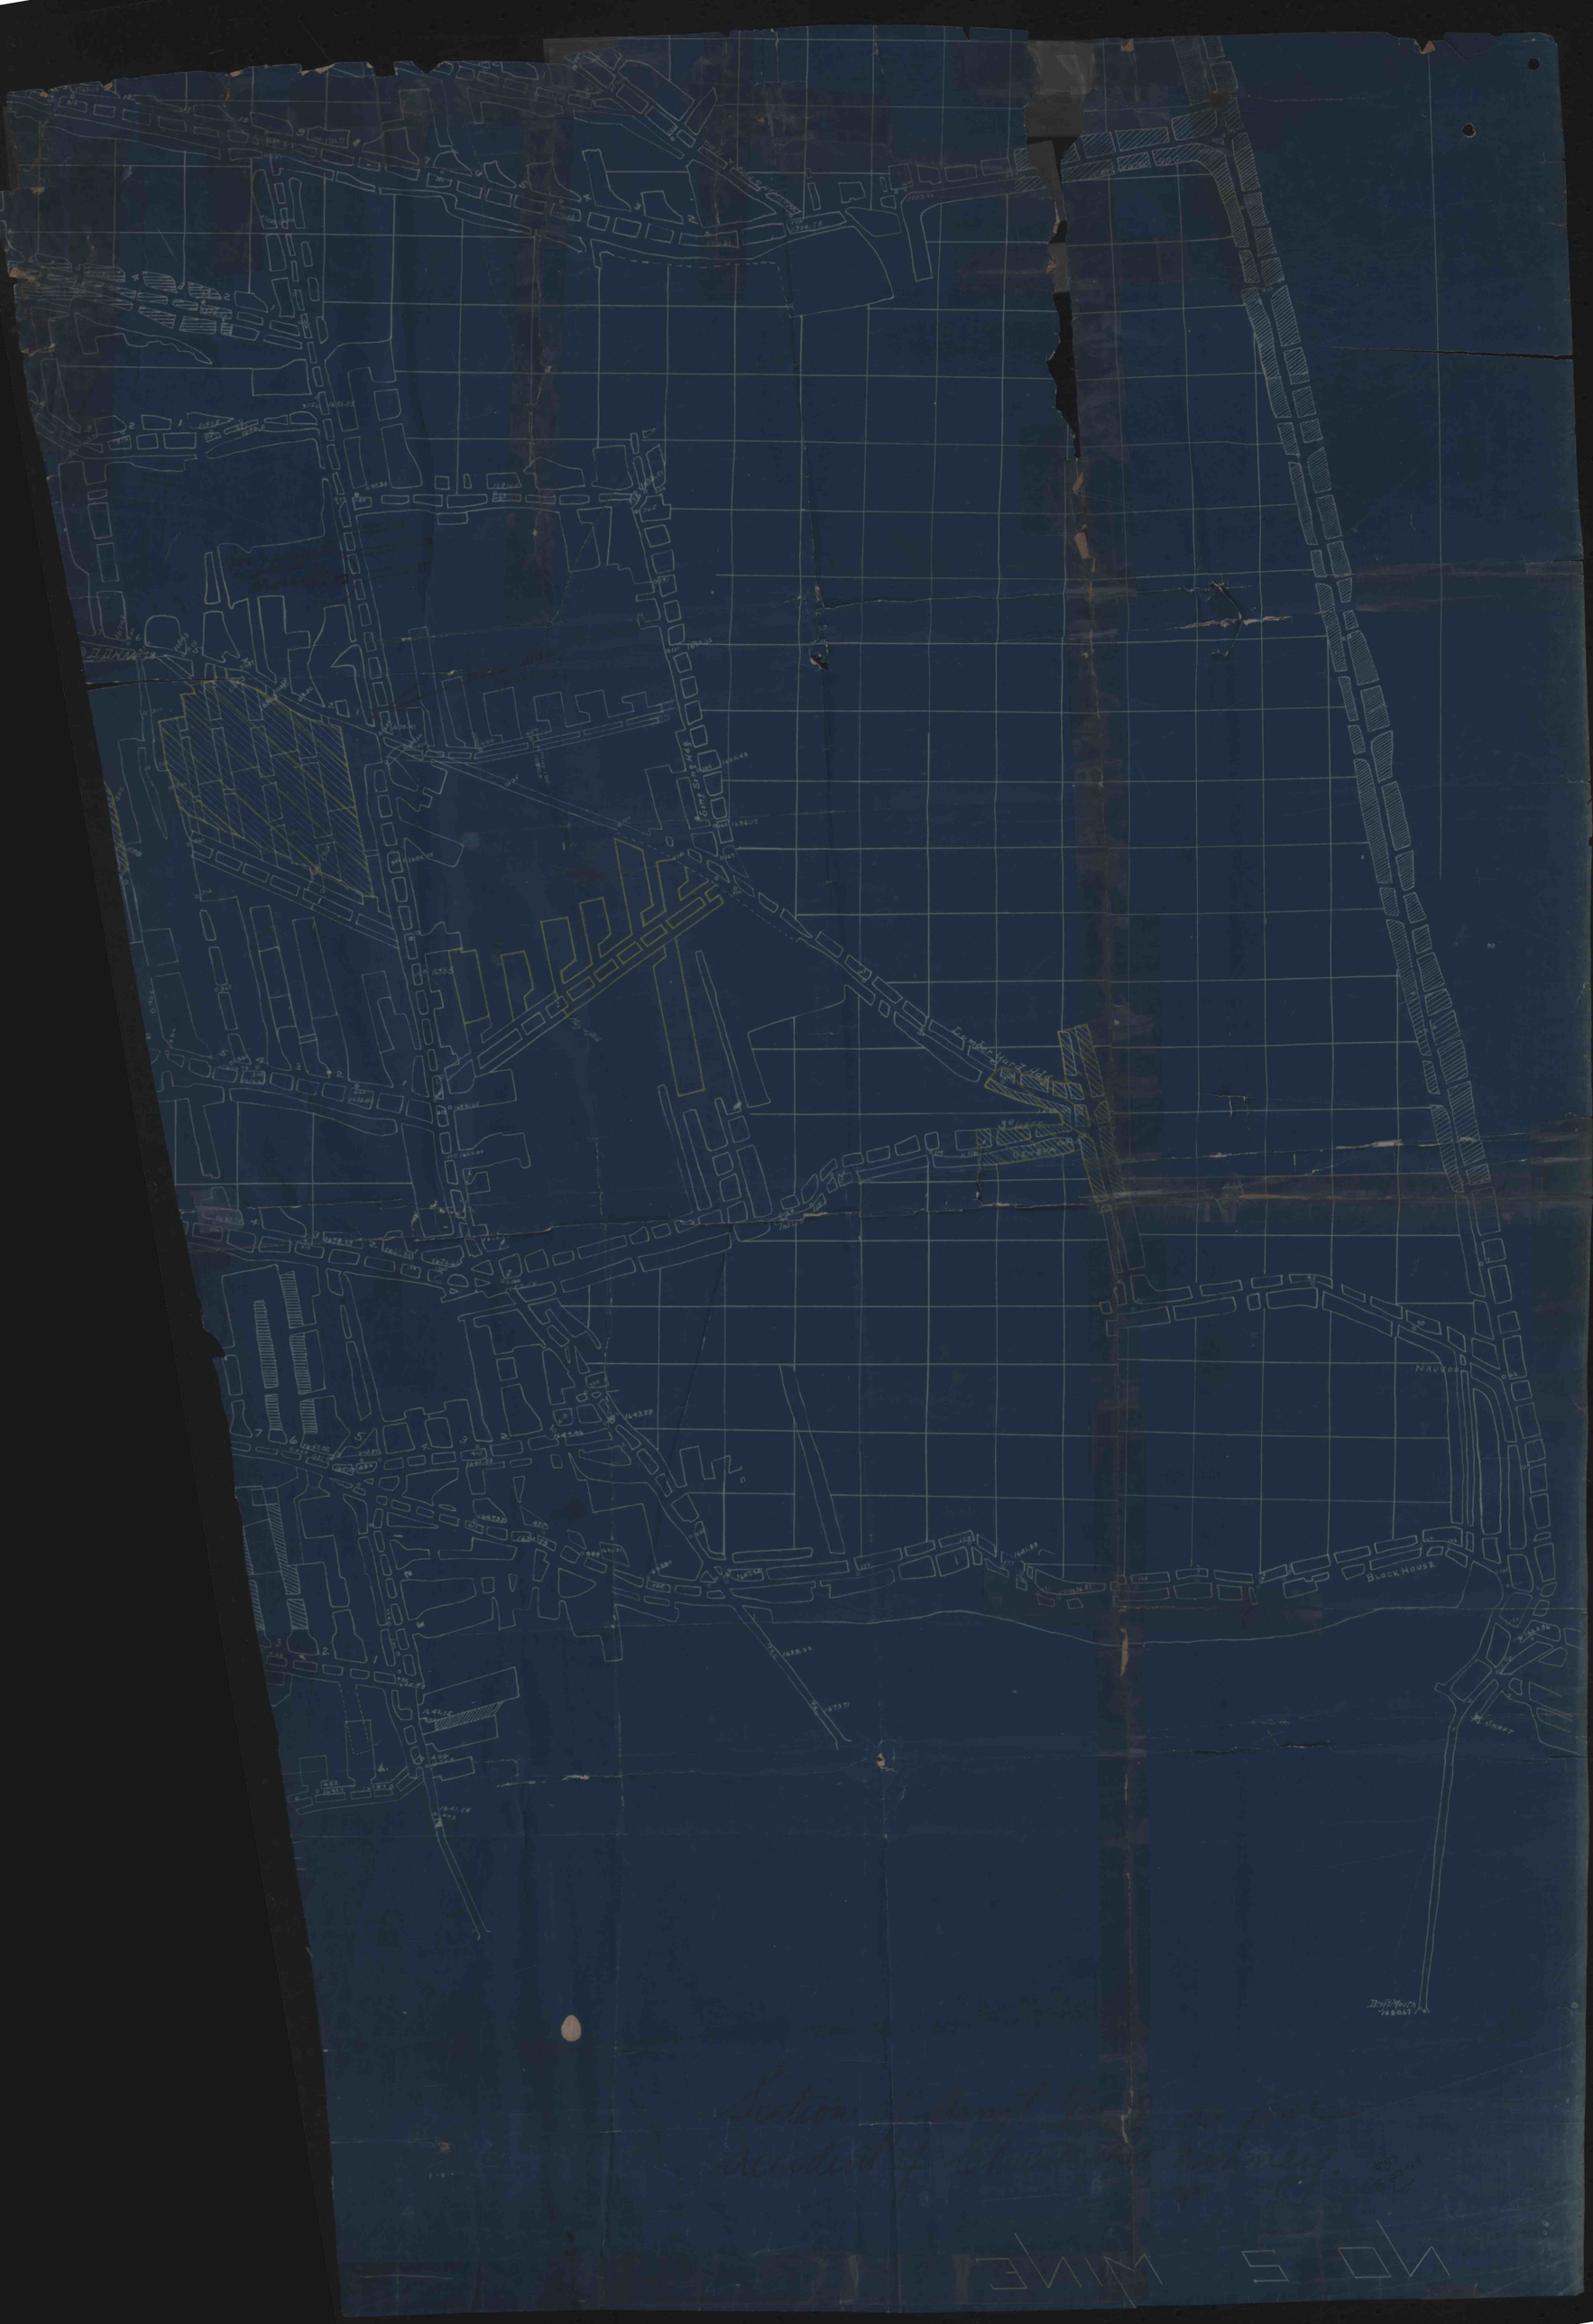
BLOCKHOUSE