


ERTHA MINE

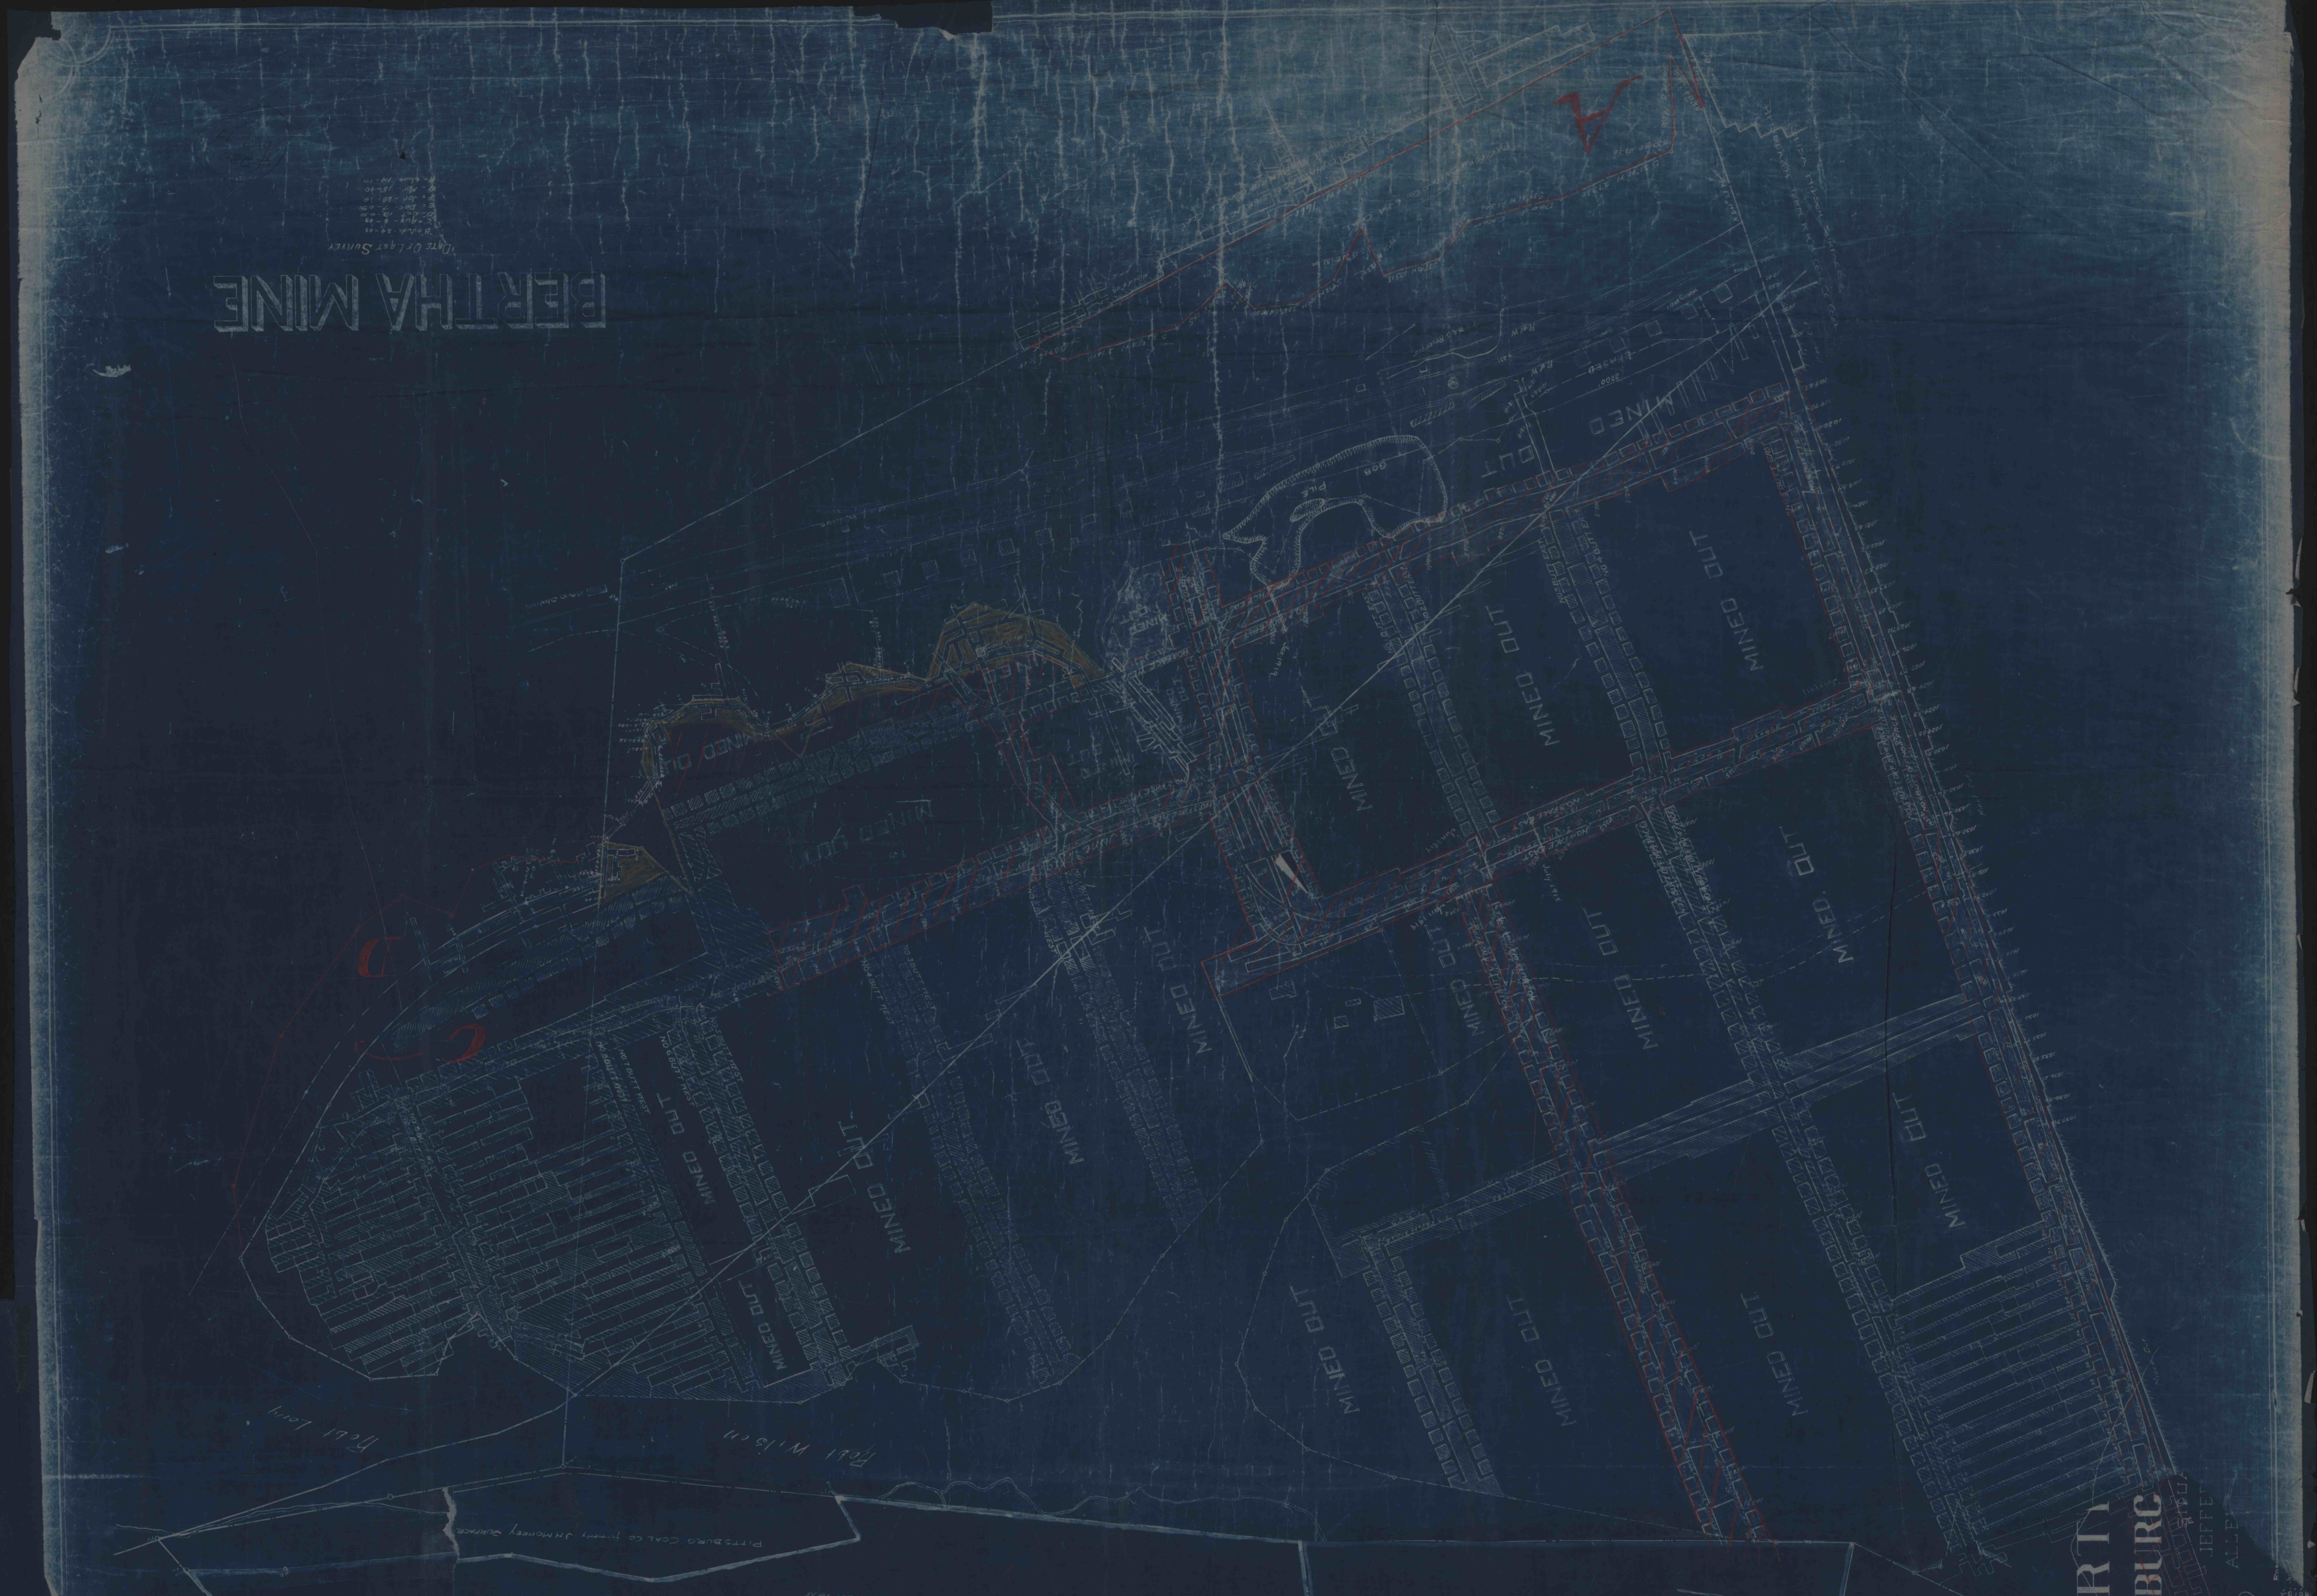

BERTH  
PITTSBURG

