

#292
6-11-98
C.C.



OFFICE COPY

1900

Ralph Bloom Mine # 1.

Surveyed - 6-30-68

Advanced Mining - 6-30-68 to 12-30-68.

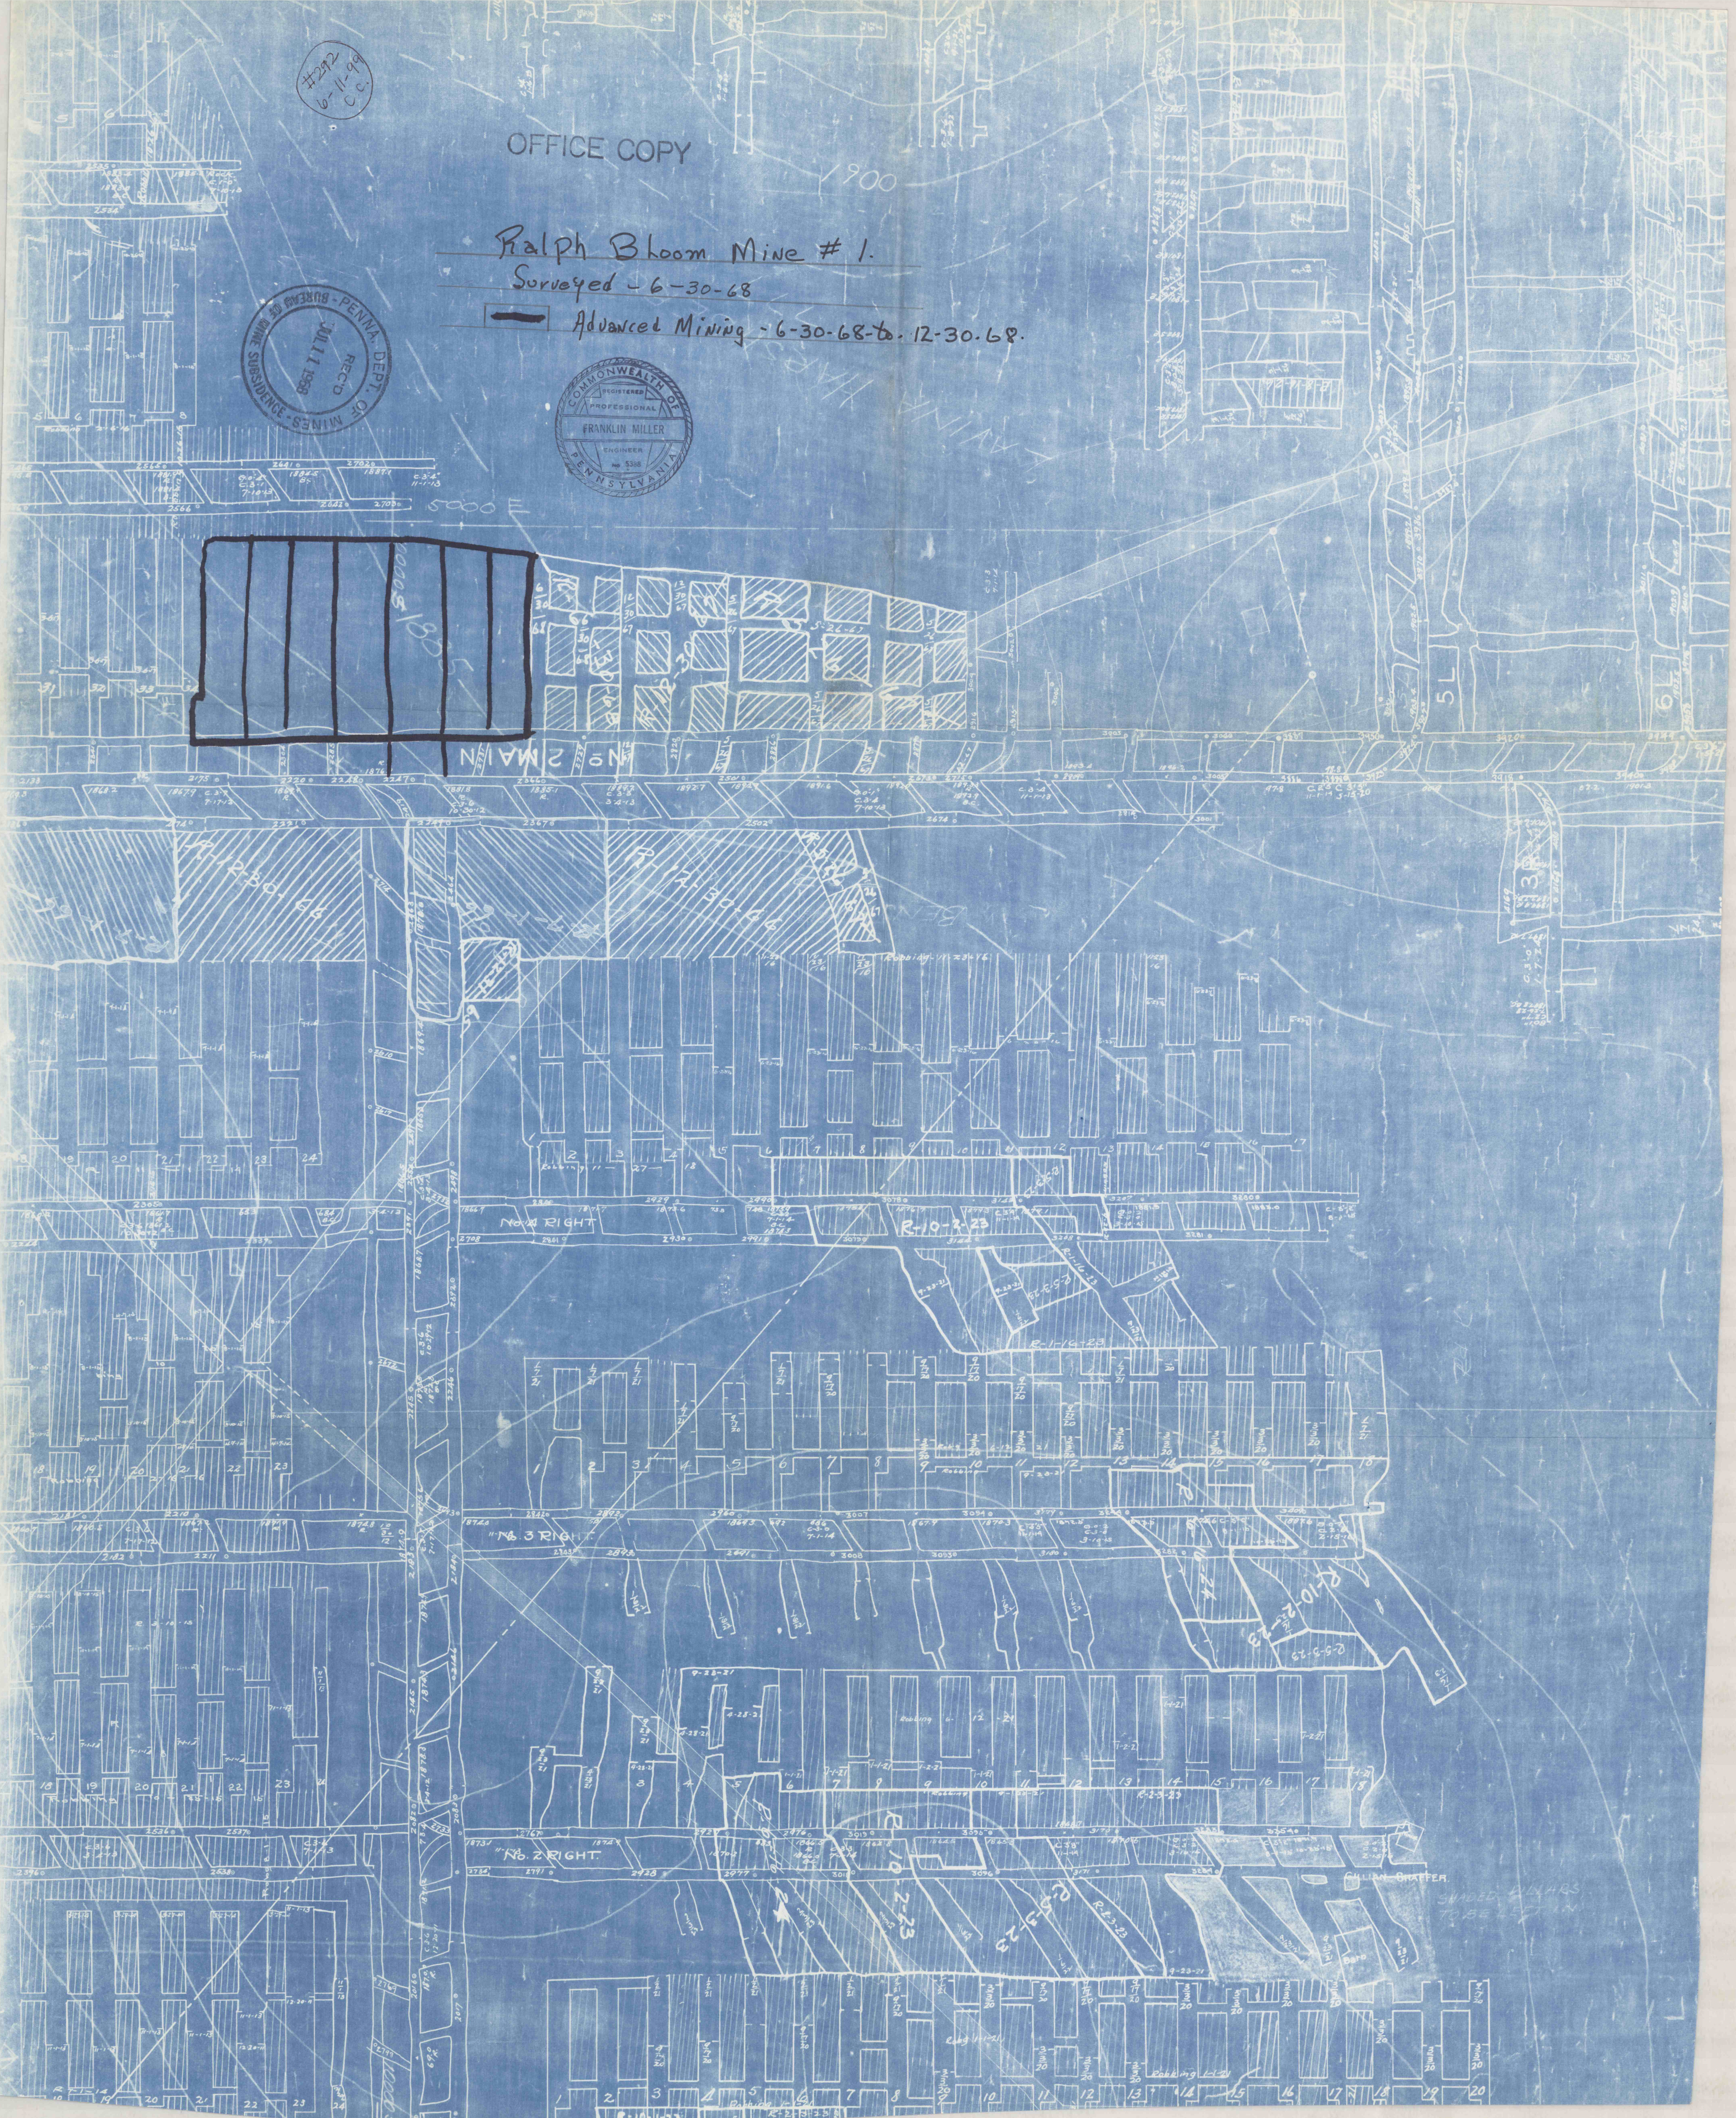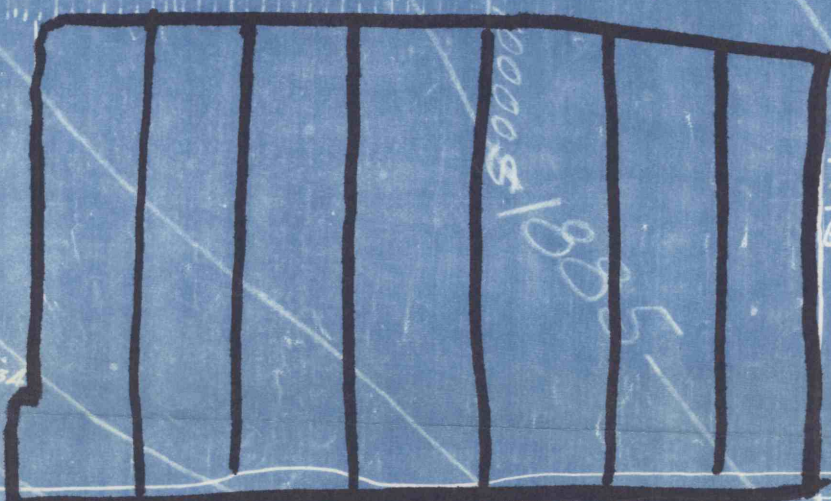

SHADED AREAS TO BE LEFT IN