


#458  
6-21-79  
C.C.

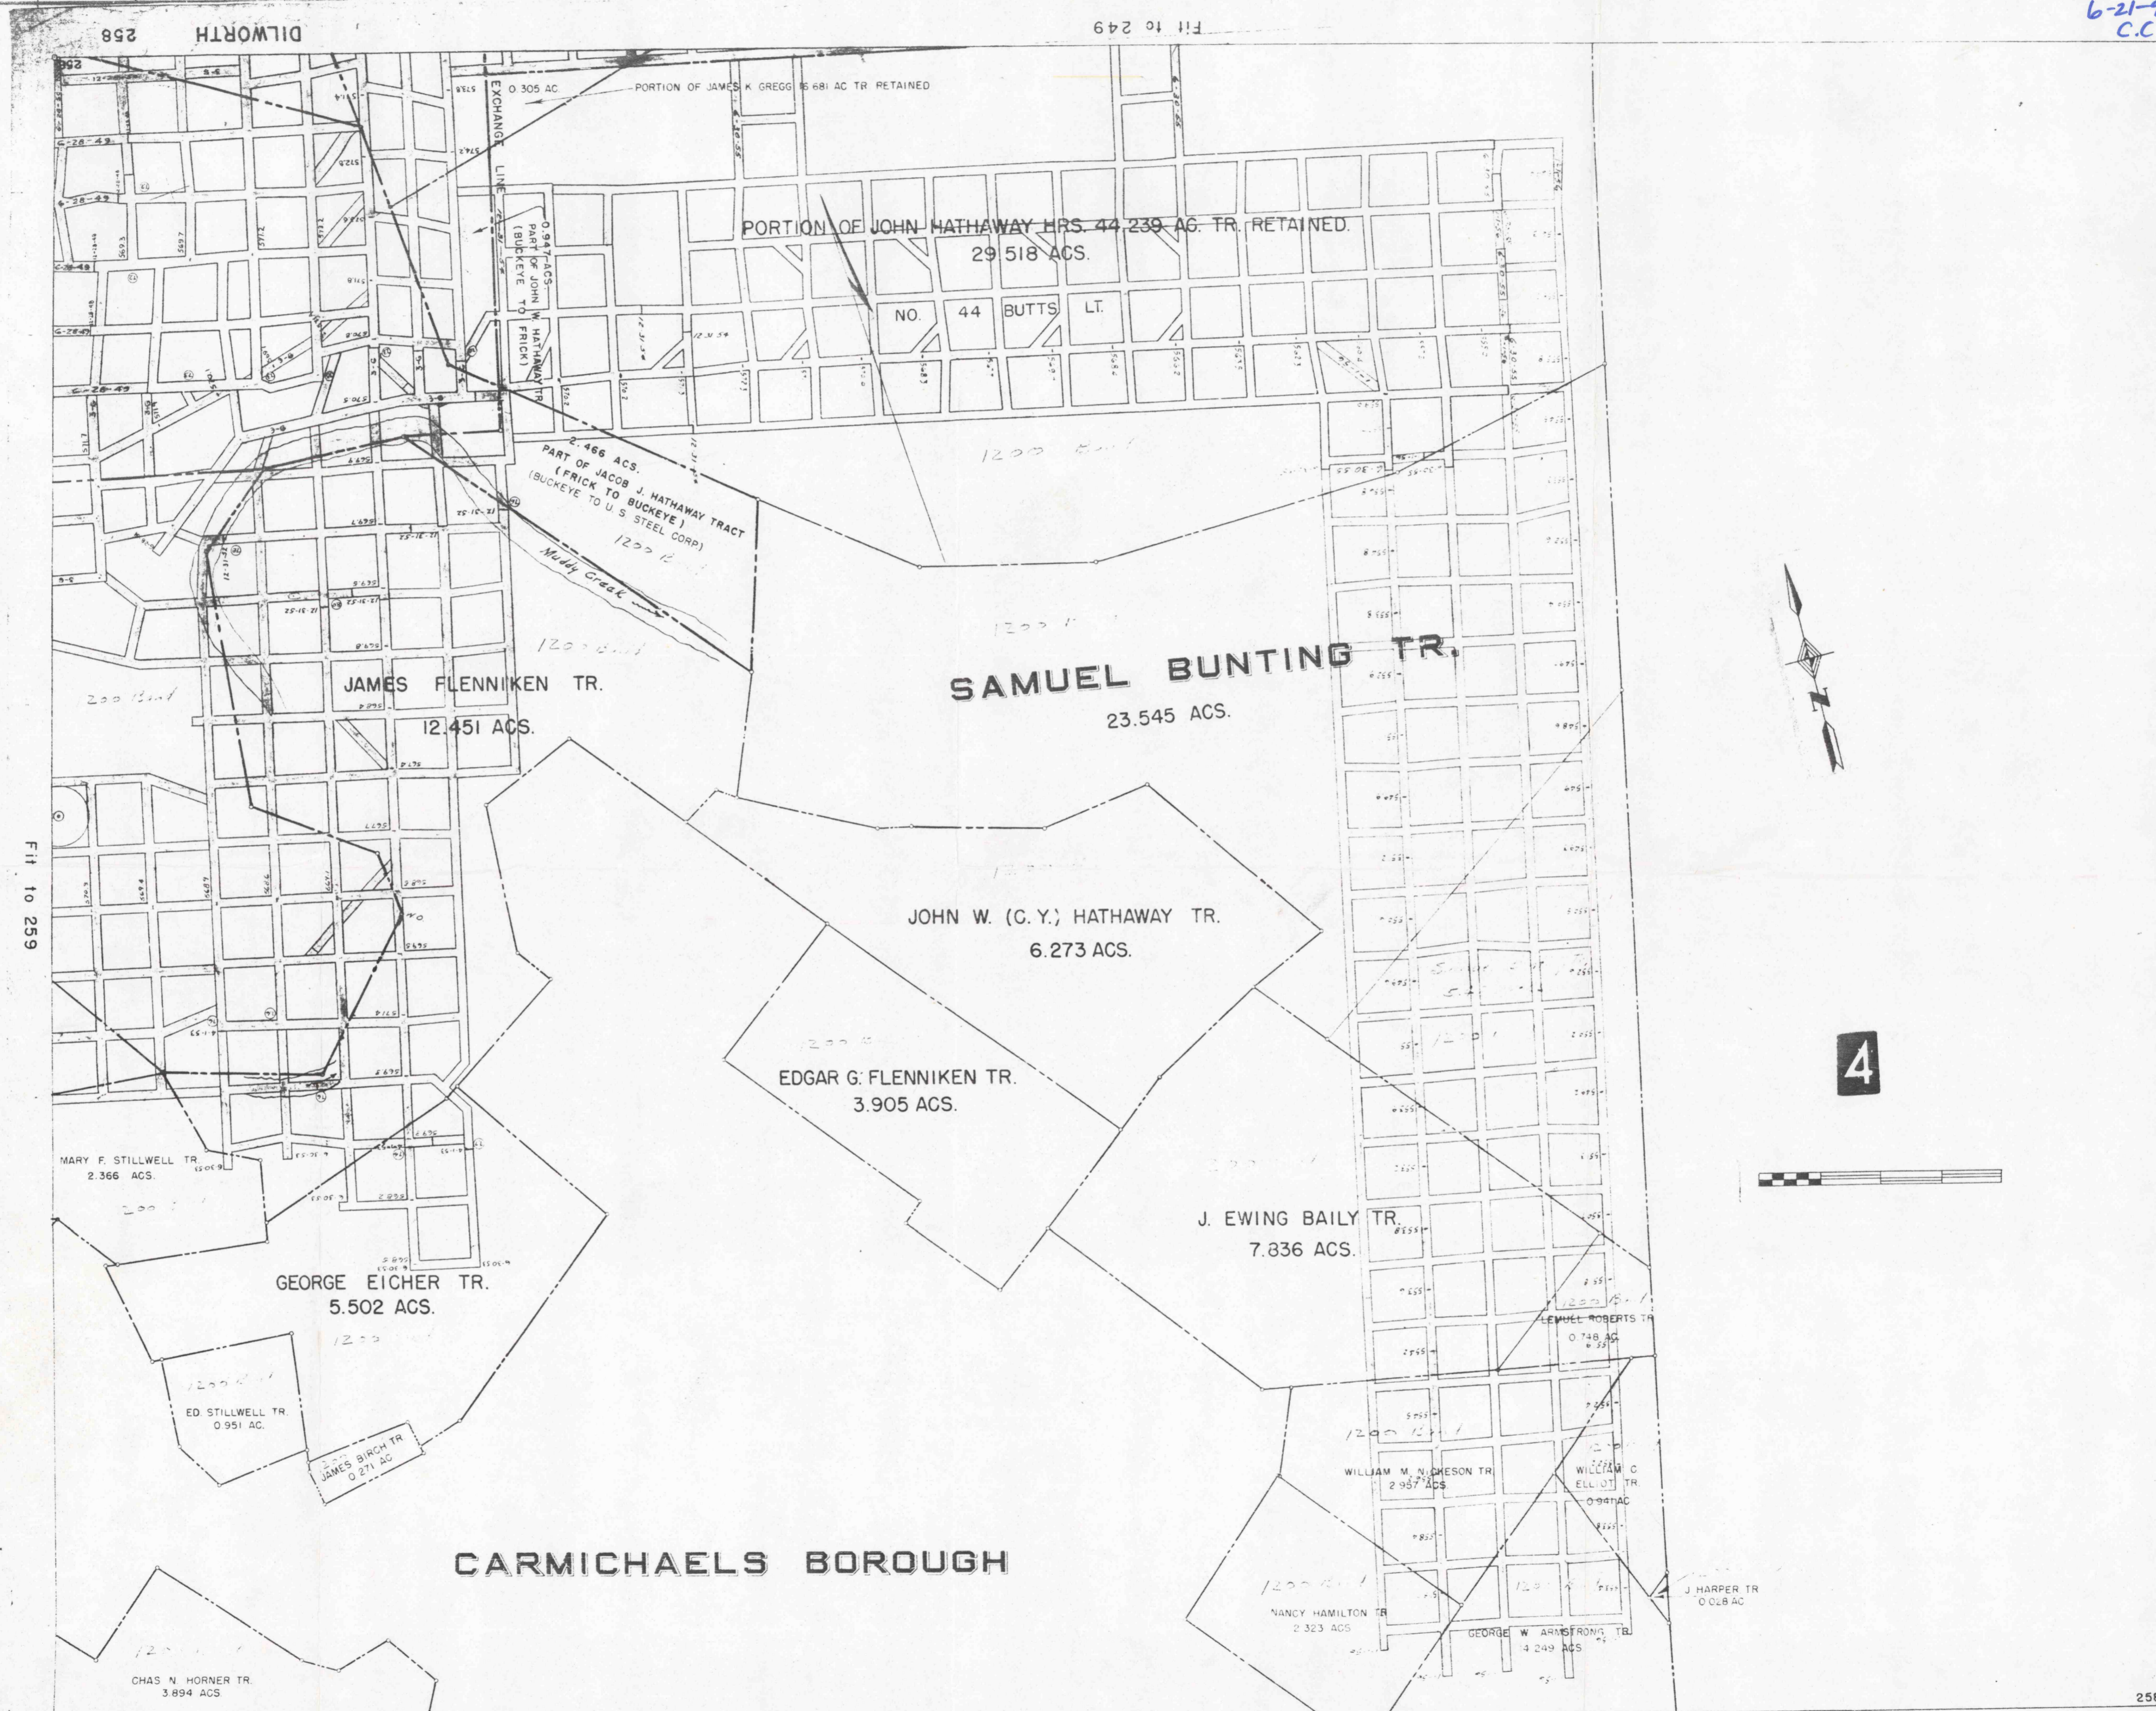

PEC 03116 461 27X 343792