



6 MONTH PROJECTION

SUBSIDENCE BOUNDARY

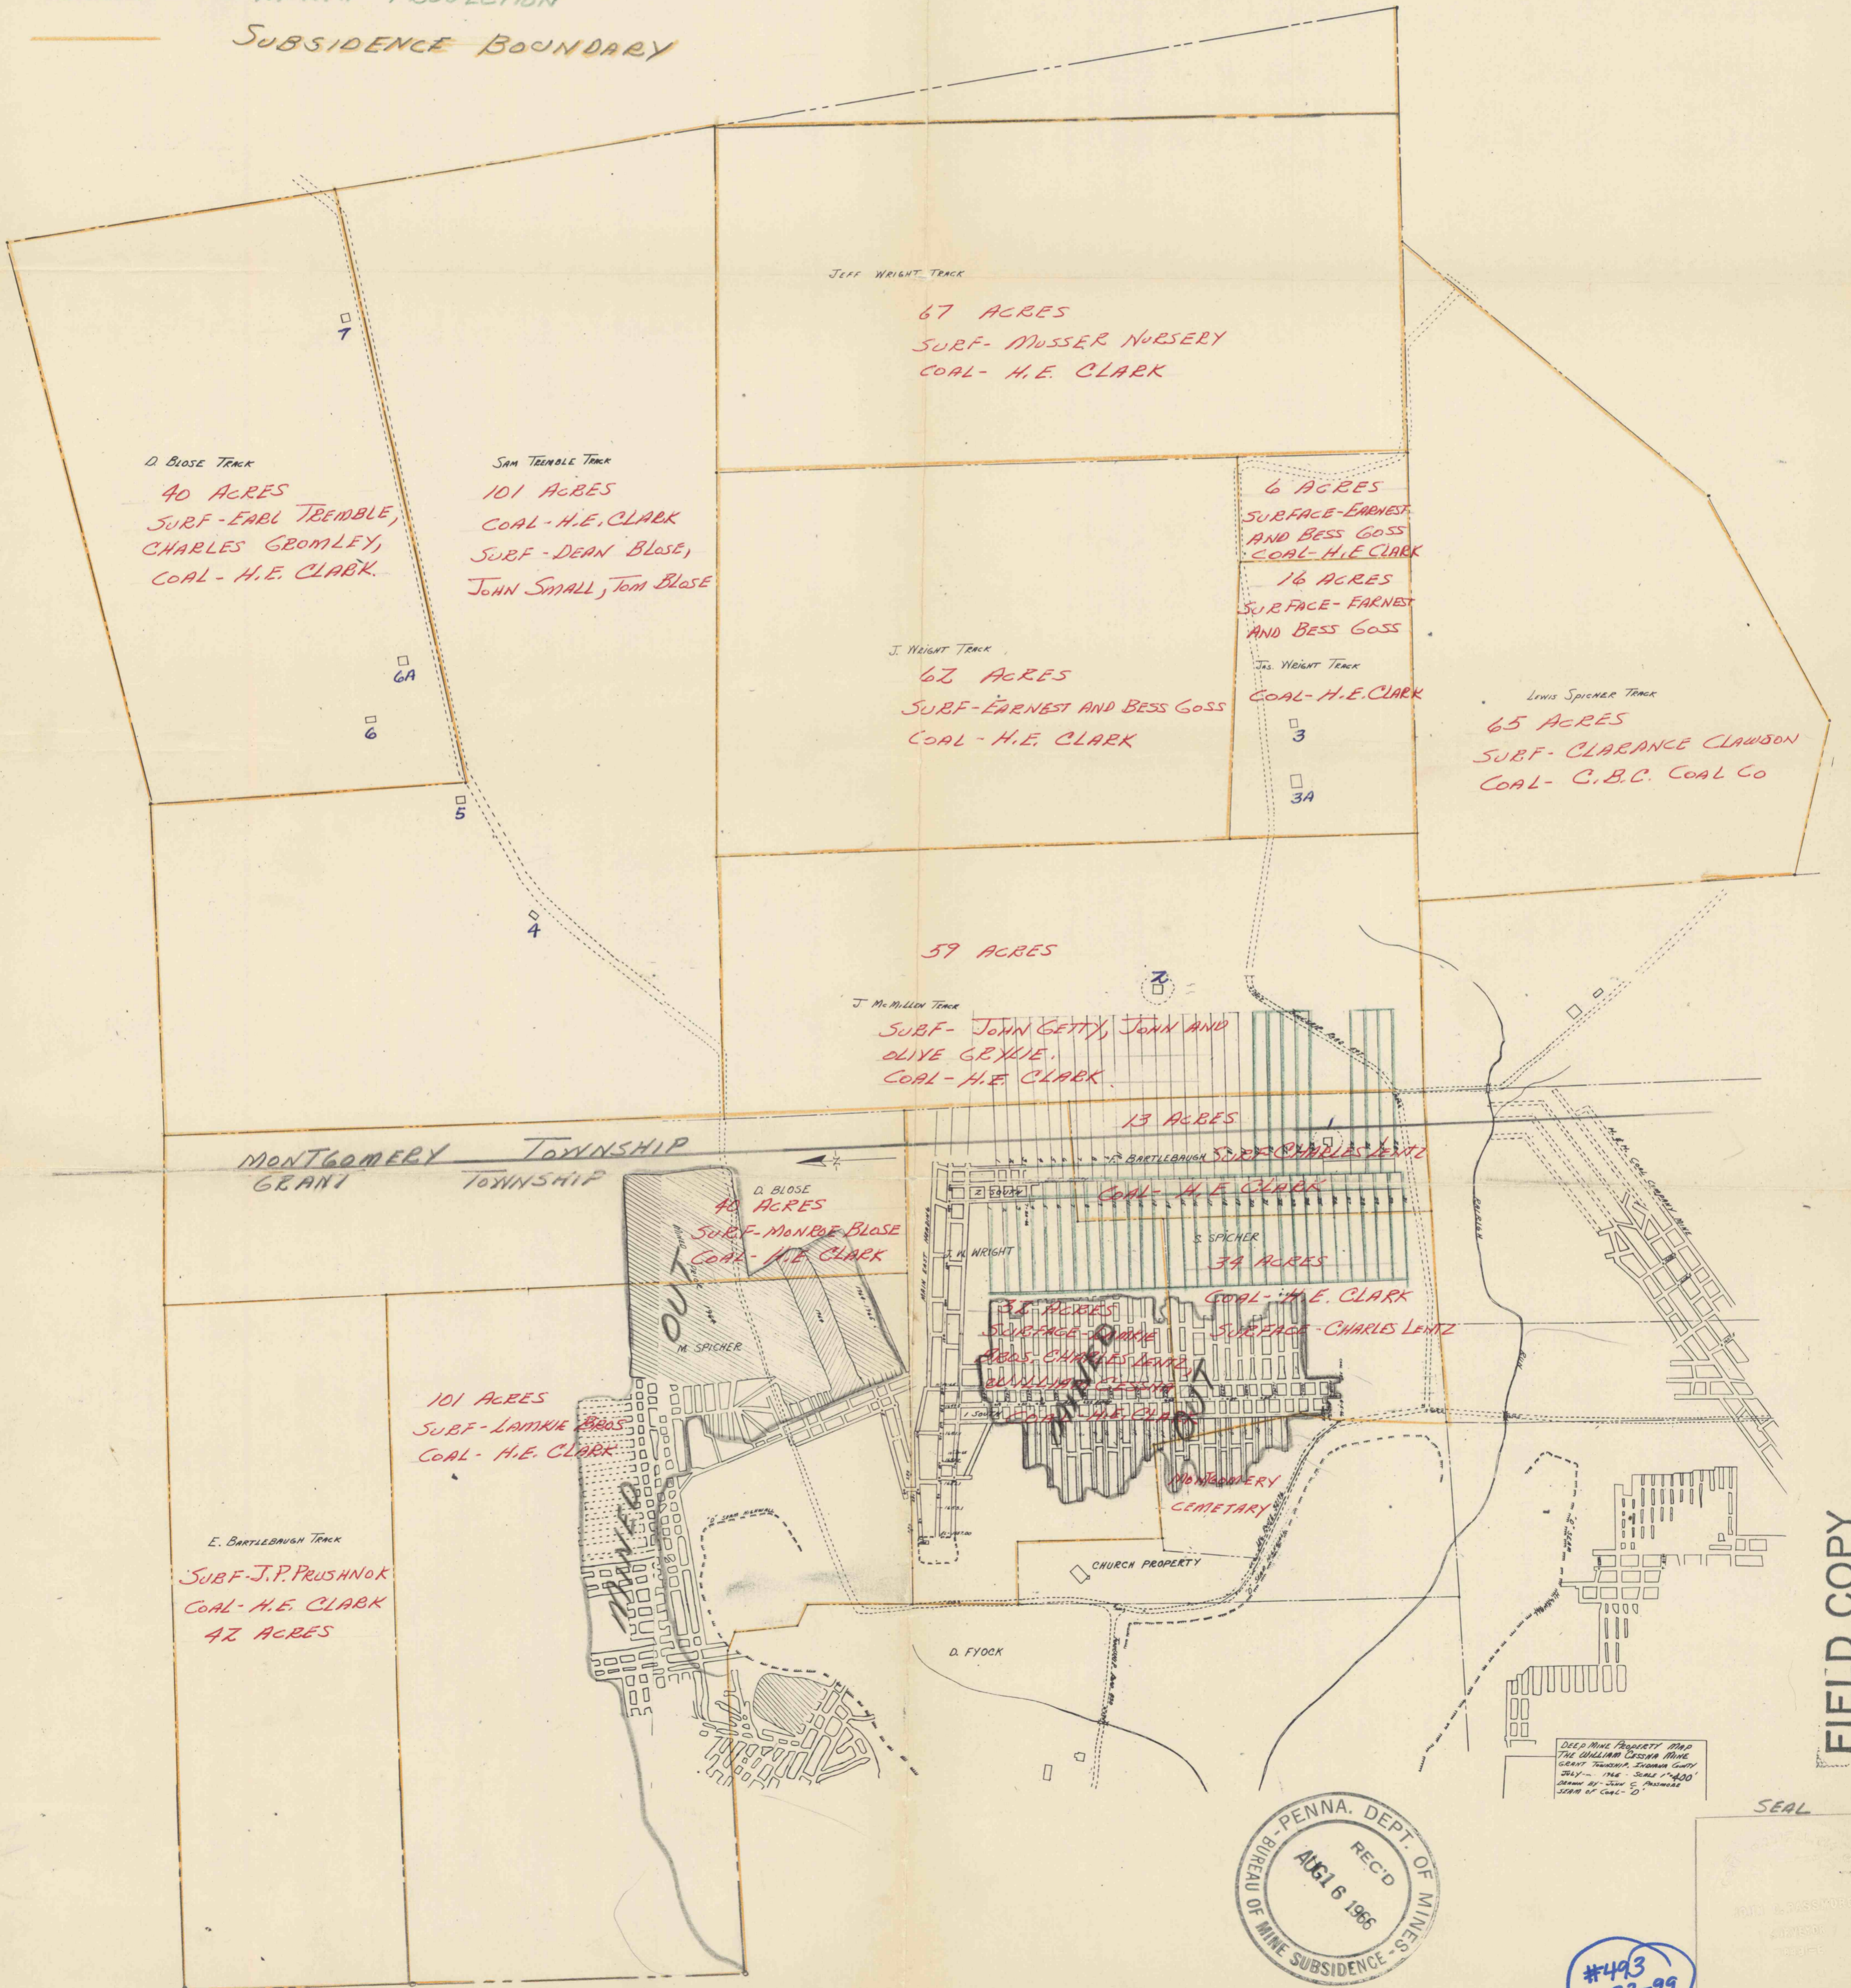

FIELD COPY

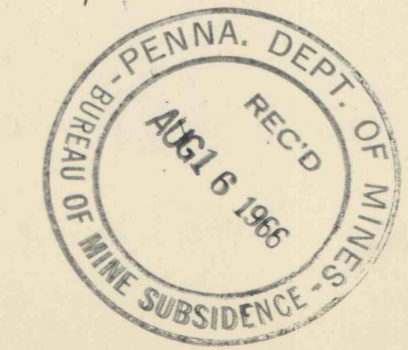

#443  
6-23-99  
C.F.I.

SEAL