


REVISED MAP
DATE- 5-18-67

PRESENT SUBSIDENCE BOUNDARY

SUBSIDENCE BOUNDARY

ADDITIONAL ACBEAGE

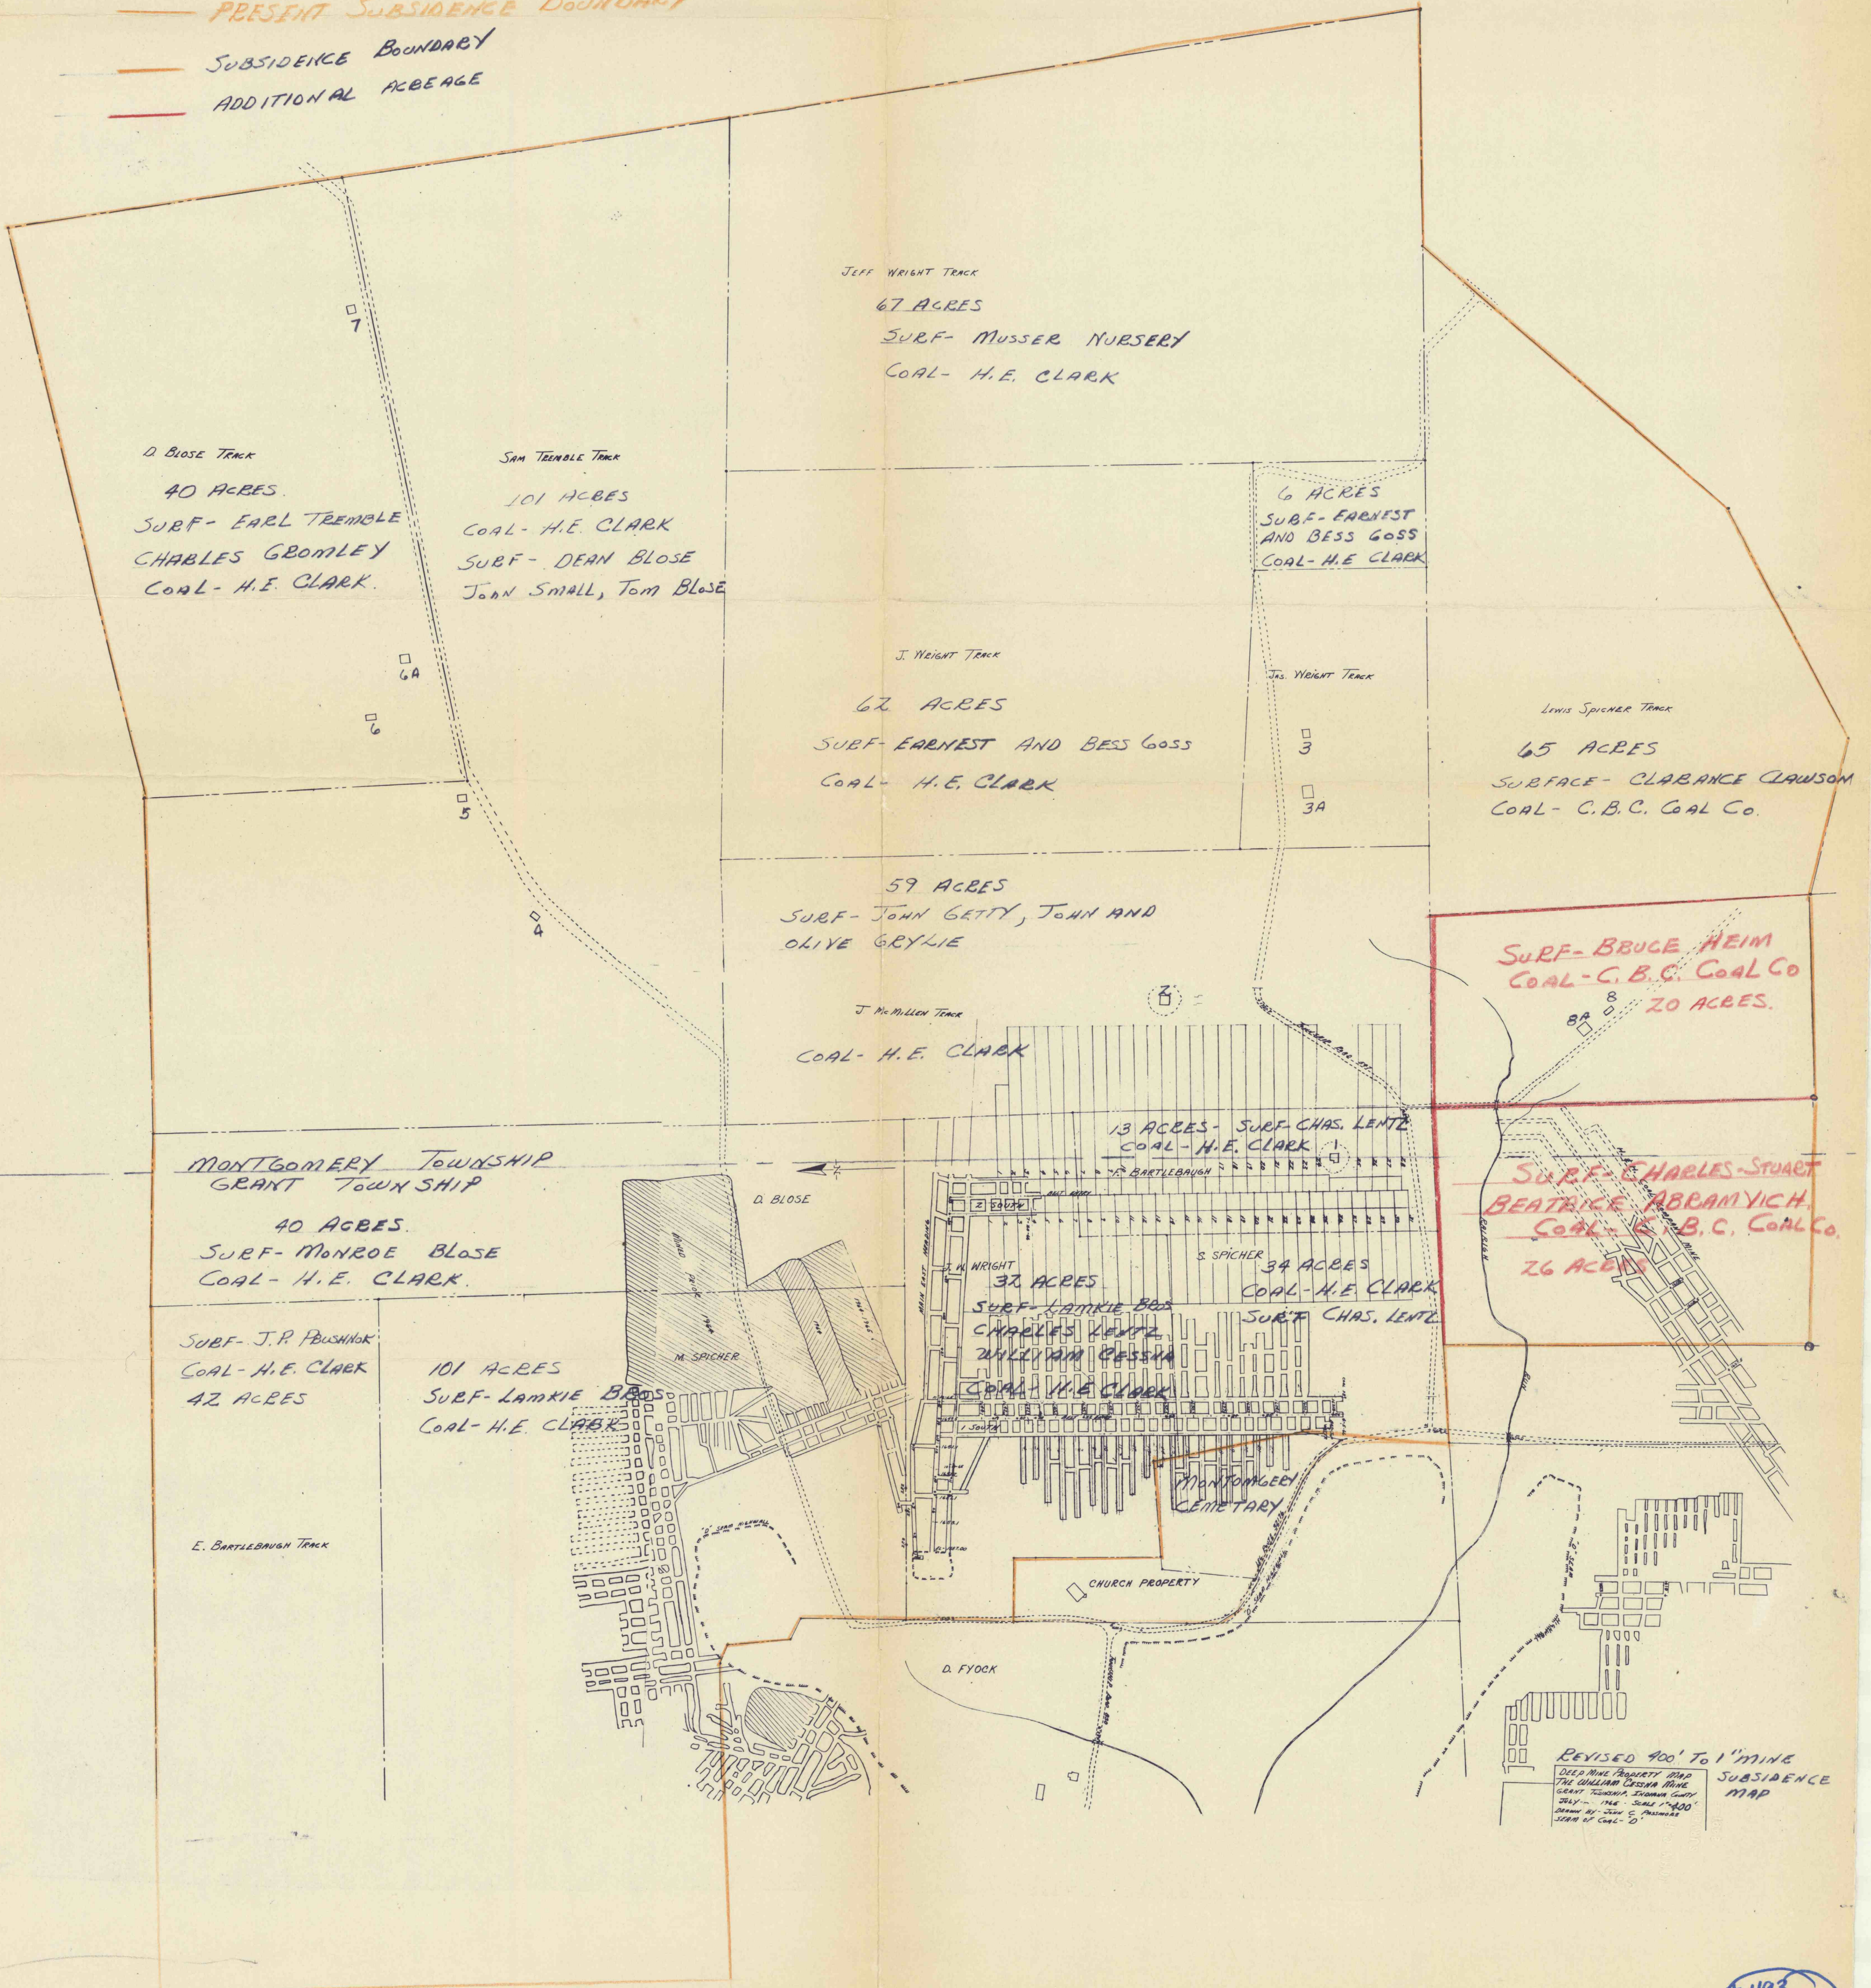

#493
6-23-99
C.C.