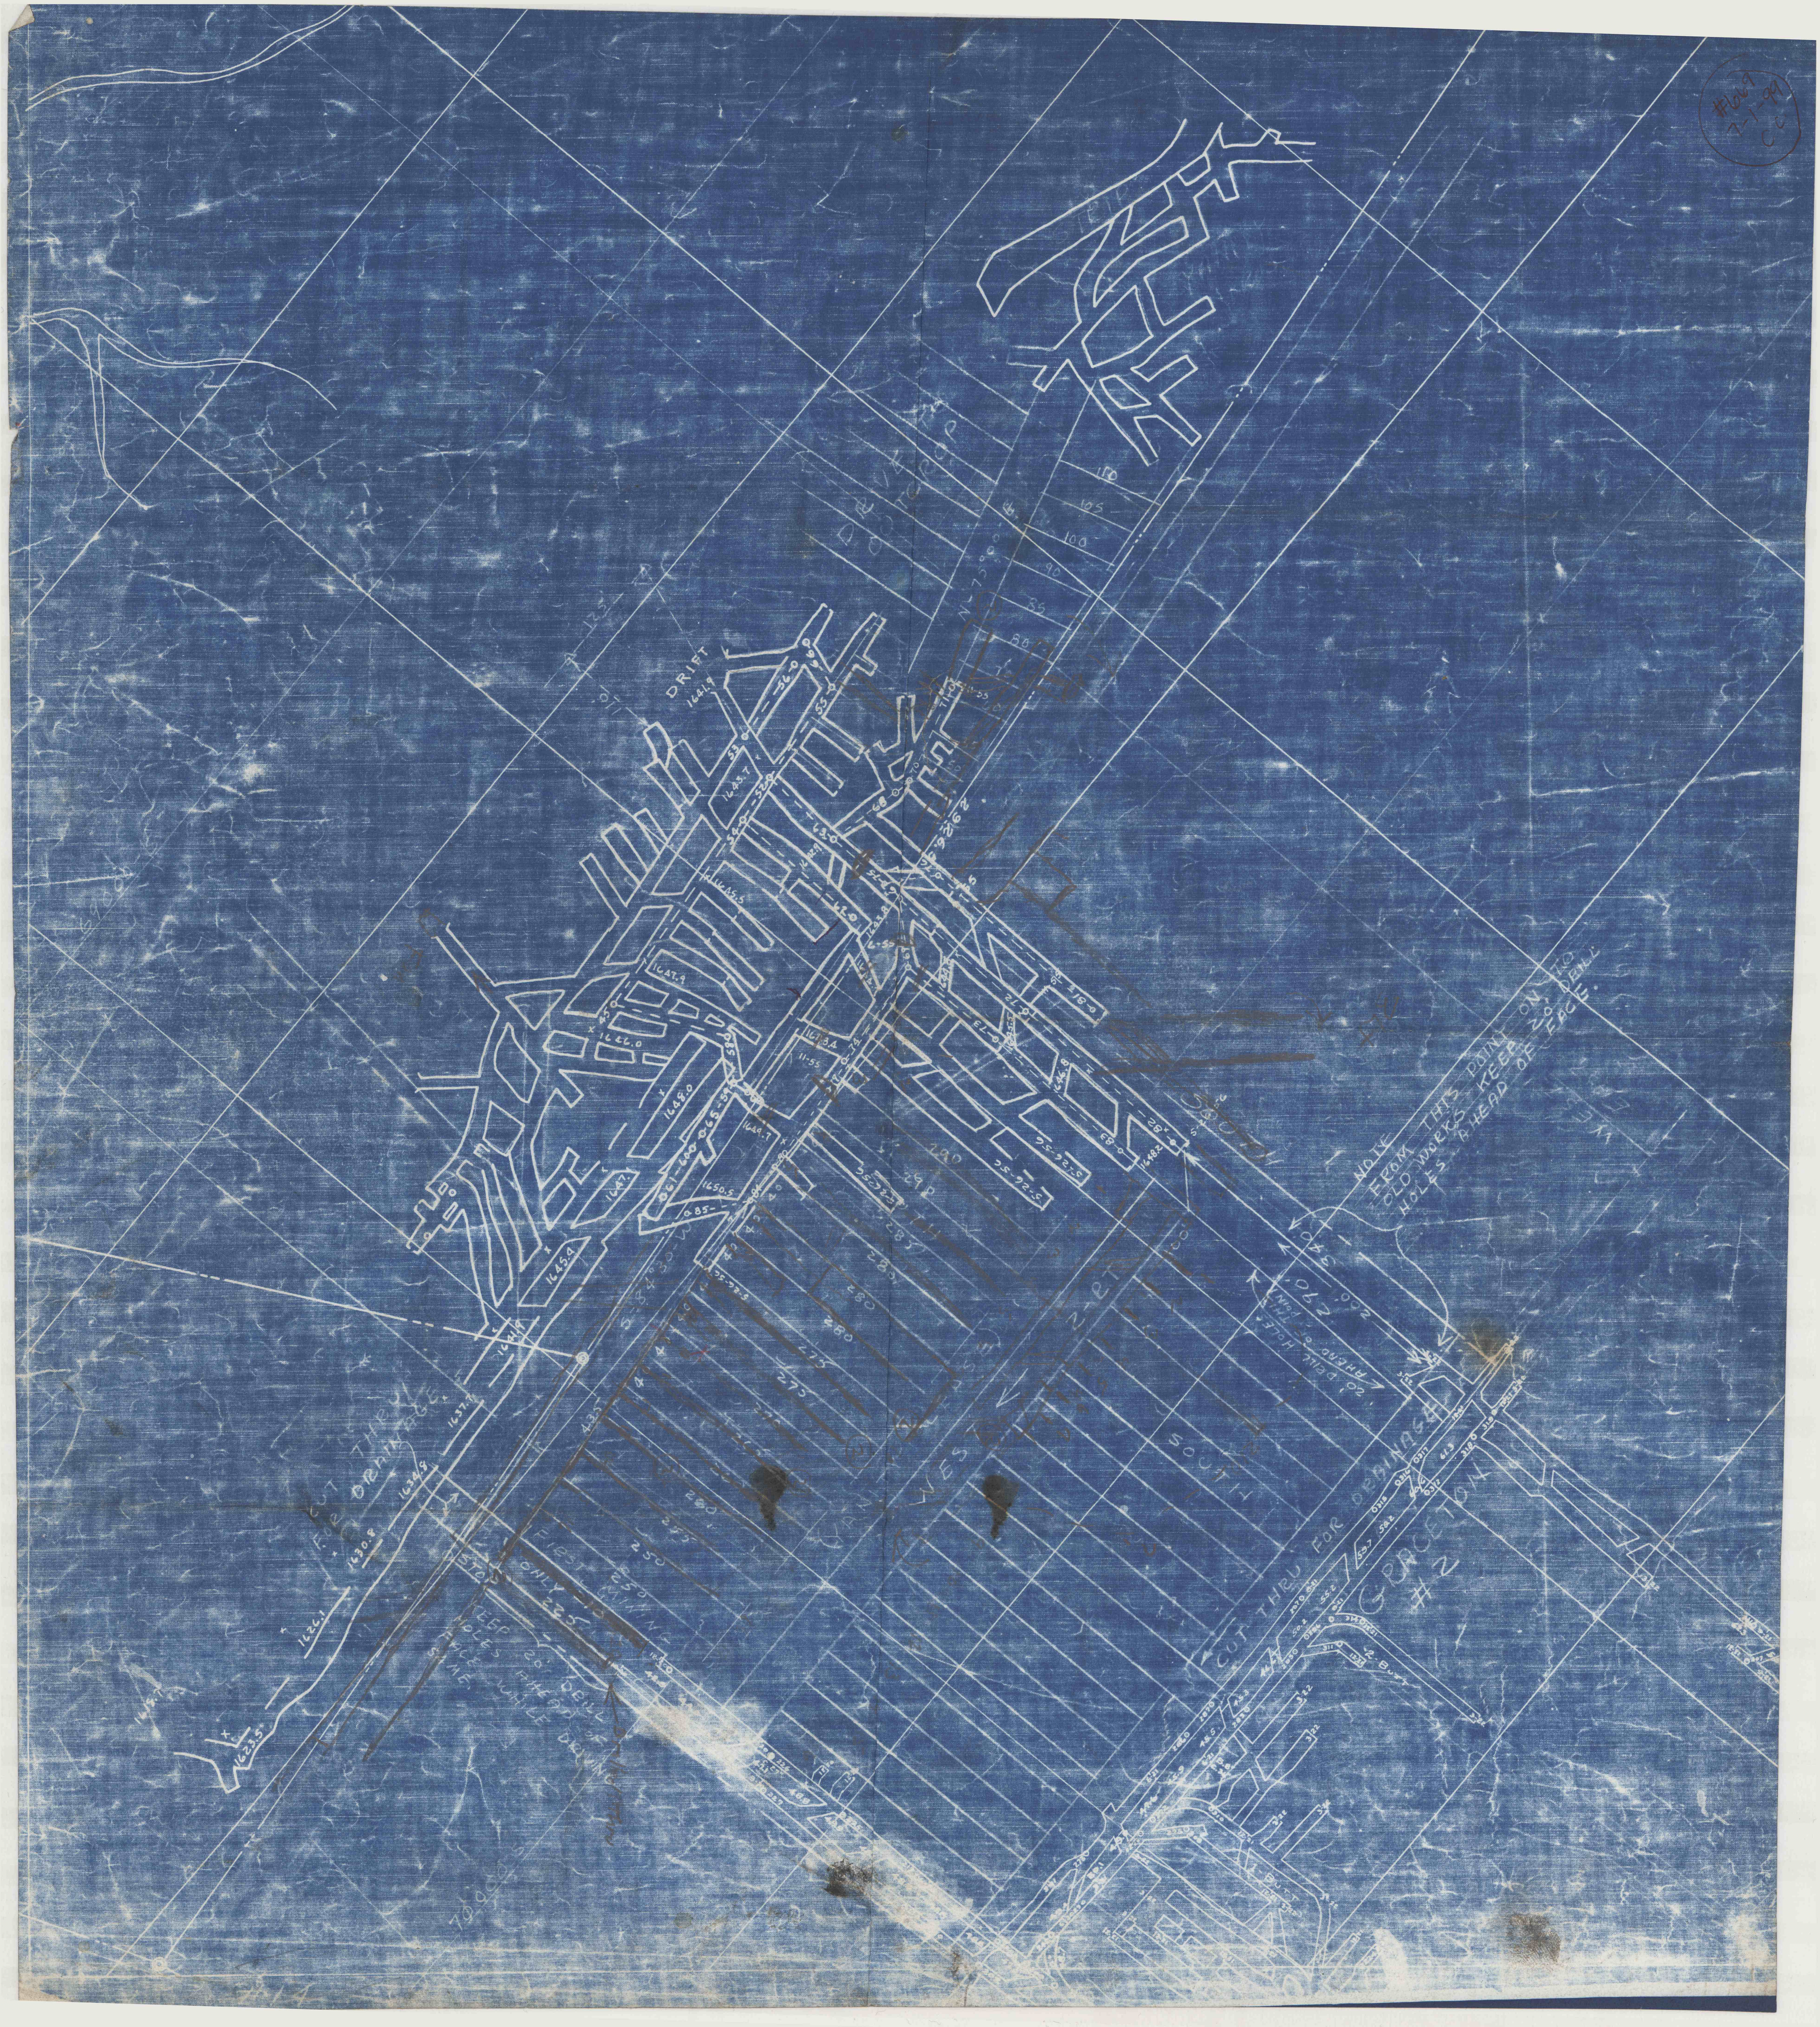
#669
7-1-99
CC
DRIFT
1641.9
NOTE
FROM THIS POINT ON TO
OLD WORKS KEEP 20' DRILL
HOLES AHEAD OF FACE
20' DRILL HOLES
AHEAD OF THIS POINT
CUT THRU FOR DRAINAGE
GRACETON
#2
2 BUTT
1 BUTT
SOUTH
CUT THRU
FOR DRAINAGE
1623.5
1626.1
1630.8
1634.8
1637.7
1641.9
1645.4
1647.9
1648.0
1649.7
1650.5