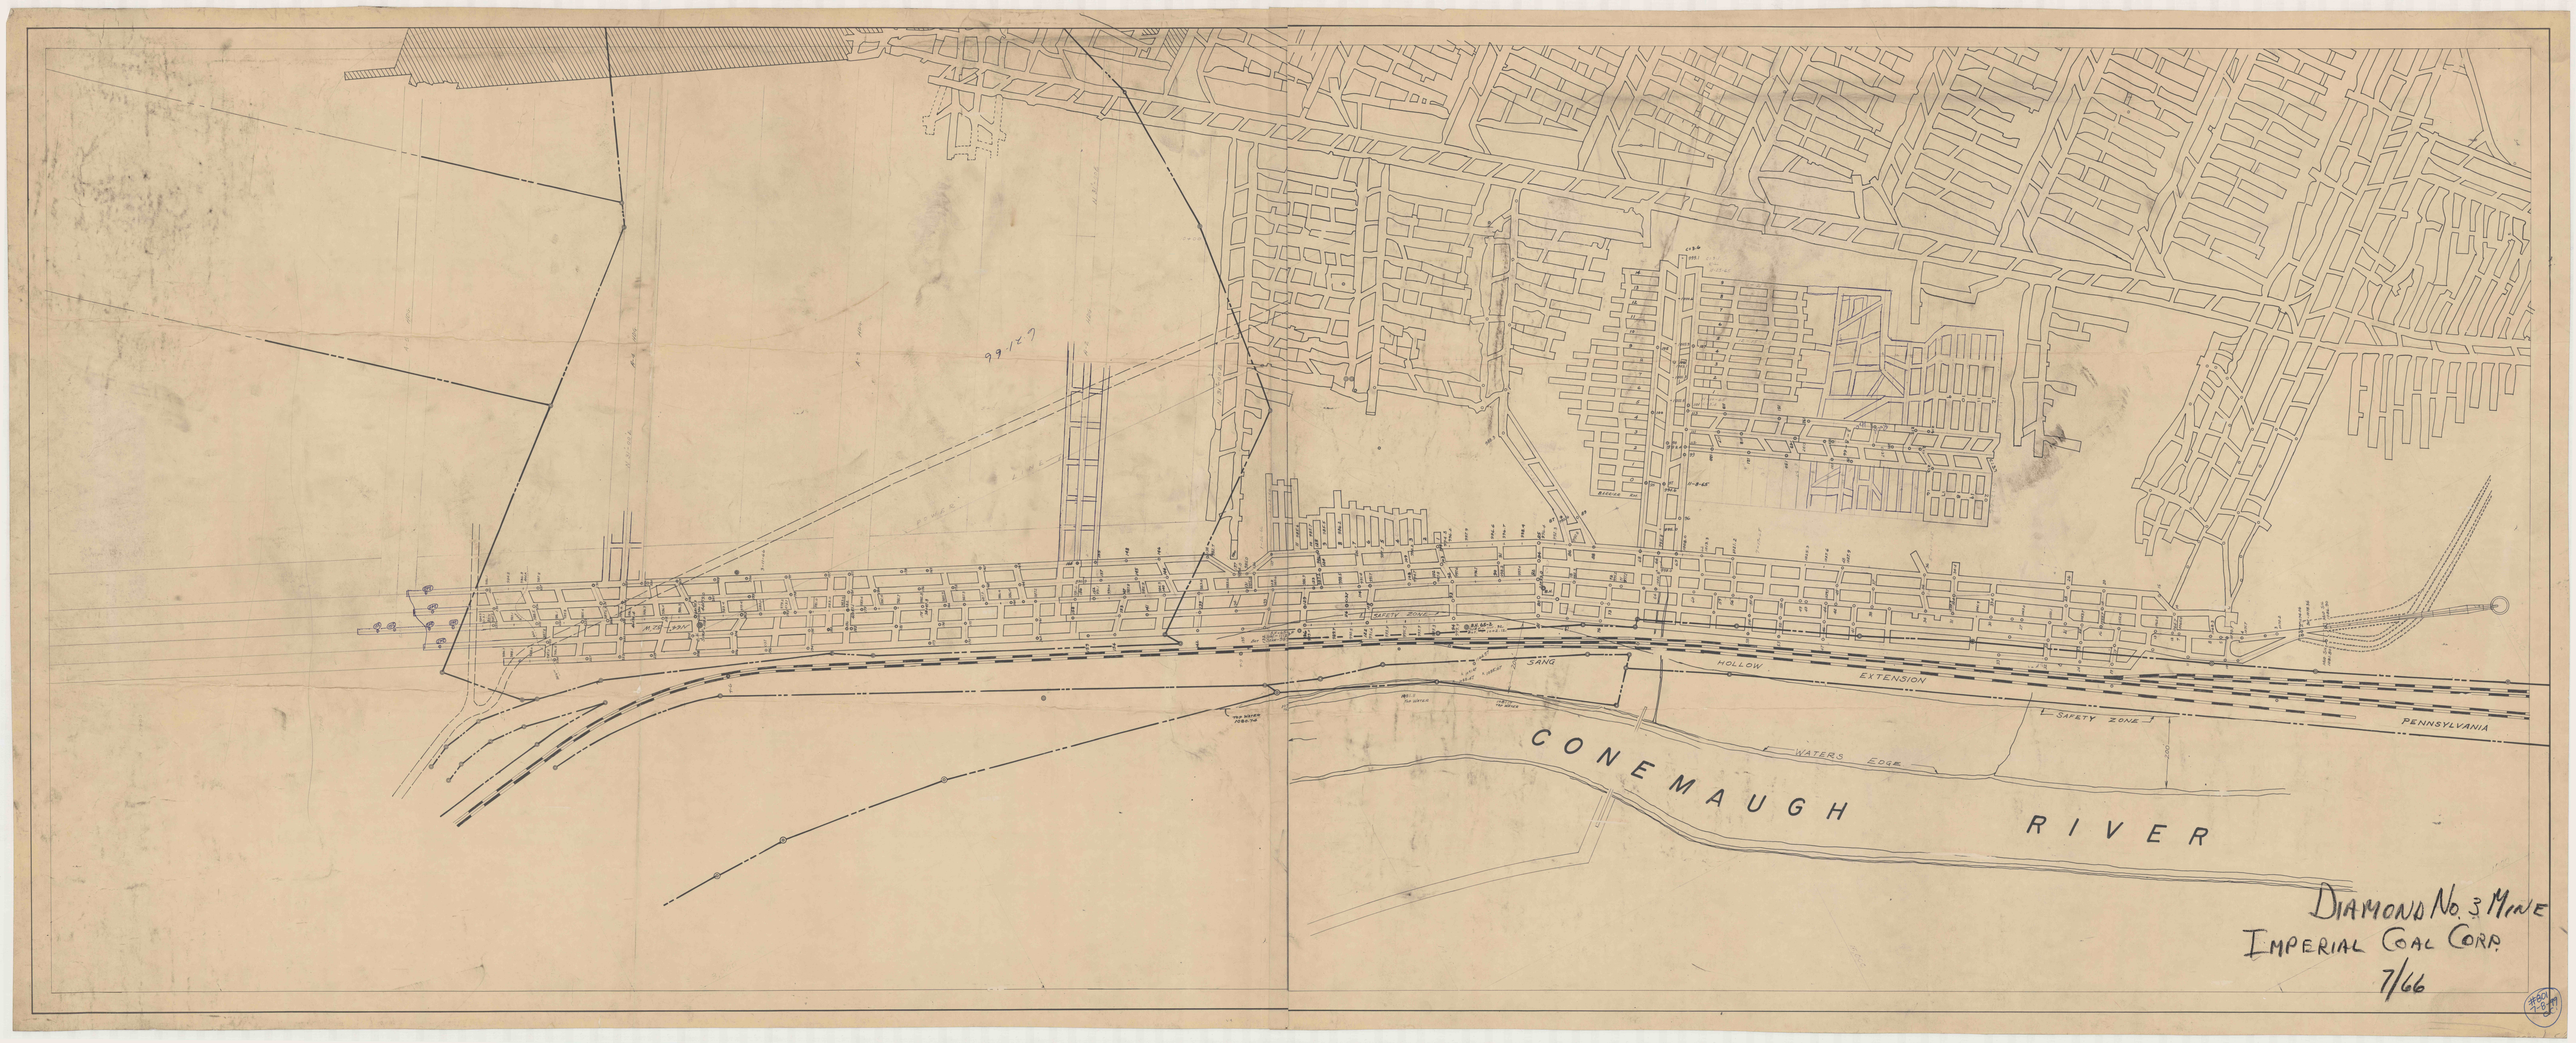
SAFETY ZONE
SANG
HOLLOW
EXTENSION
SAFETY ZONE
PENNSYLVANIA
WATERS EDGE
CONEMAUGH
RIVER
DIAMOND No. 3 MINE
IMPERIAL COAL CORP.
7/66