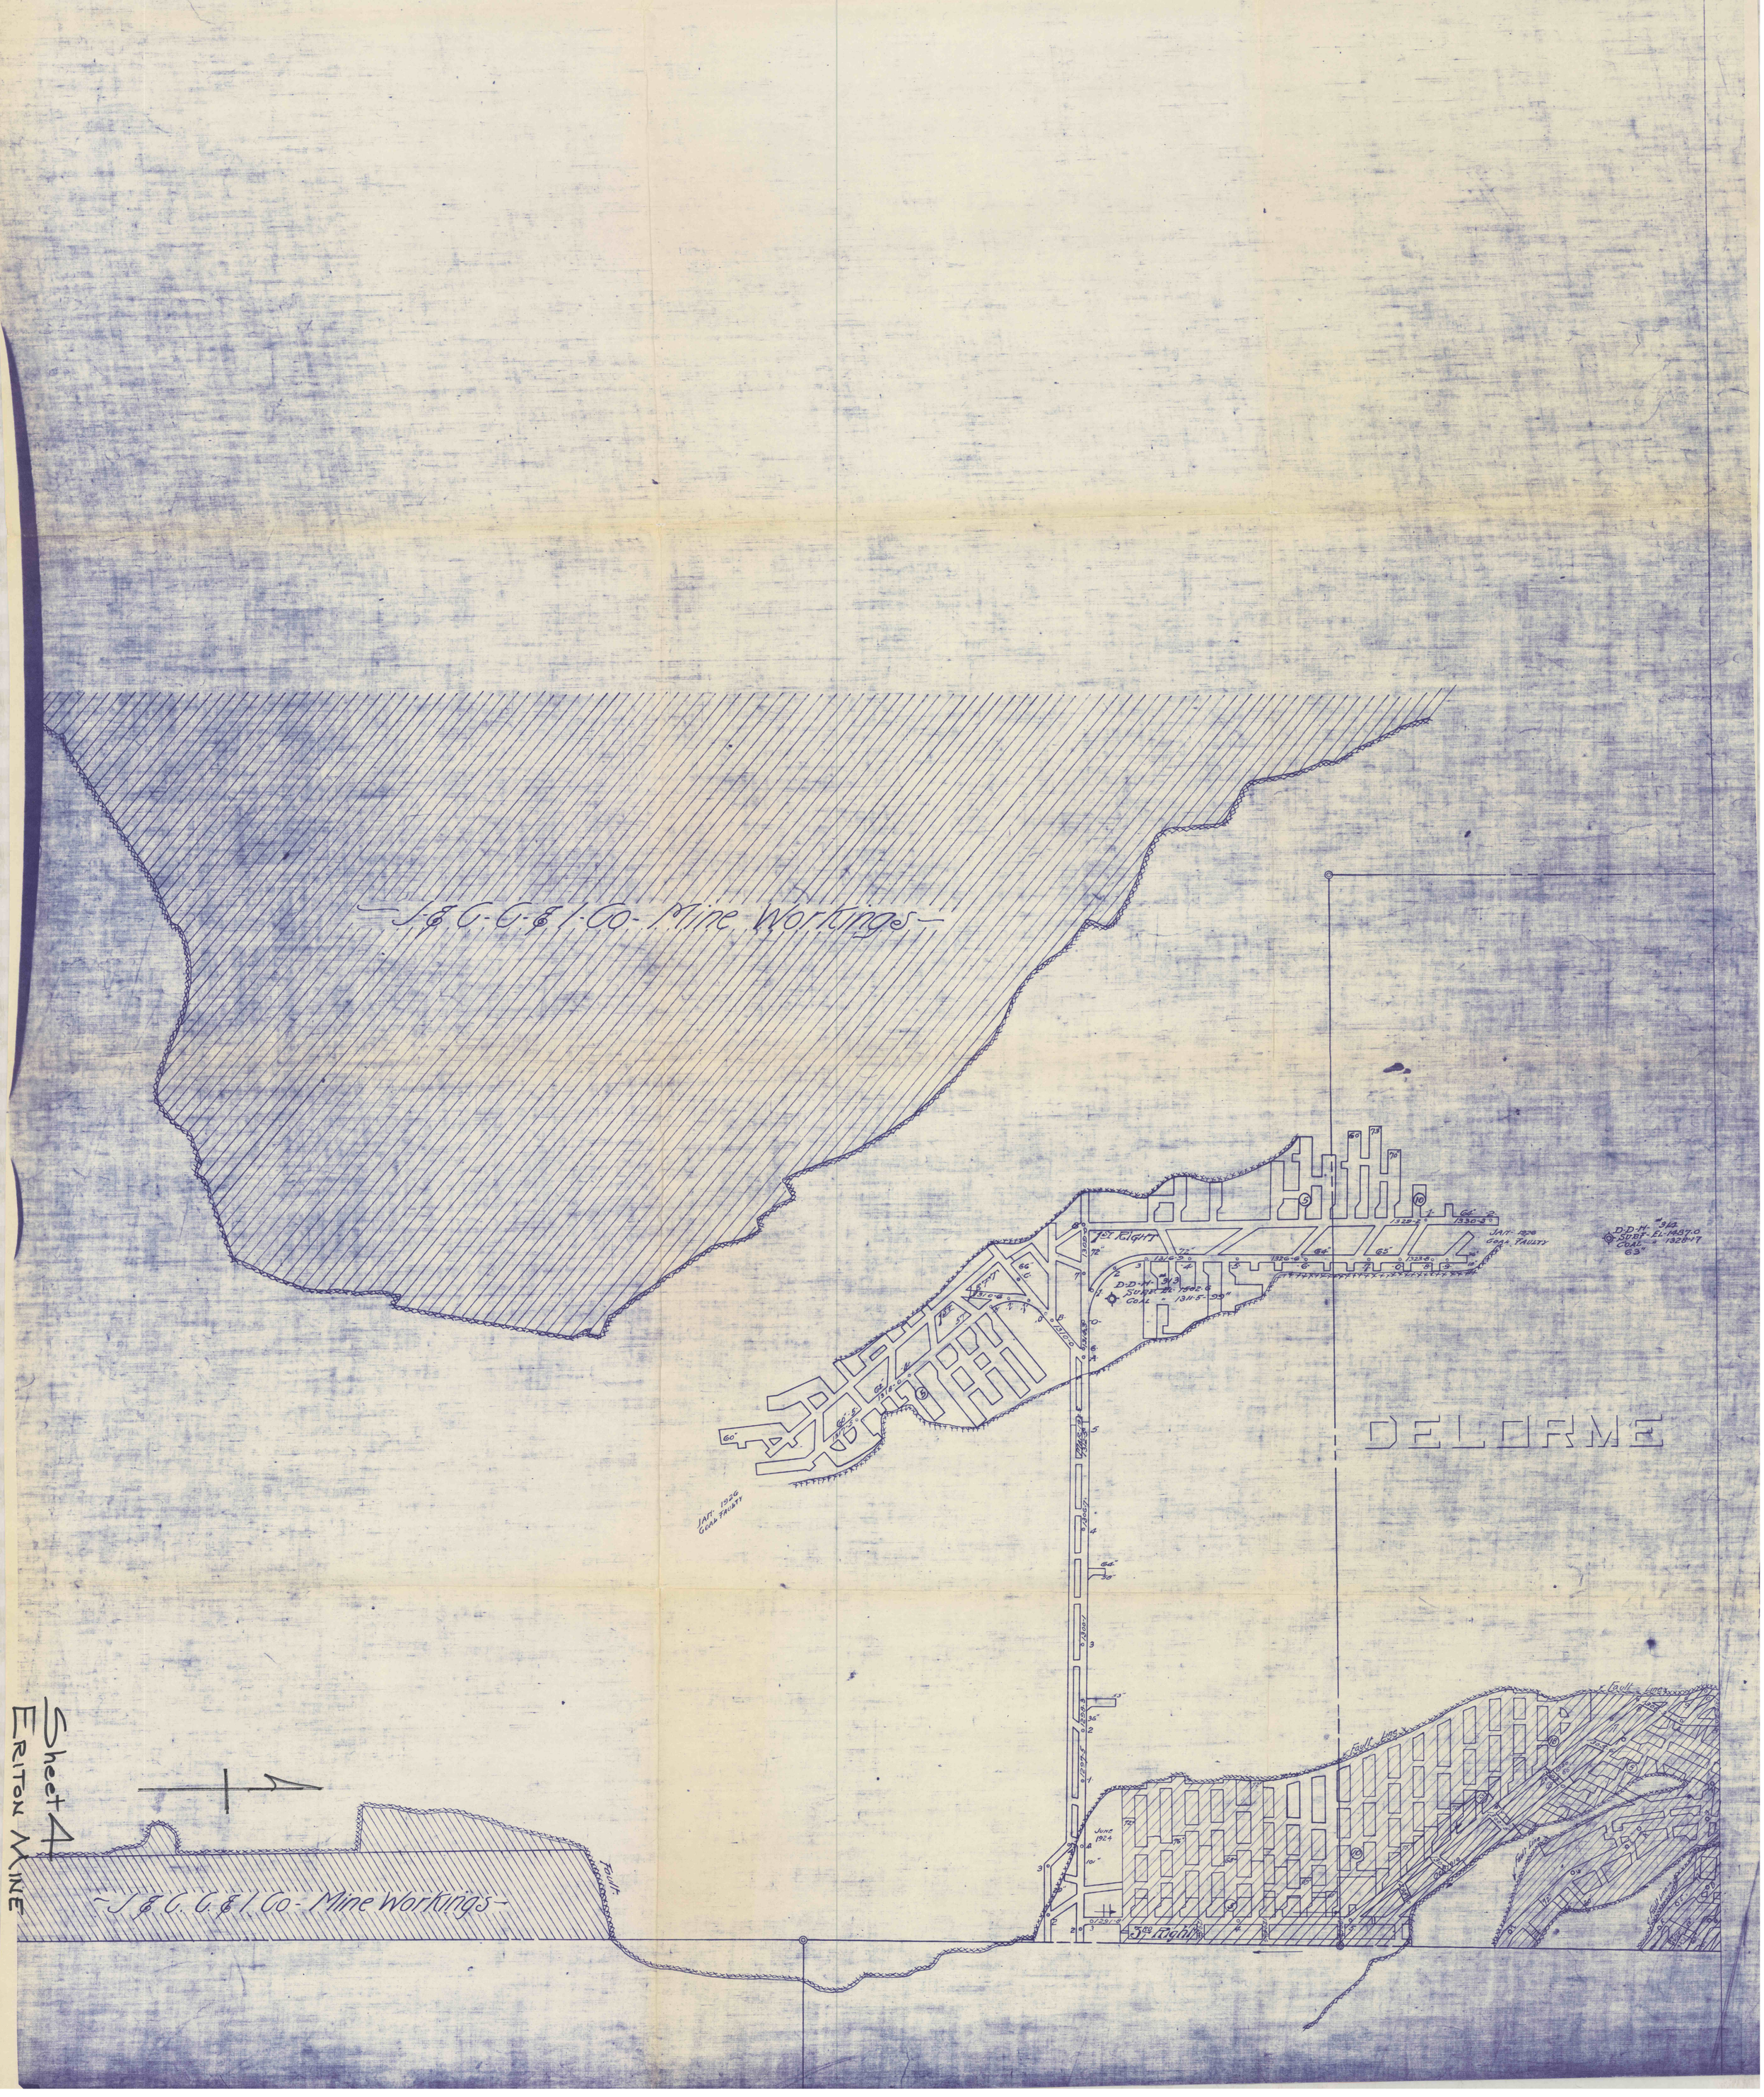
—J.&C.C.&I.Co. Mine Workings—
DELORME
Sheet 4
ERITON MINE
—J.&C.C.&I.Co.-Mine Workings—
Fault
Fault Lines
JAN. 1926 COAL FAULTY
JUNE 1924
1st Right
3rd Right