


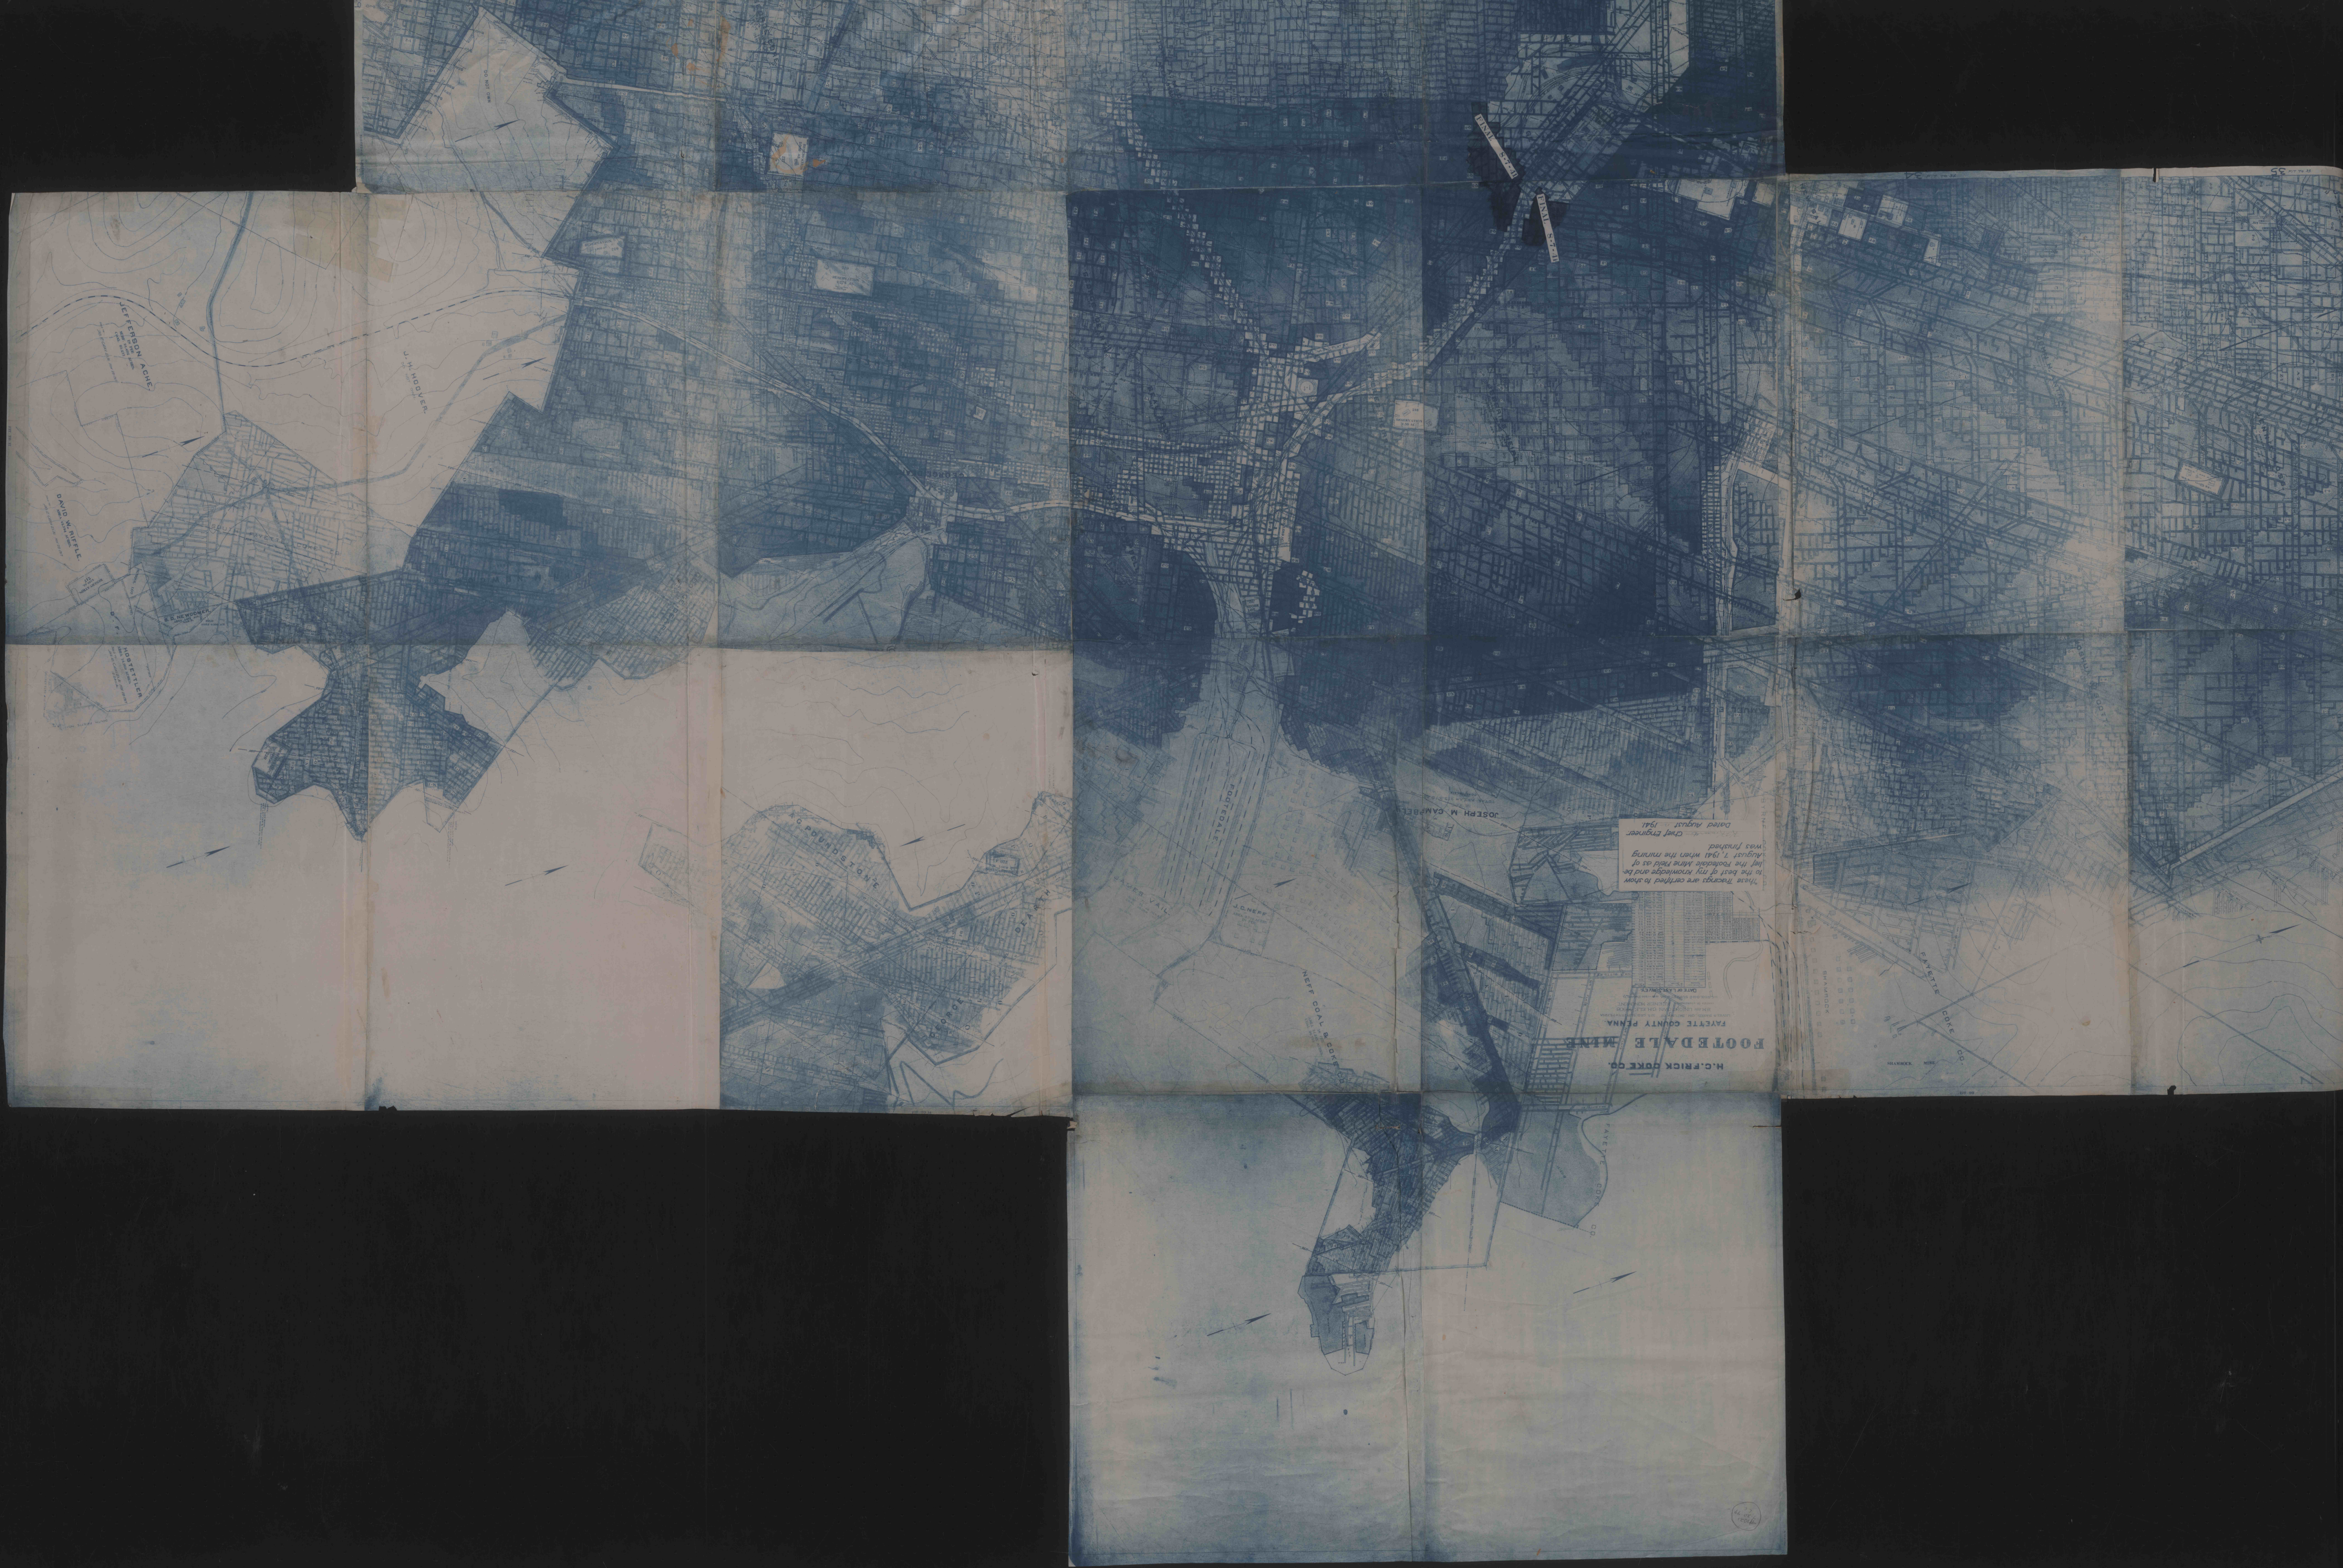

These drawings are certified to show
to the best of my knowledge and be-
August 1, 1941, with the mining
was finished.
Chief Engineer
Dated August 1, 1941

H.C. FRICK COKE CO.
FAYETTE COUNTY PENNA.

JOSEPH M. CAMPBELL

NEFF COAL & ICE CO.

J. C. NEFF


GRANDSTONE

J. H. HUGHES

JEFFERSON ACADE

DAVID M. HENRIET