


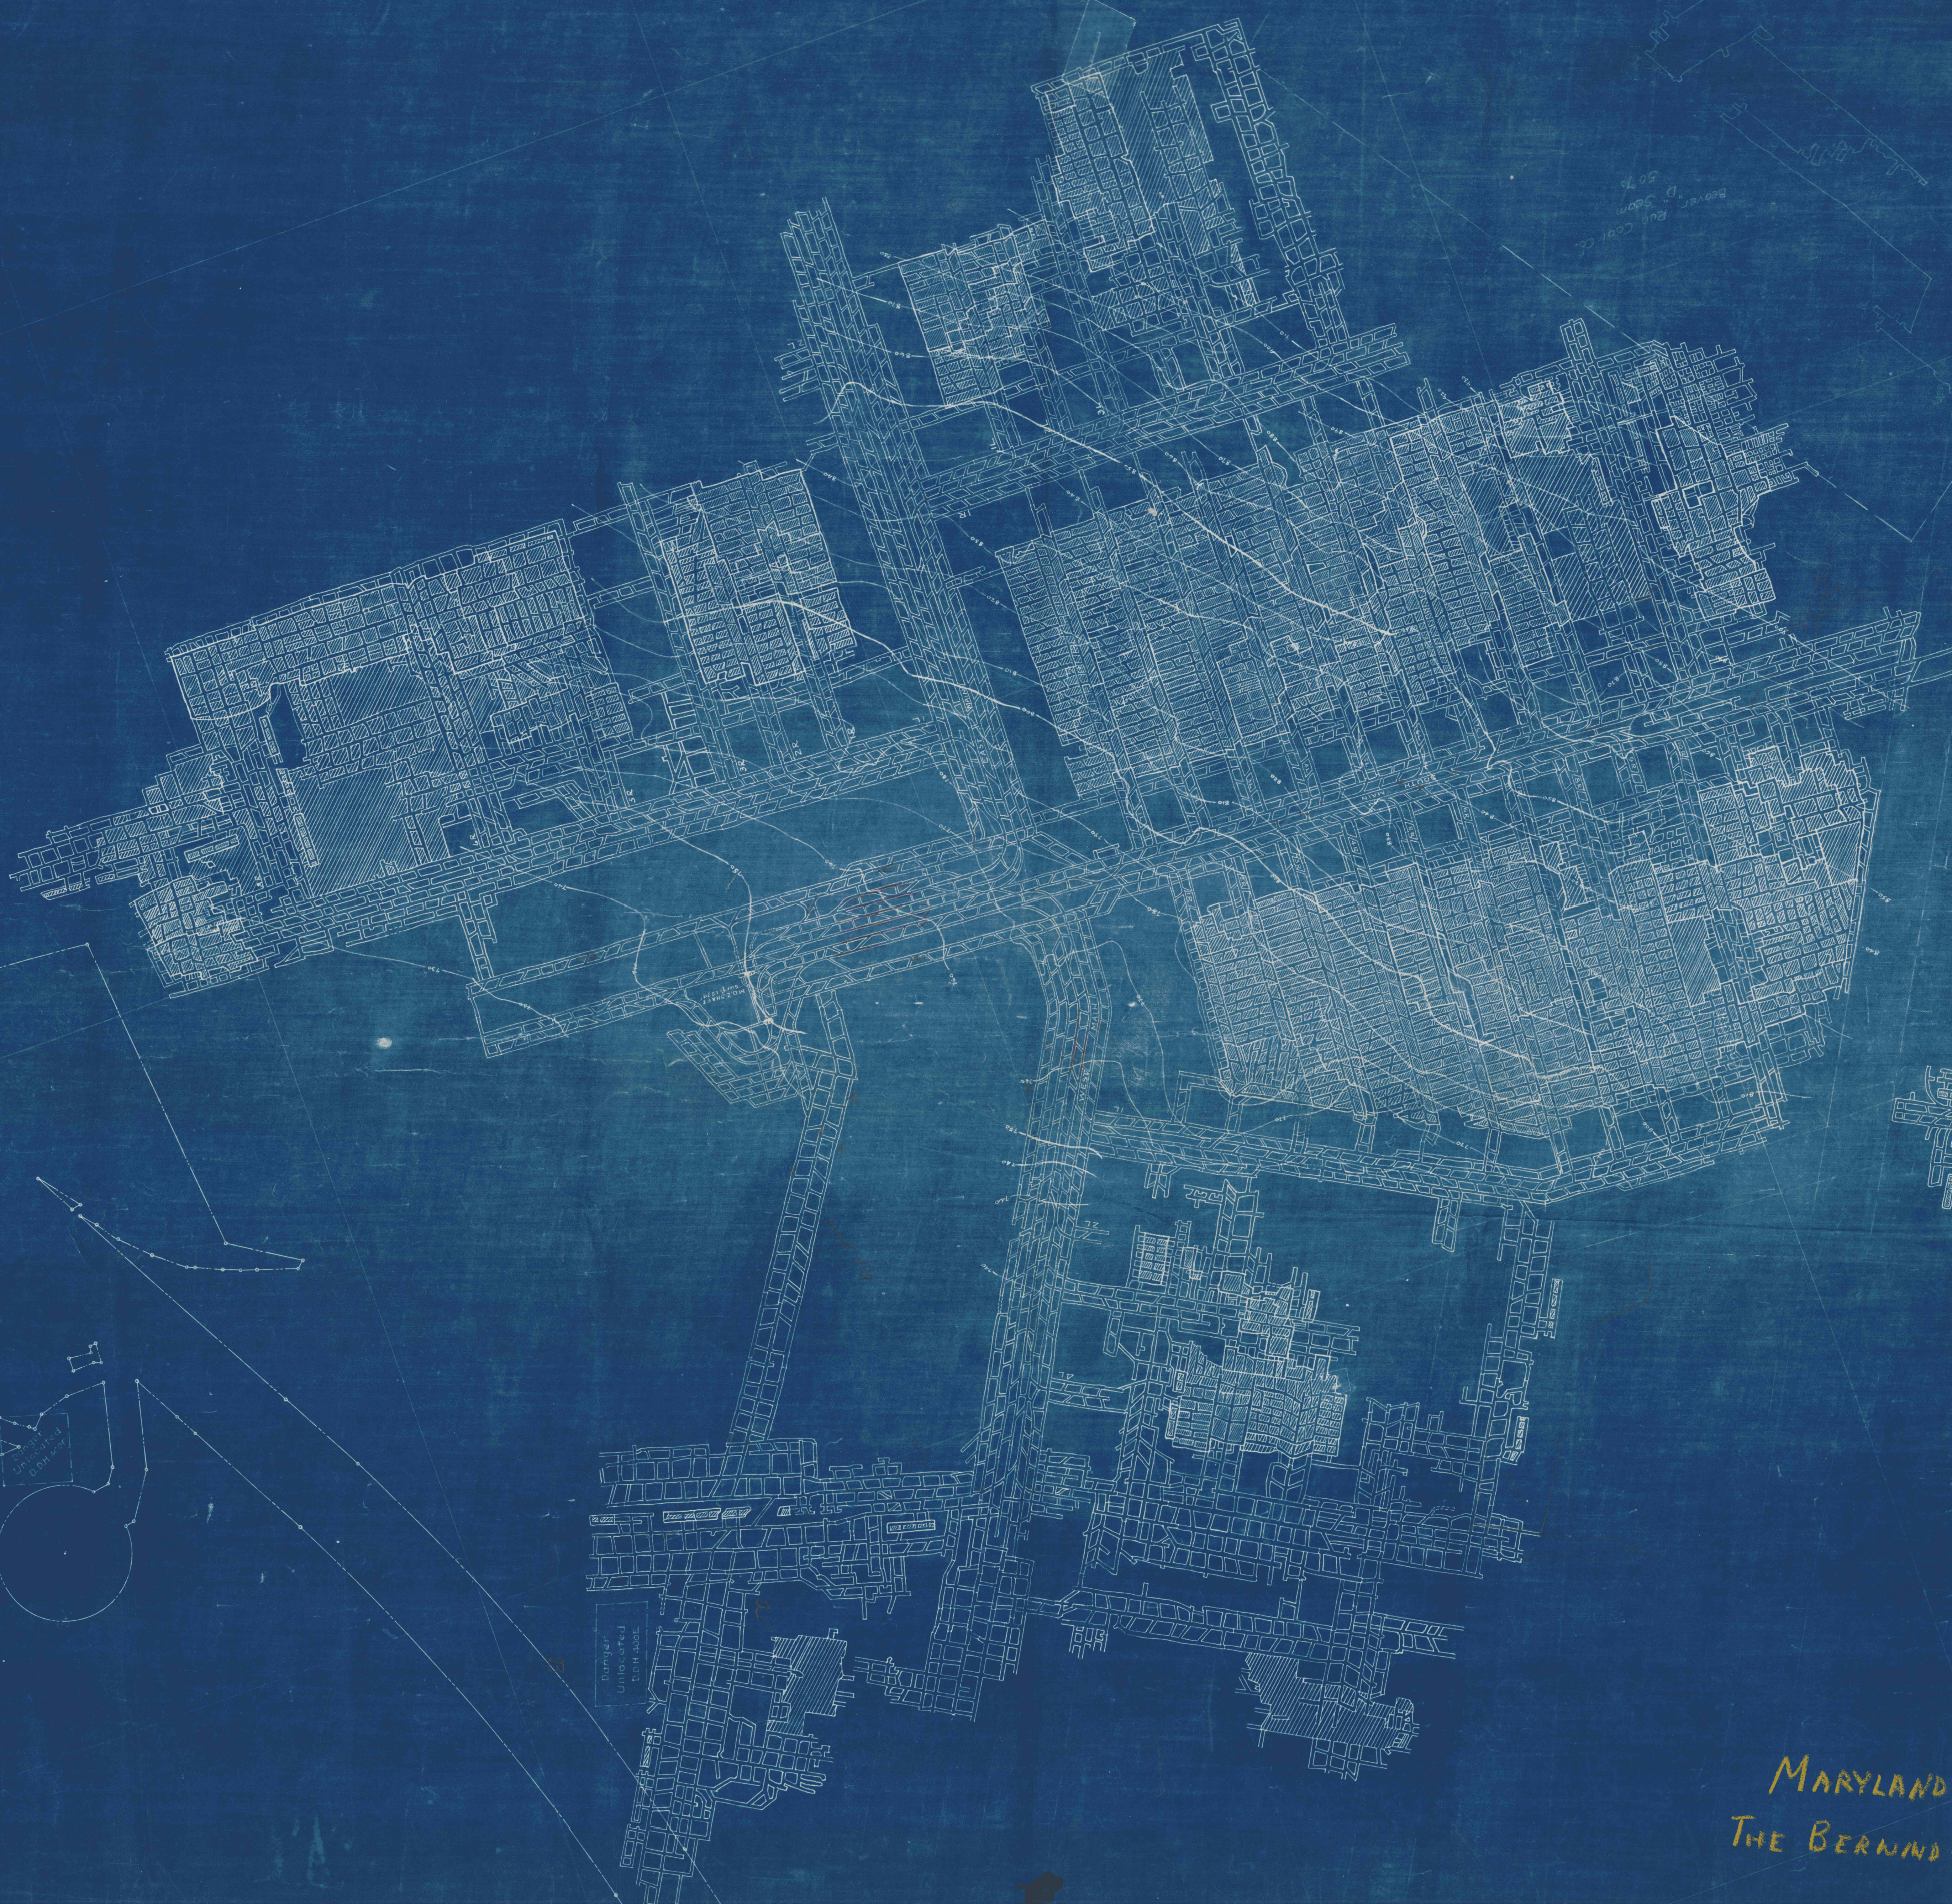

MARYLAND No. 2.

DANGER

Beaver Run Coal Co.
D. 500 ft.
50 ft.

