
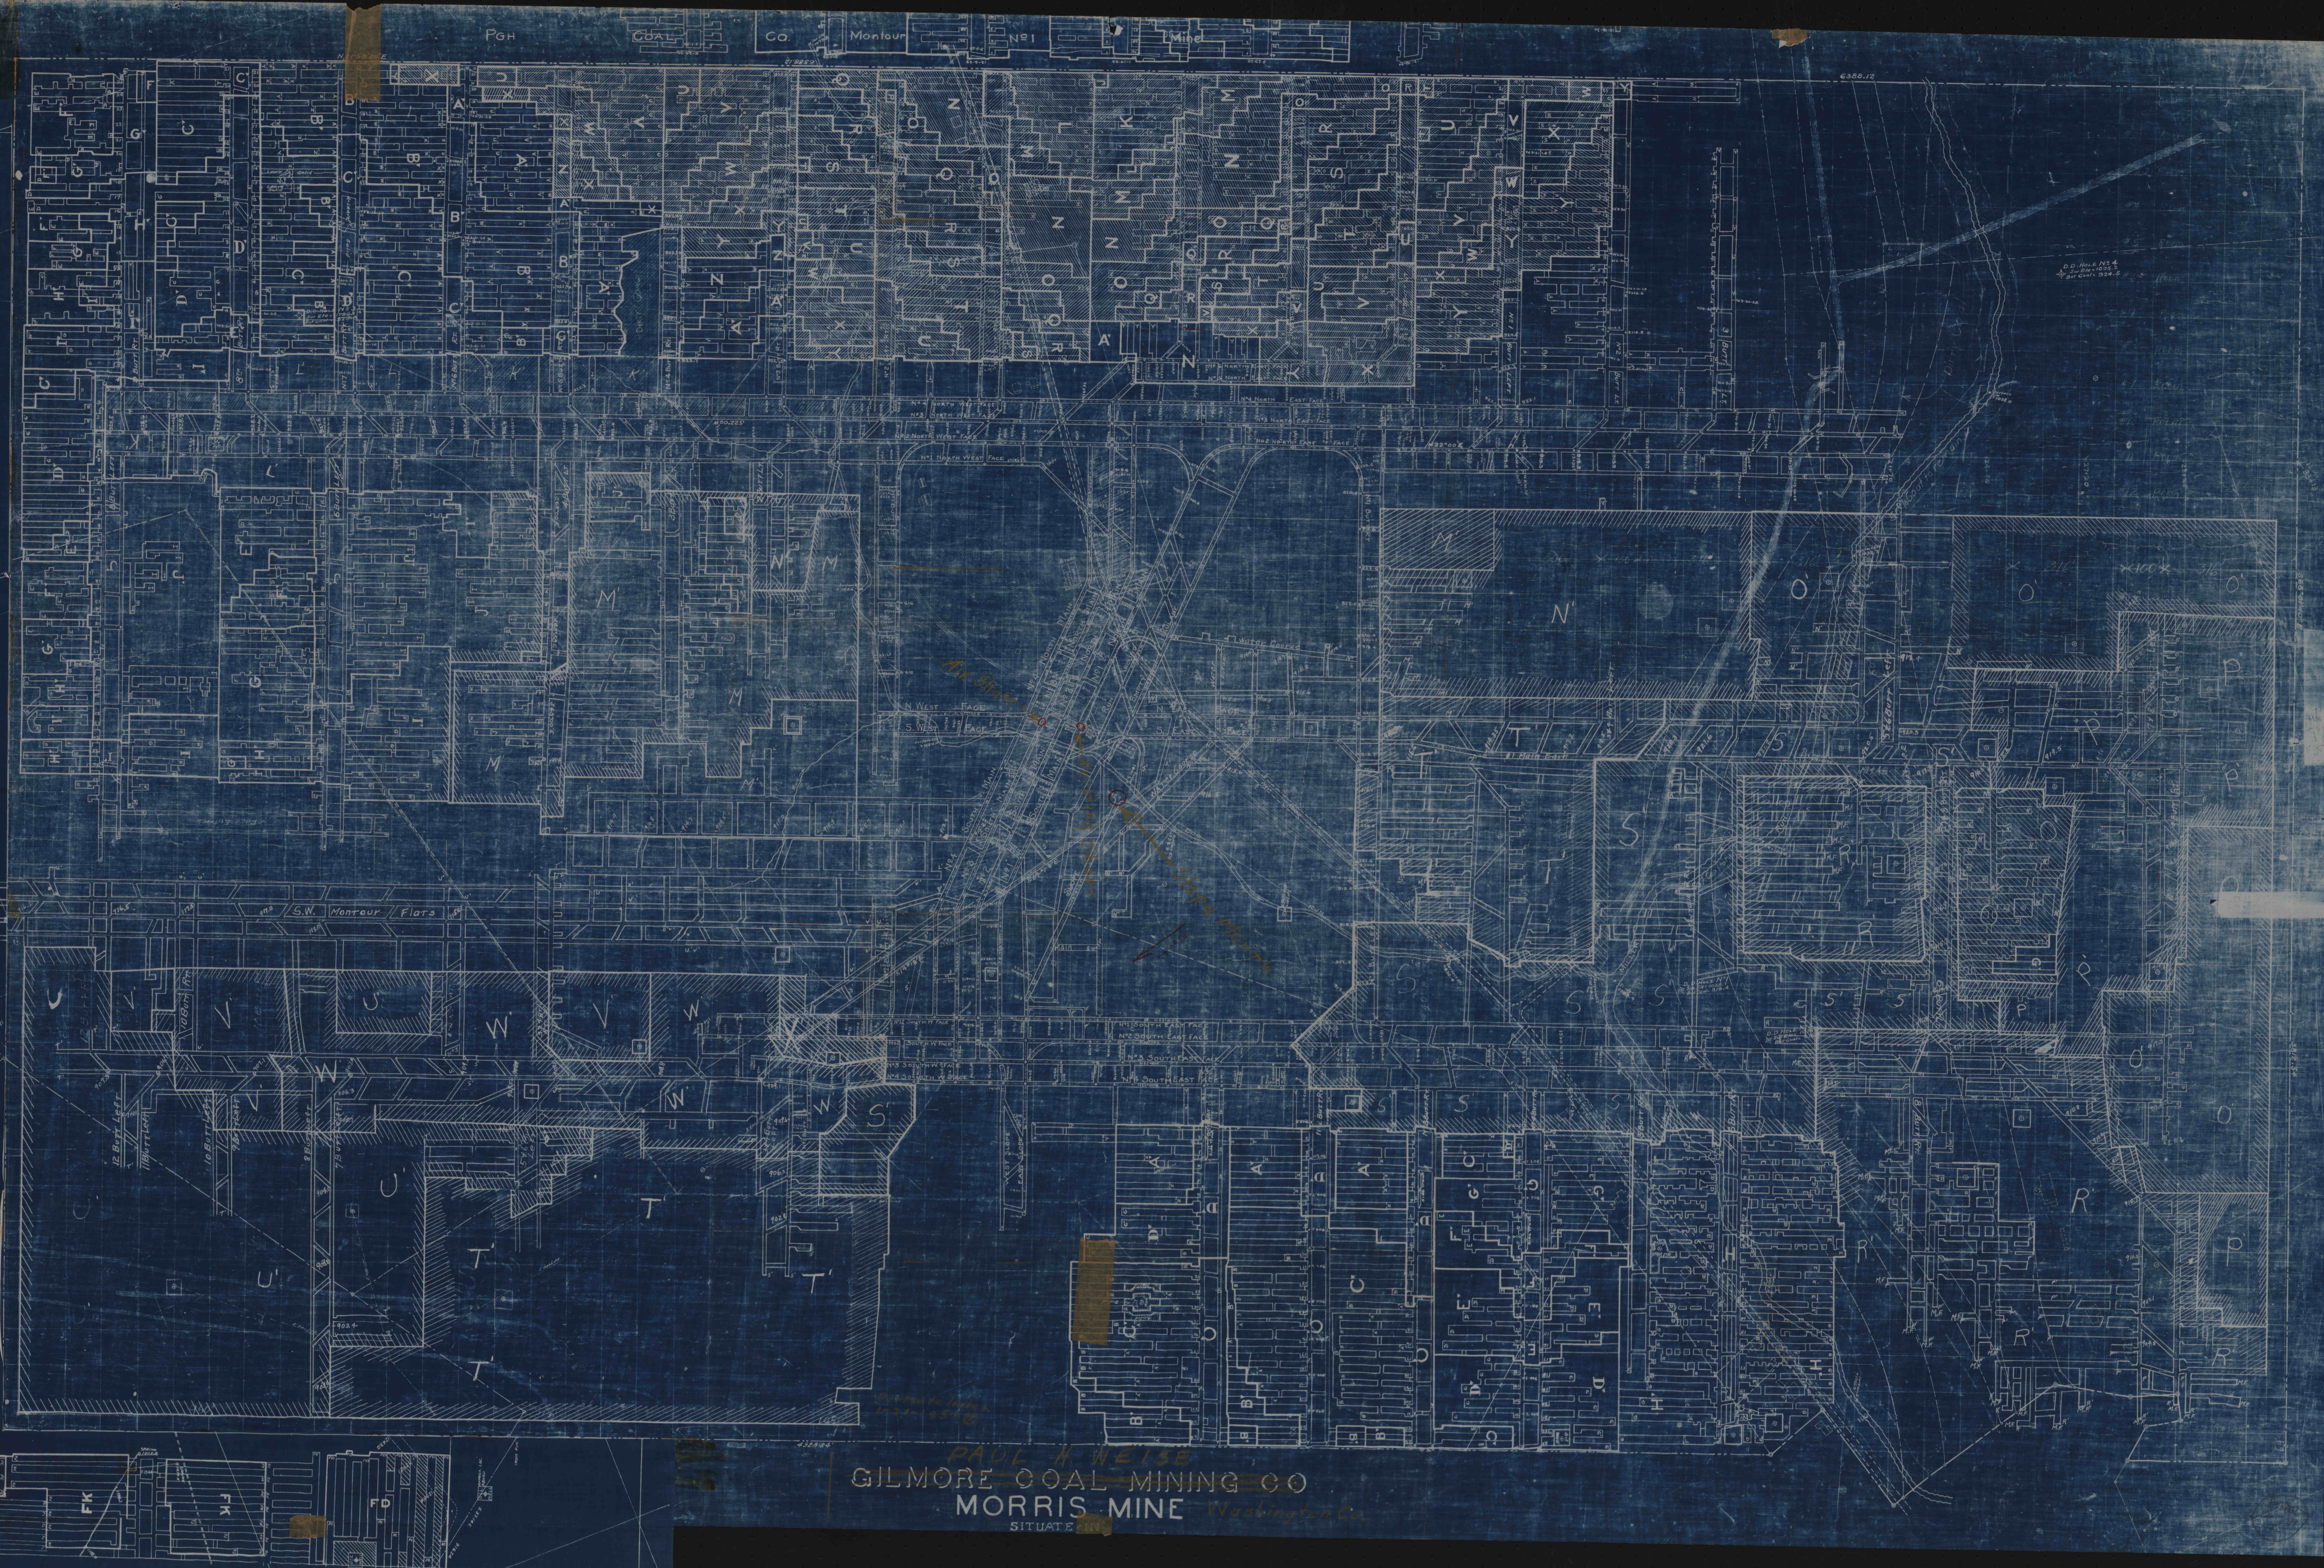


FT to K-53

Area to be mined  
1957, 1958, 1959, 1960

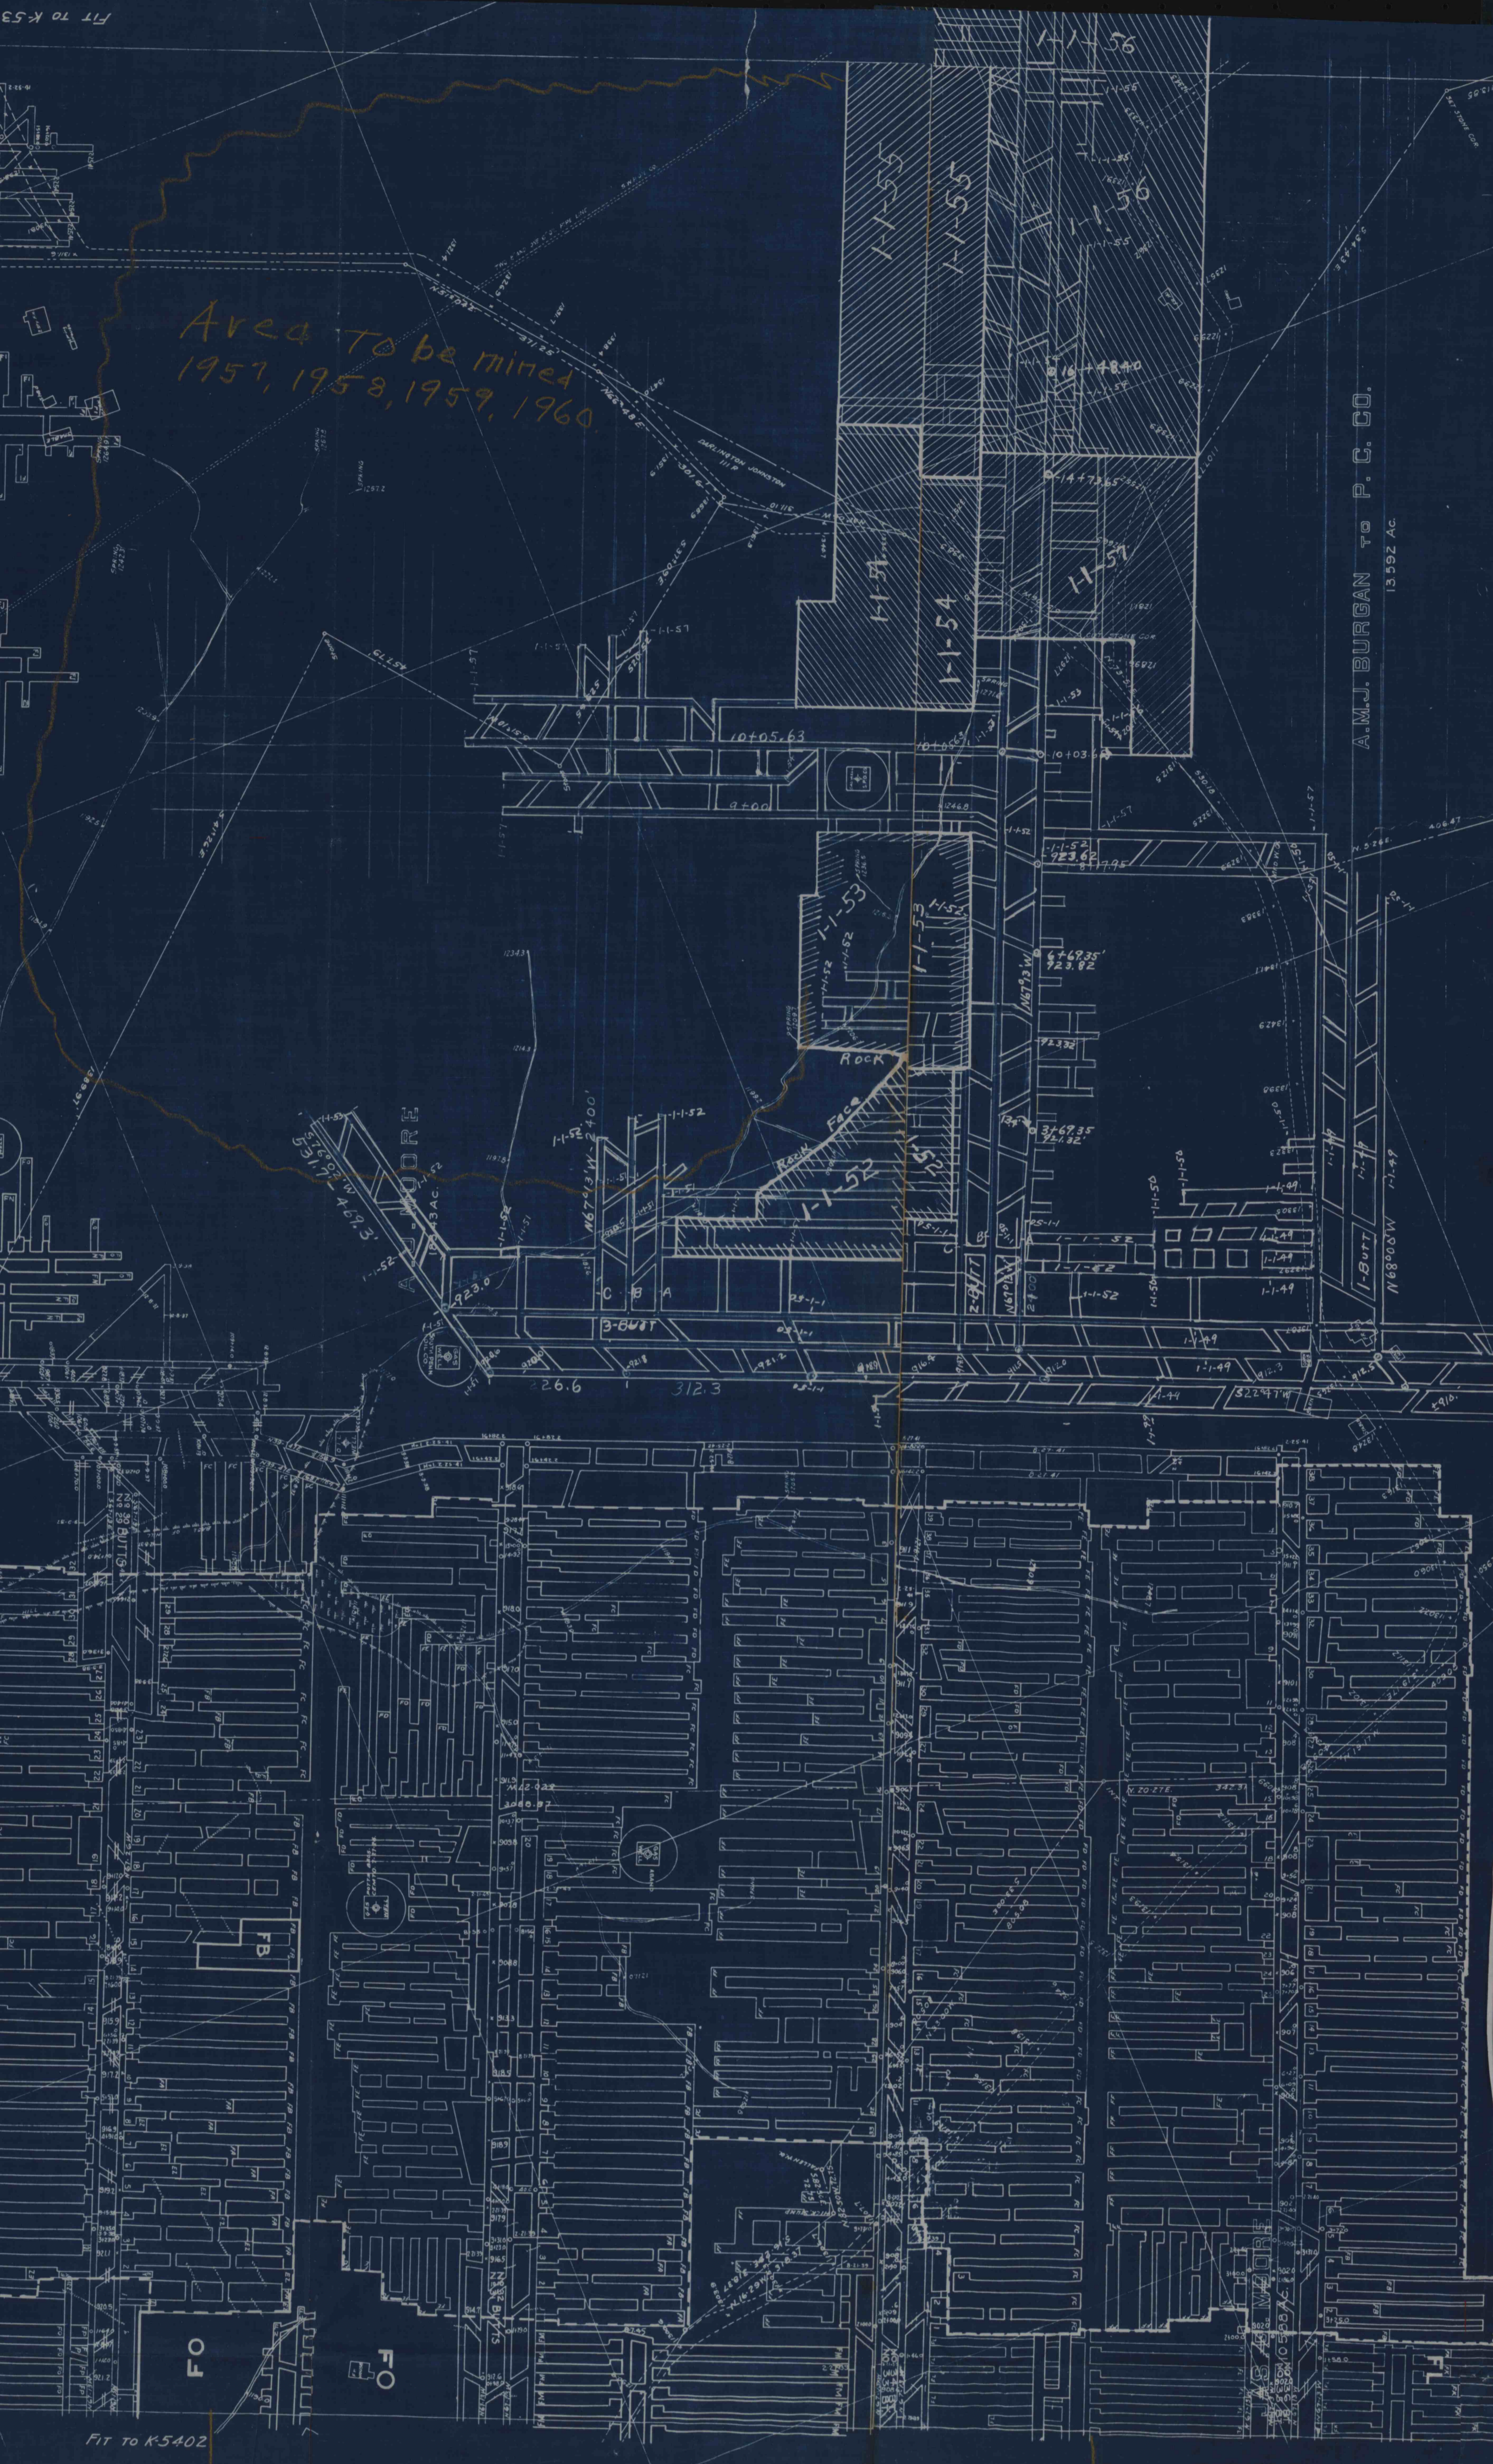

PAUL H. WEISE  
 GILMORE COAL MINING CO  
 MORRIS MINE  
 SITUATION

FT to K-5402

FT to K-5501