

*Handwritten note:* This copy





**CALY 1101**  
**SURVEY EXTENDED TO**

DATE	BY	REMARKS
DEC 18 1922		
DEC 2 1923		
DEC 6 1924		
DEC 30 1925		

AREA WORKED OUT FROM 11-466 TO 12-306

CONTINGENT MINING 7-15-27 TO 3-19-28

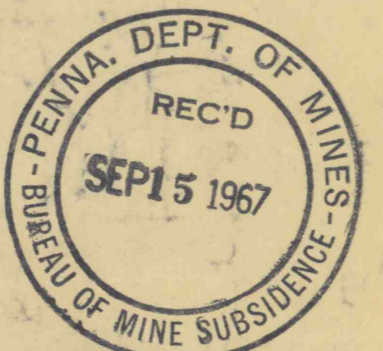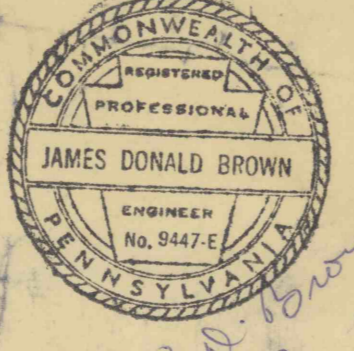

42000  
29 191