


ALLEGHENY RIVER MINING Co

SEMINOLE MINES

ARMSTRONG CO~

Upper Freeport Seam

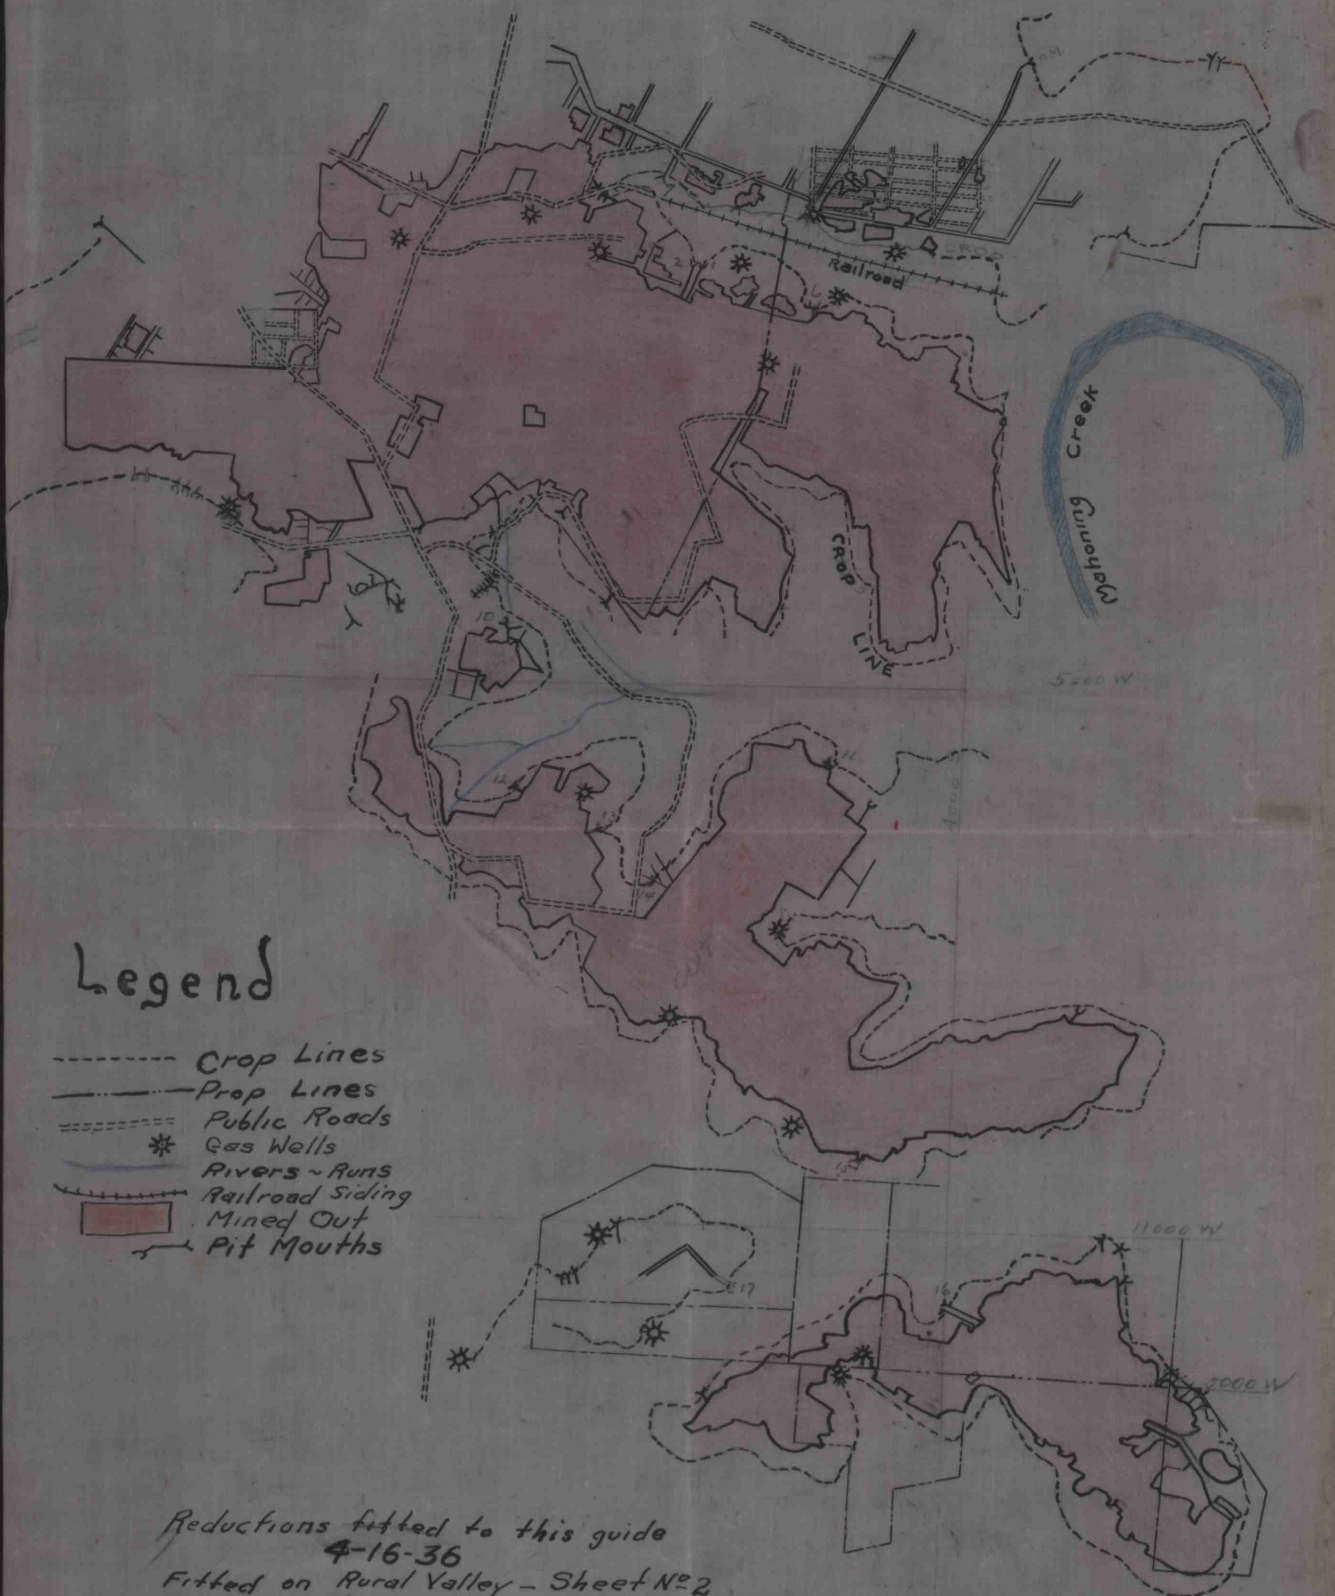


Legend

- Crop Lines
- Prop Lines
- Public Roads
- * Gas Wells
- Rivers ~ Runs
- Railroad Siding
- Mined Out
- ↘ Pit Mouths

Reductions fitted to this guide
 4-16-36
 Fitted on Rural Valley - Sheet No 2
 4-17-36

FSM

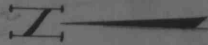

Handwritten notes:

