


Lower Kittanning seam only
 Coal acreage about 500 acres
 in fee
 Land in fee 183 acres, assessed \$3470.

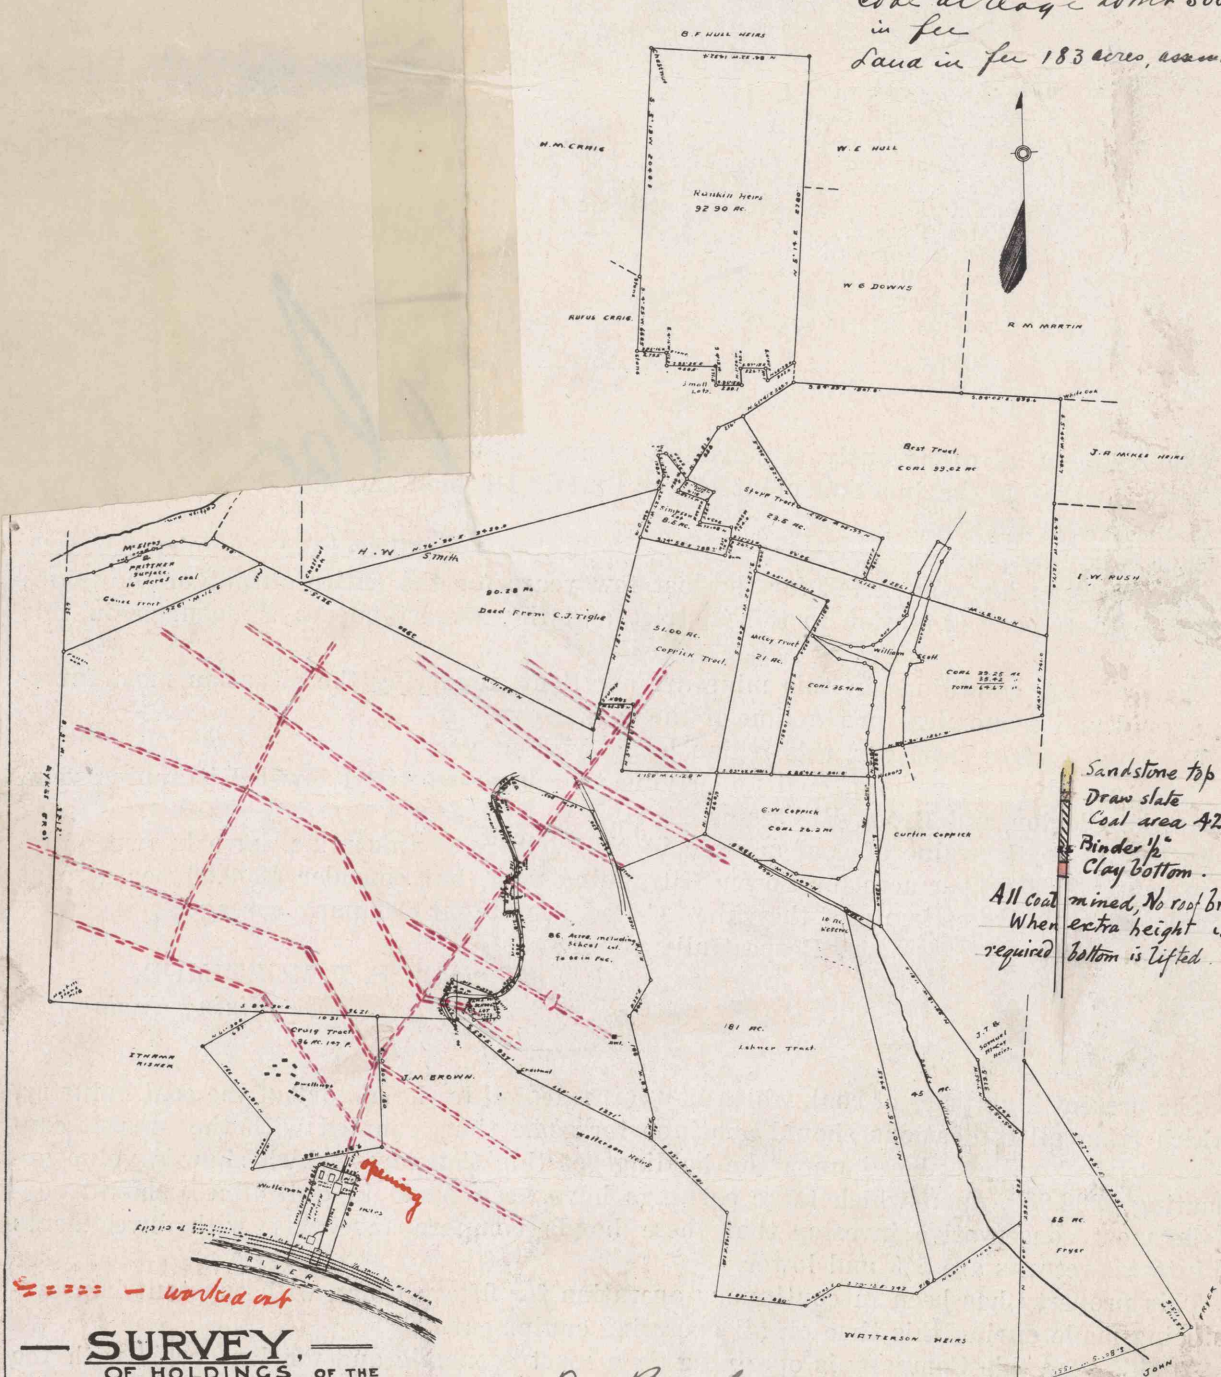

Sandstone top
 Draw slate
 Coal area 42"
 Binder 1/2"
 Clay bottom.
 All coal mined, No roof broken
 When extra height is
 required bottom is lifted.

----- worked out

SURVEY
 OF HOLDINGS OF THE
RED BANK COAL CO. at Red Bank.
 (INCORPORATED.)
 Clarion County - Pennsylvania

Madison Township.