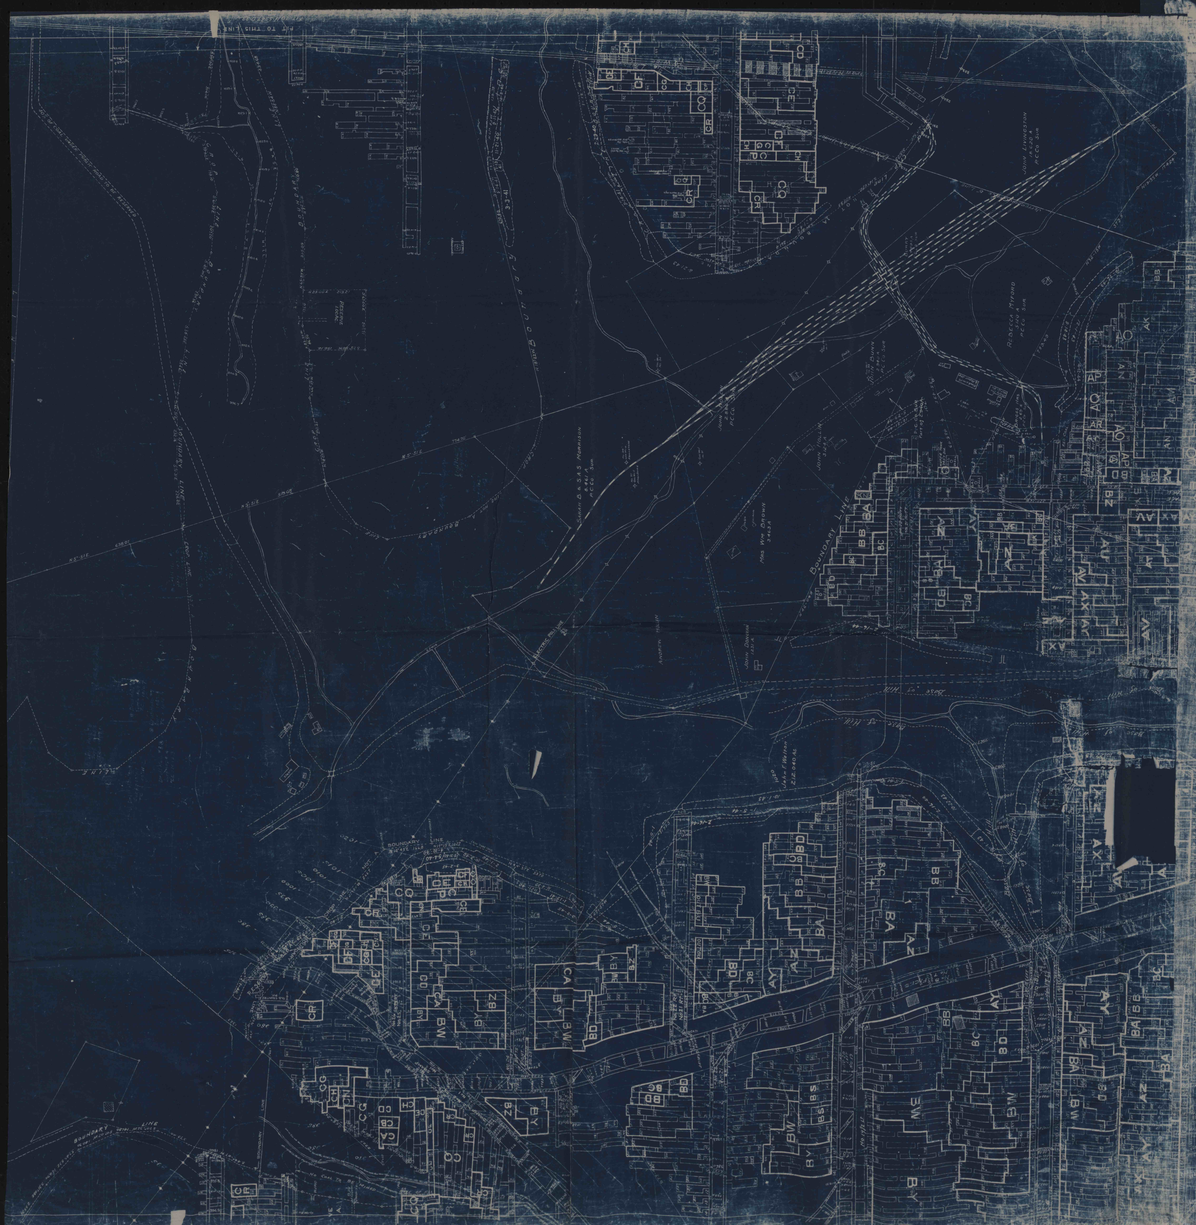
Boundary Line
Boundary Line
Boundary Line
Boundary Line
