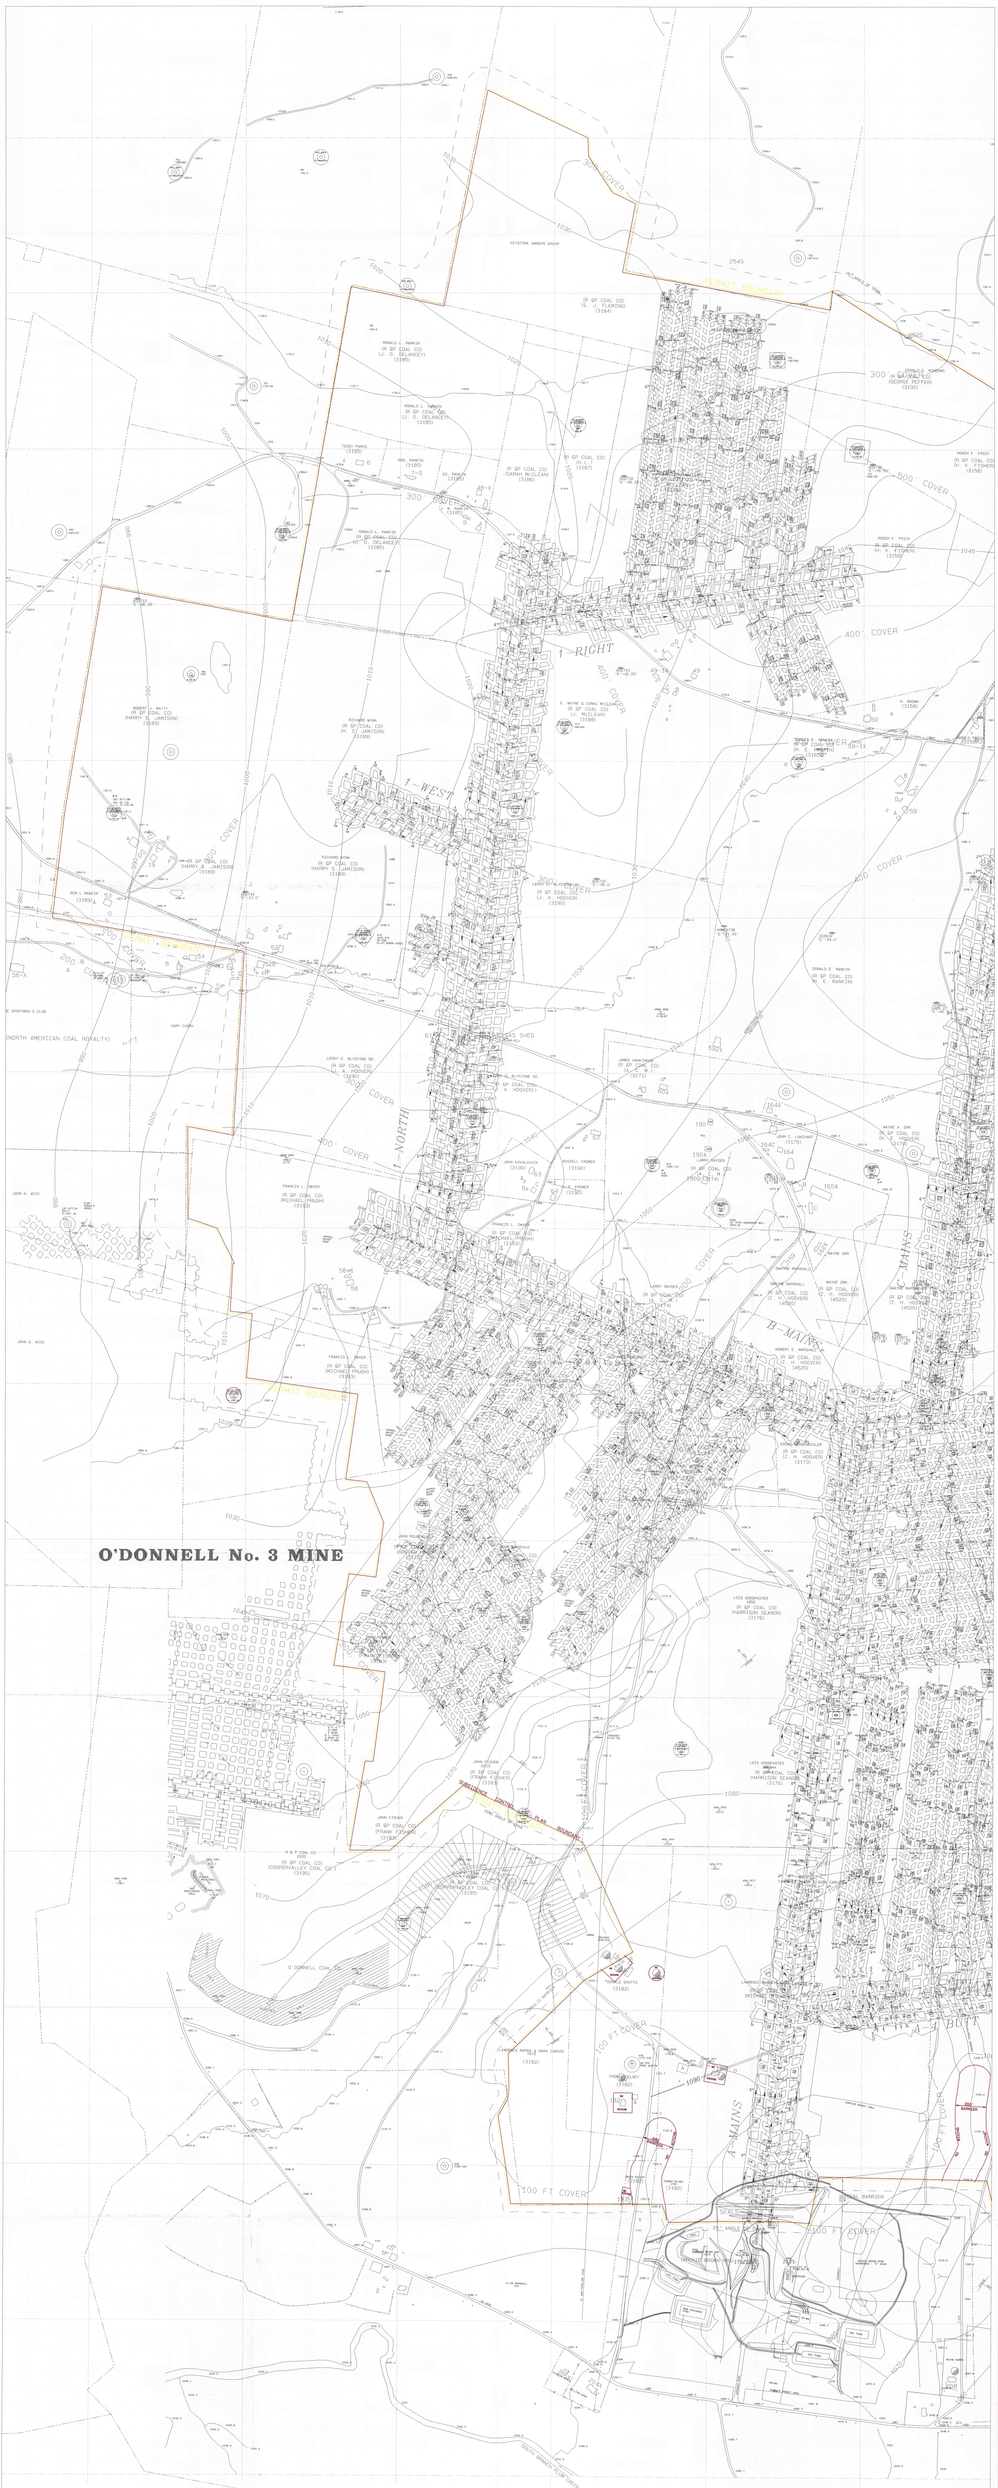
O'DONNELL No. 3 MINE
PERMIT BOUNDARY
1-RIGHT
1-WEST
1-NORTH
B-MAINS
C-MAINS
A-MAINS
300' COVER
400' COVER
500' COVER
100 FT COVER
NORTH AMERICAN COAL ROYALTY
O'DONNELL COAL CO.