


WYATT-SEANOR  
COAL CO.

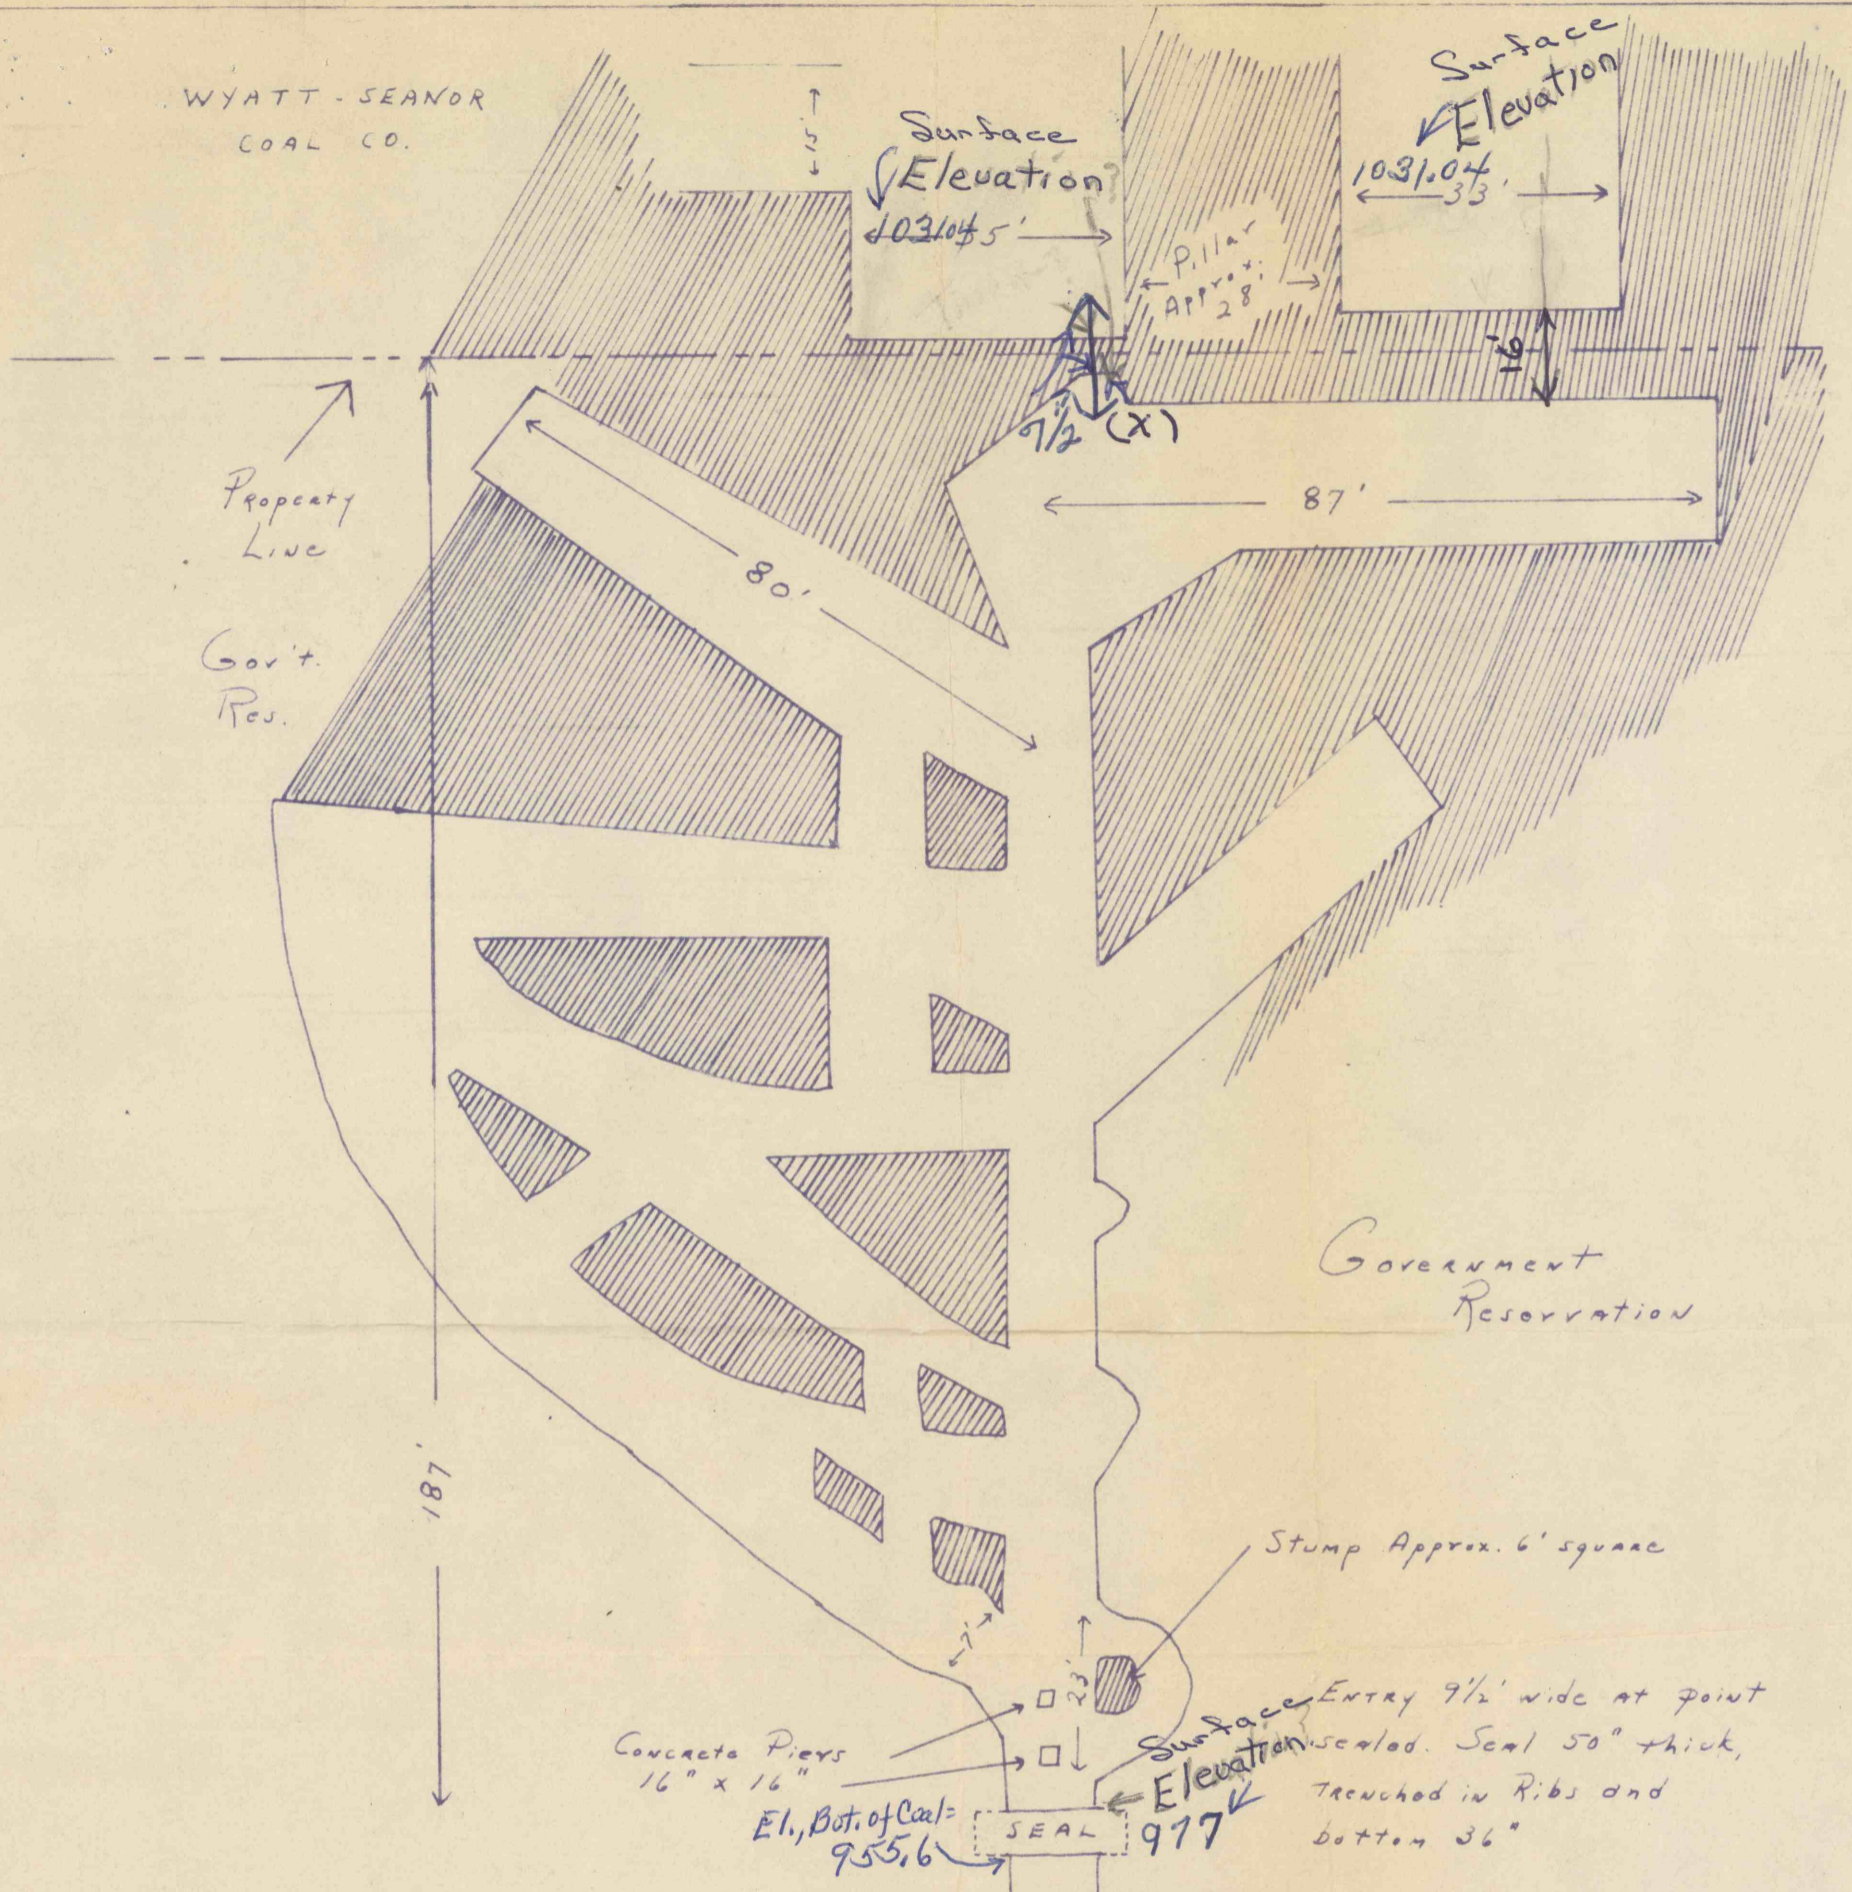

Concrete Piers  
16" x 16"

El., Bot. of Coal =  
955.6

Pit Mouth  
OLD MINE

Surface Entry 7 1/2' wide at point  
sealed. Seal 50" thick,  
Trenched in Ribs and  
bottom 36"

Elevation of bottom of coal  
at Seal - 955.6'

Elevation of bottom of  
coal at X - 957

WYATT SEANOR COAL COMPANY  
Map Showing  
Mine Seal of Abandoned Coal Mine  
May 10, 1957