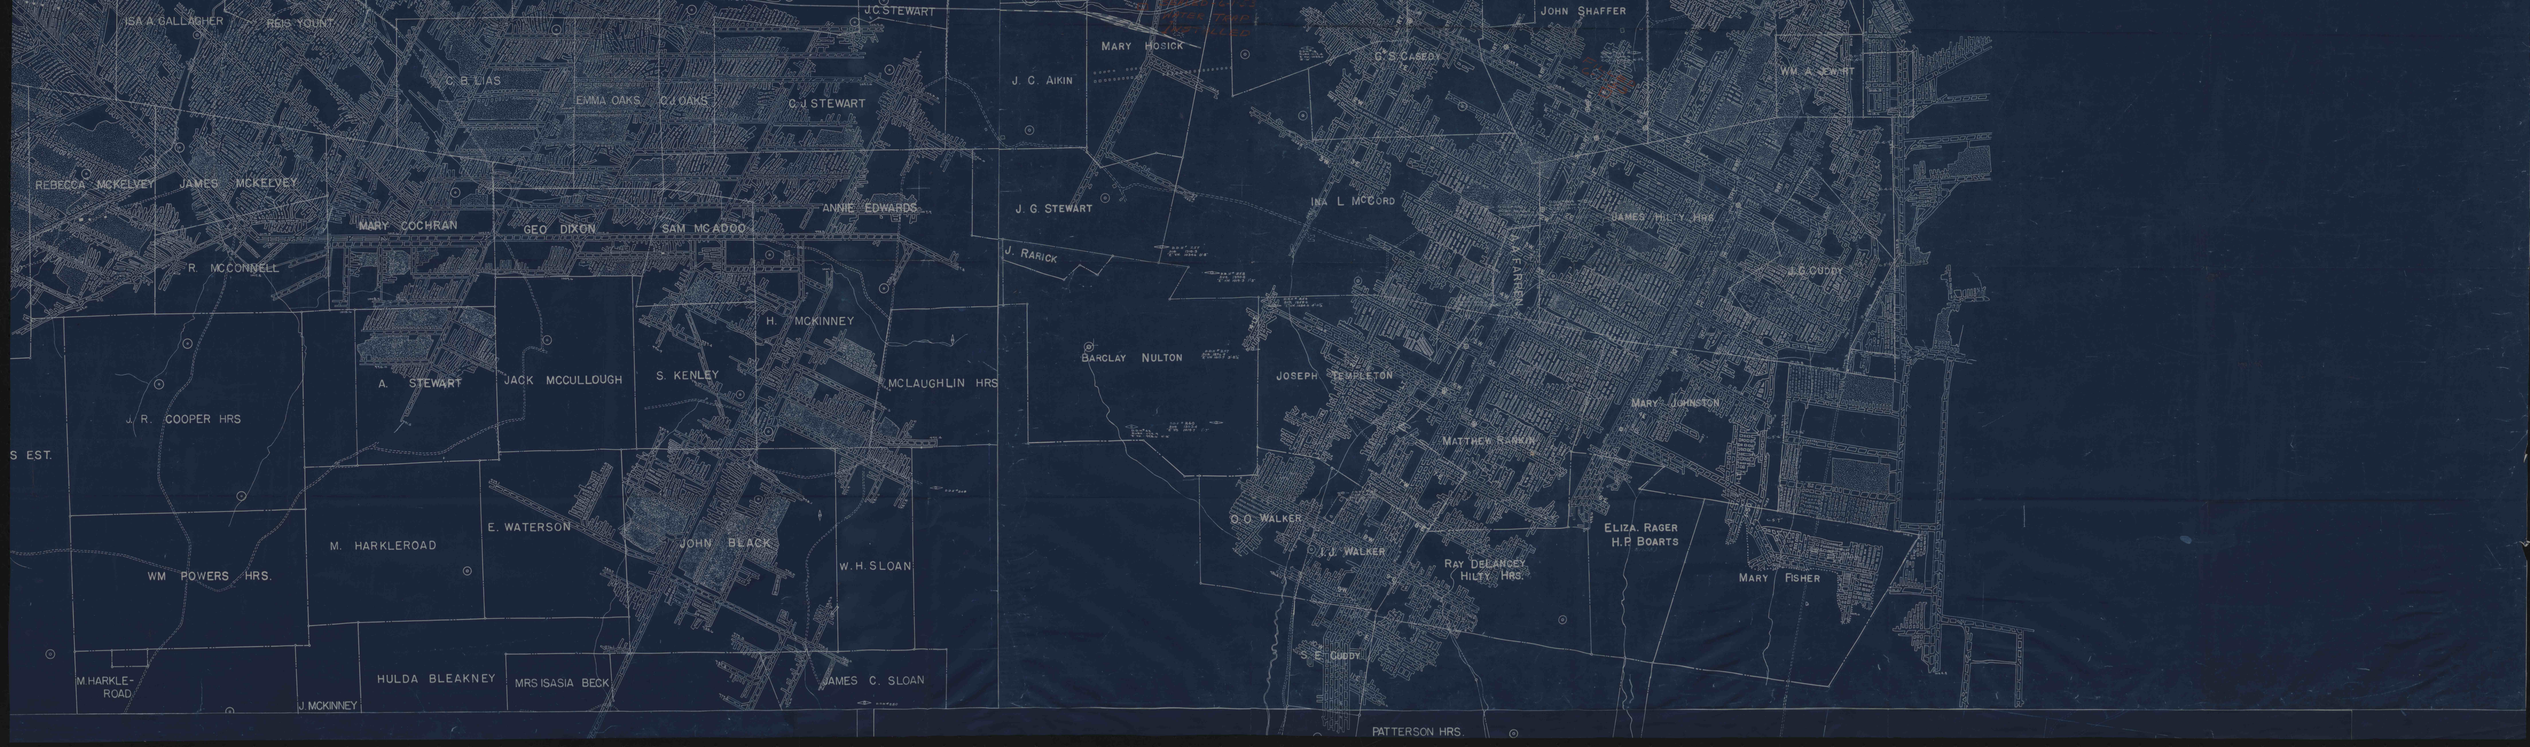
ISA A. GALLAGHER
REIS YOUNT
J.C.STEWART
C. B. LIAS
EMMA OAKS
C.J. OAKS
C. J STEWART
MARY HOSICK
J. C. AIKIN
JOHN SHAFFER
C. S. CASEDY
WM. A. SEWART
REBECCA MCKELVEY
JAMES MCKELVEY
MARY COCHRAN
GEO DIXON
SAM MCADOO
ANNIE EDWARDS
J. G. STEWART
INA L. MCCORD
JAMES HILTY HRS
R. MCCONNELL
J. RARICK
J. C. CUDDY
H. MCKINNEY
BARCLAY NULTON
JOSEPH TEMPLETON
A. STEWART
JACK MCCULLOUGH
S. KENLEY
MCLAUGHLIN HRS
MARY JOHNSTON
J. R. COOPER HRS
MATTHEW RANKIN
O. O. WALKER
ELIZA. RAGER
H. P. BOARTS
E. WATERSON
M. HARKLEROAD
JOHN BLACK
J. J. WALKER
RAY DELANCEY
HILTY HRS.
WM POWERS HRS.
W. H. SLOAN
MARY FISHER
S. E. CUDDY
M. HARKLE-
ROAD
HULDA BLEAKNEY
MRS ISASIA BECK
JAMES C. SLOAN
J. MCKINNEY
PATTERSON HRS.