


← TO RT. -19 (BLACK TOP ROAD)

W. LIBERTY RD.

TO W. LIBERTY →

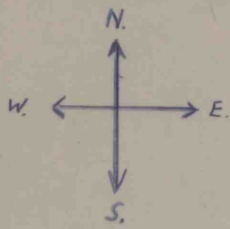

(DIRT CROSS ROAD)


SUOSIO FARM ↓ ABANDONED MINE

← 2,000 FT. →

(POUNDS FARM)

WRAH NAIWTAH FARM

JOSEPH FONCE COAL MINE

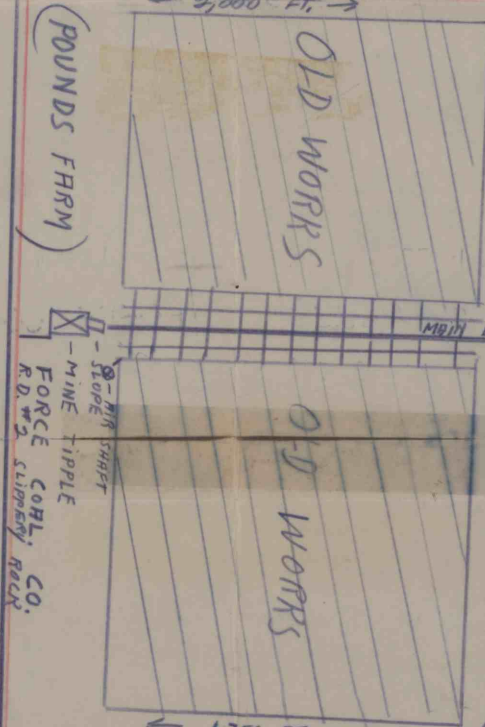

3,000 FT.

HUMPHRY FARM

← STILL SHAFT TO JACKS VILLE

TO SHAW PARK

← 1,750 FT. →

PATTERSON FARM

PATTERSON FARM

← AIR SHAFET