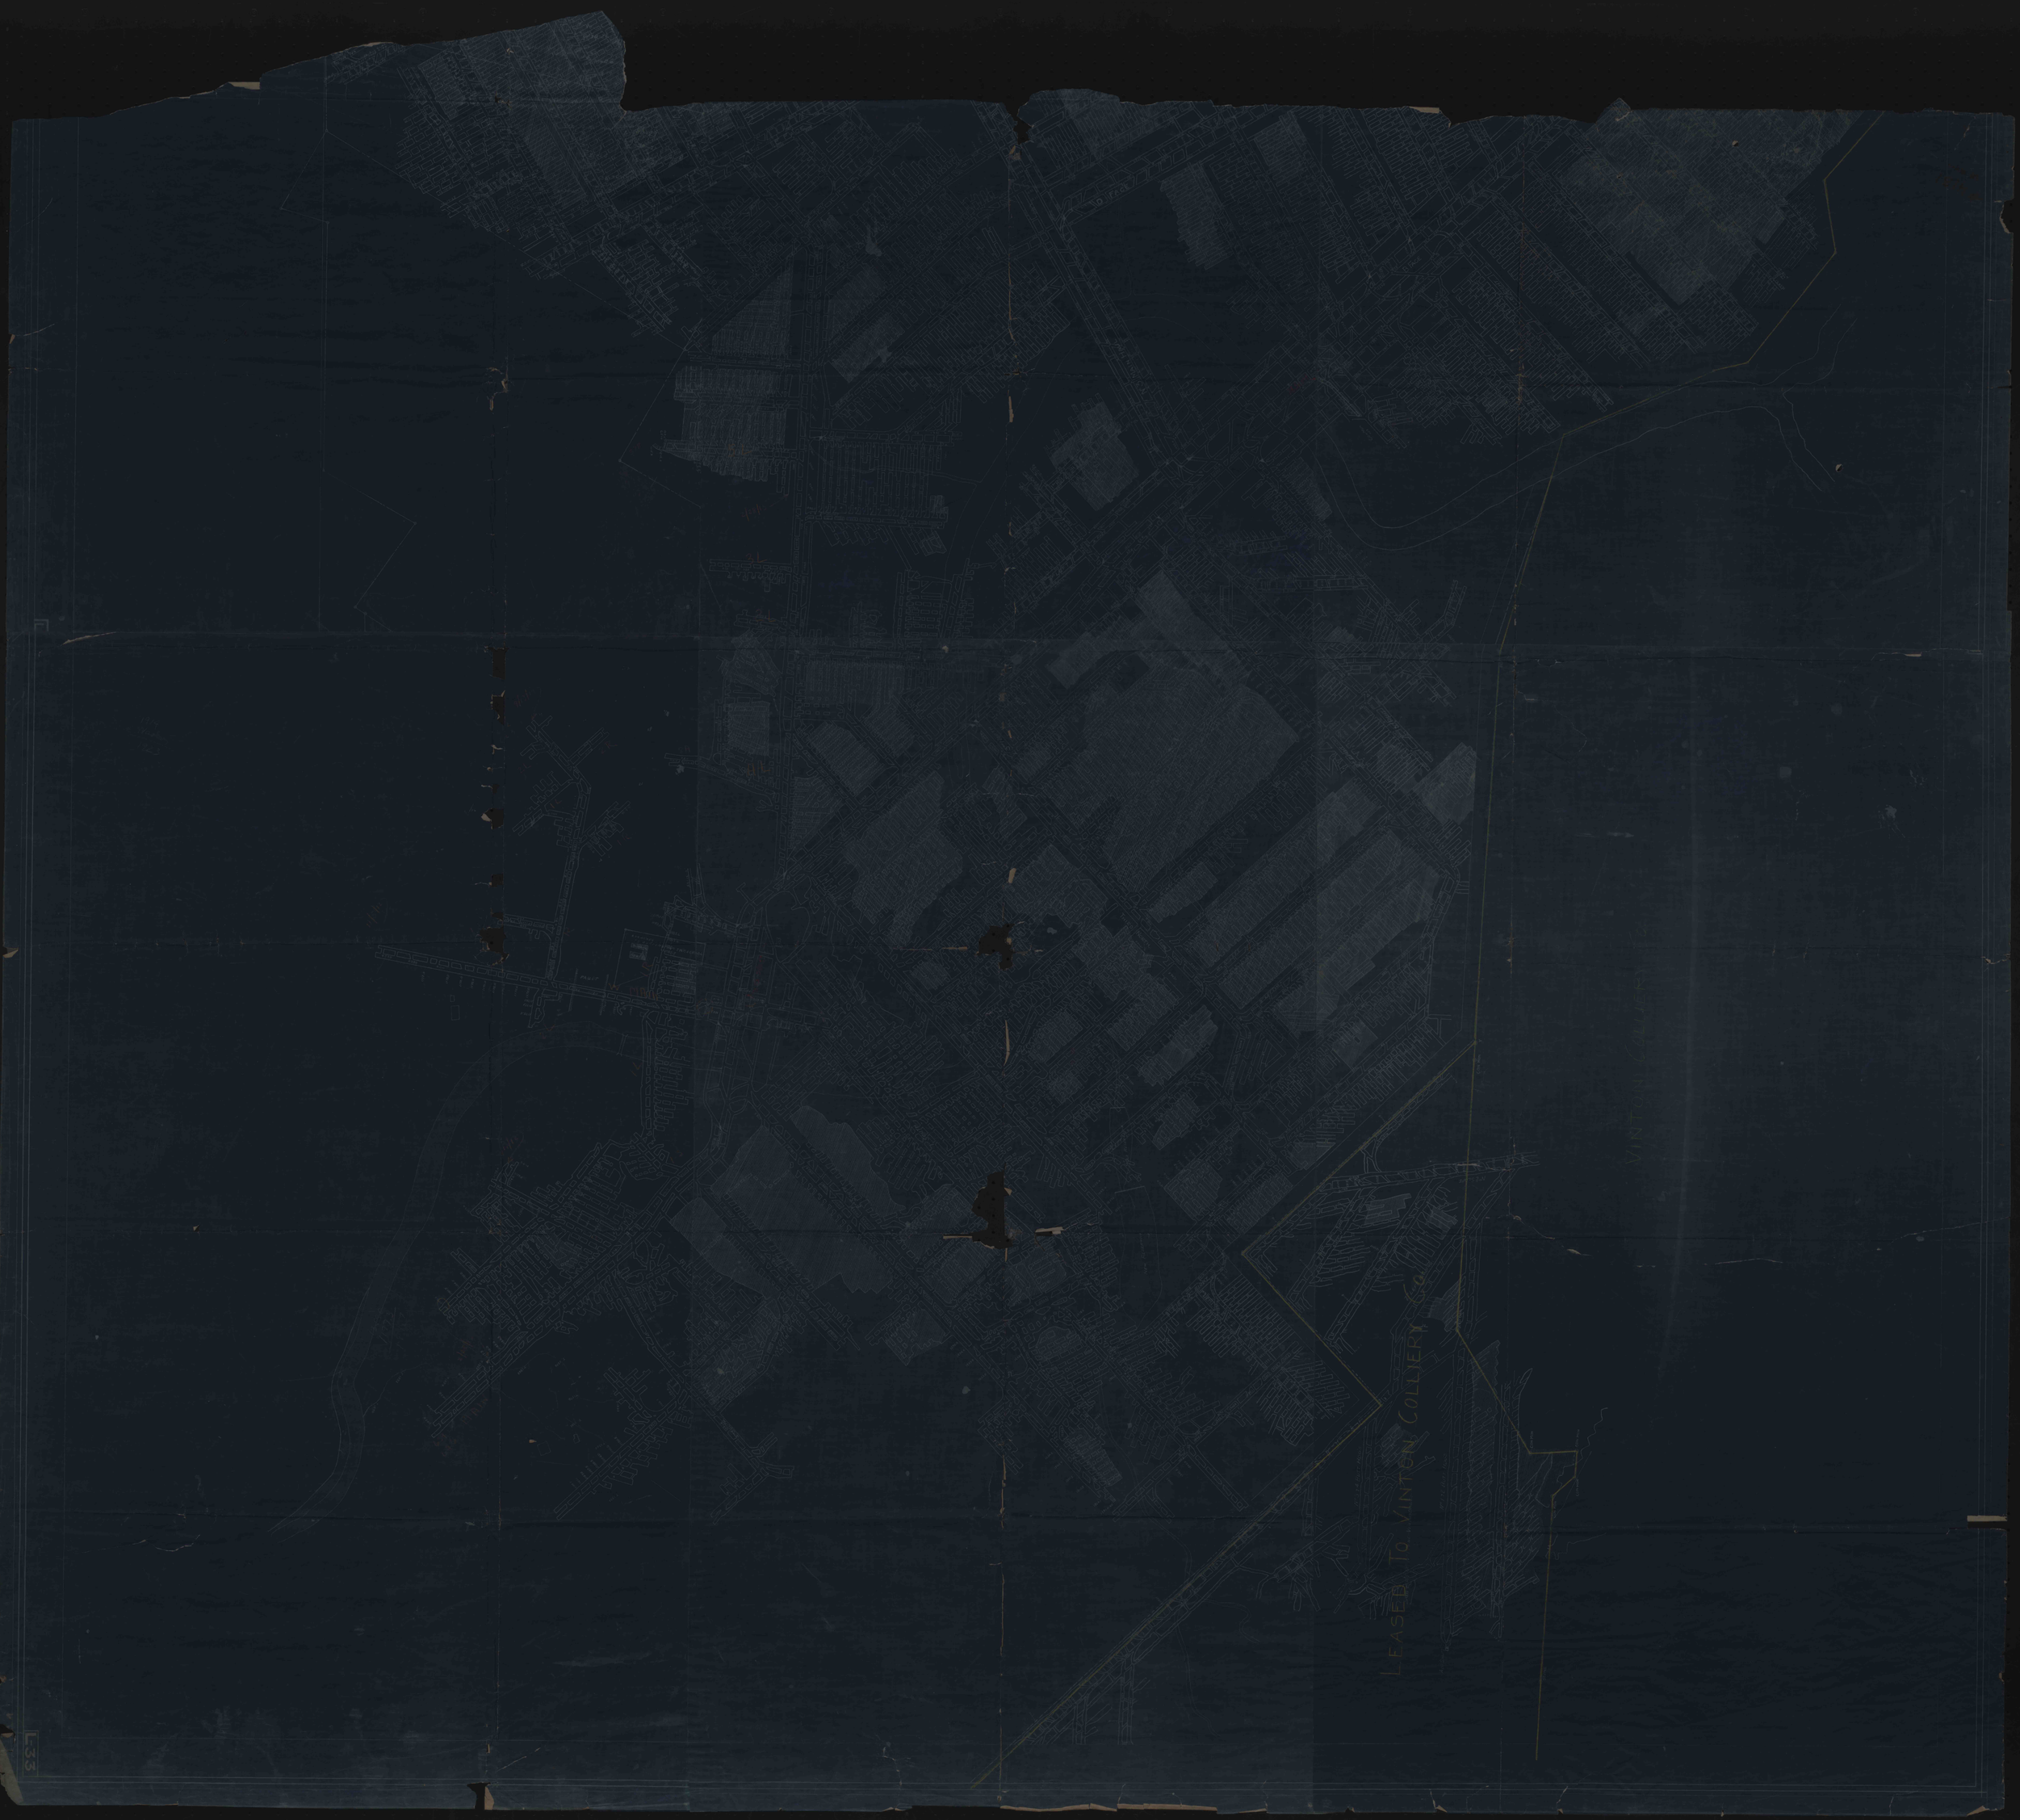
LEASED TO VINTEN COLLIERY Co.