


4278

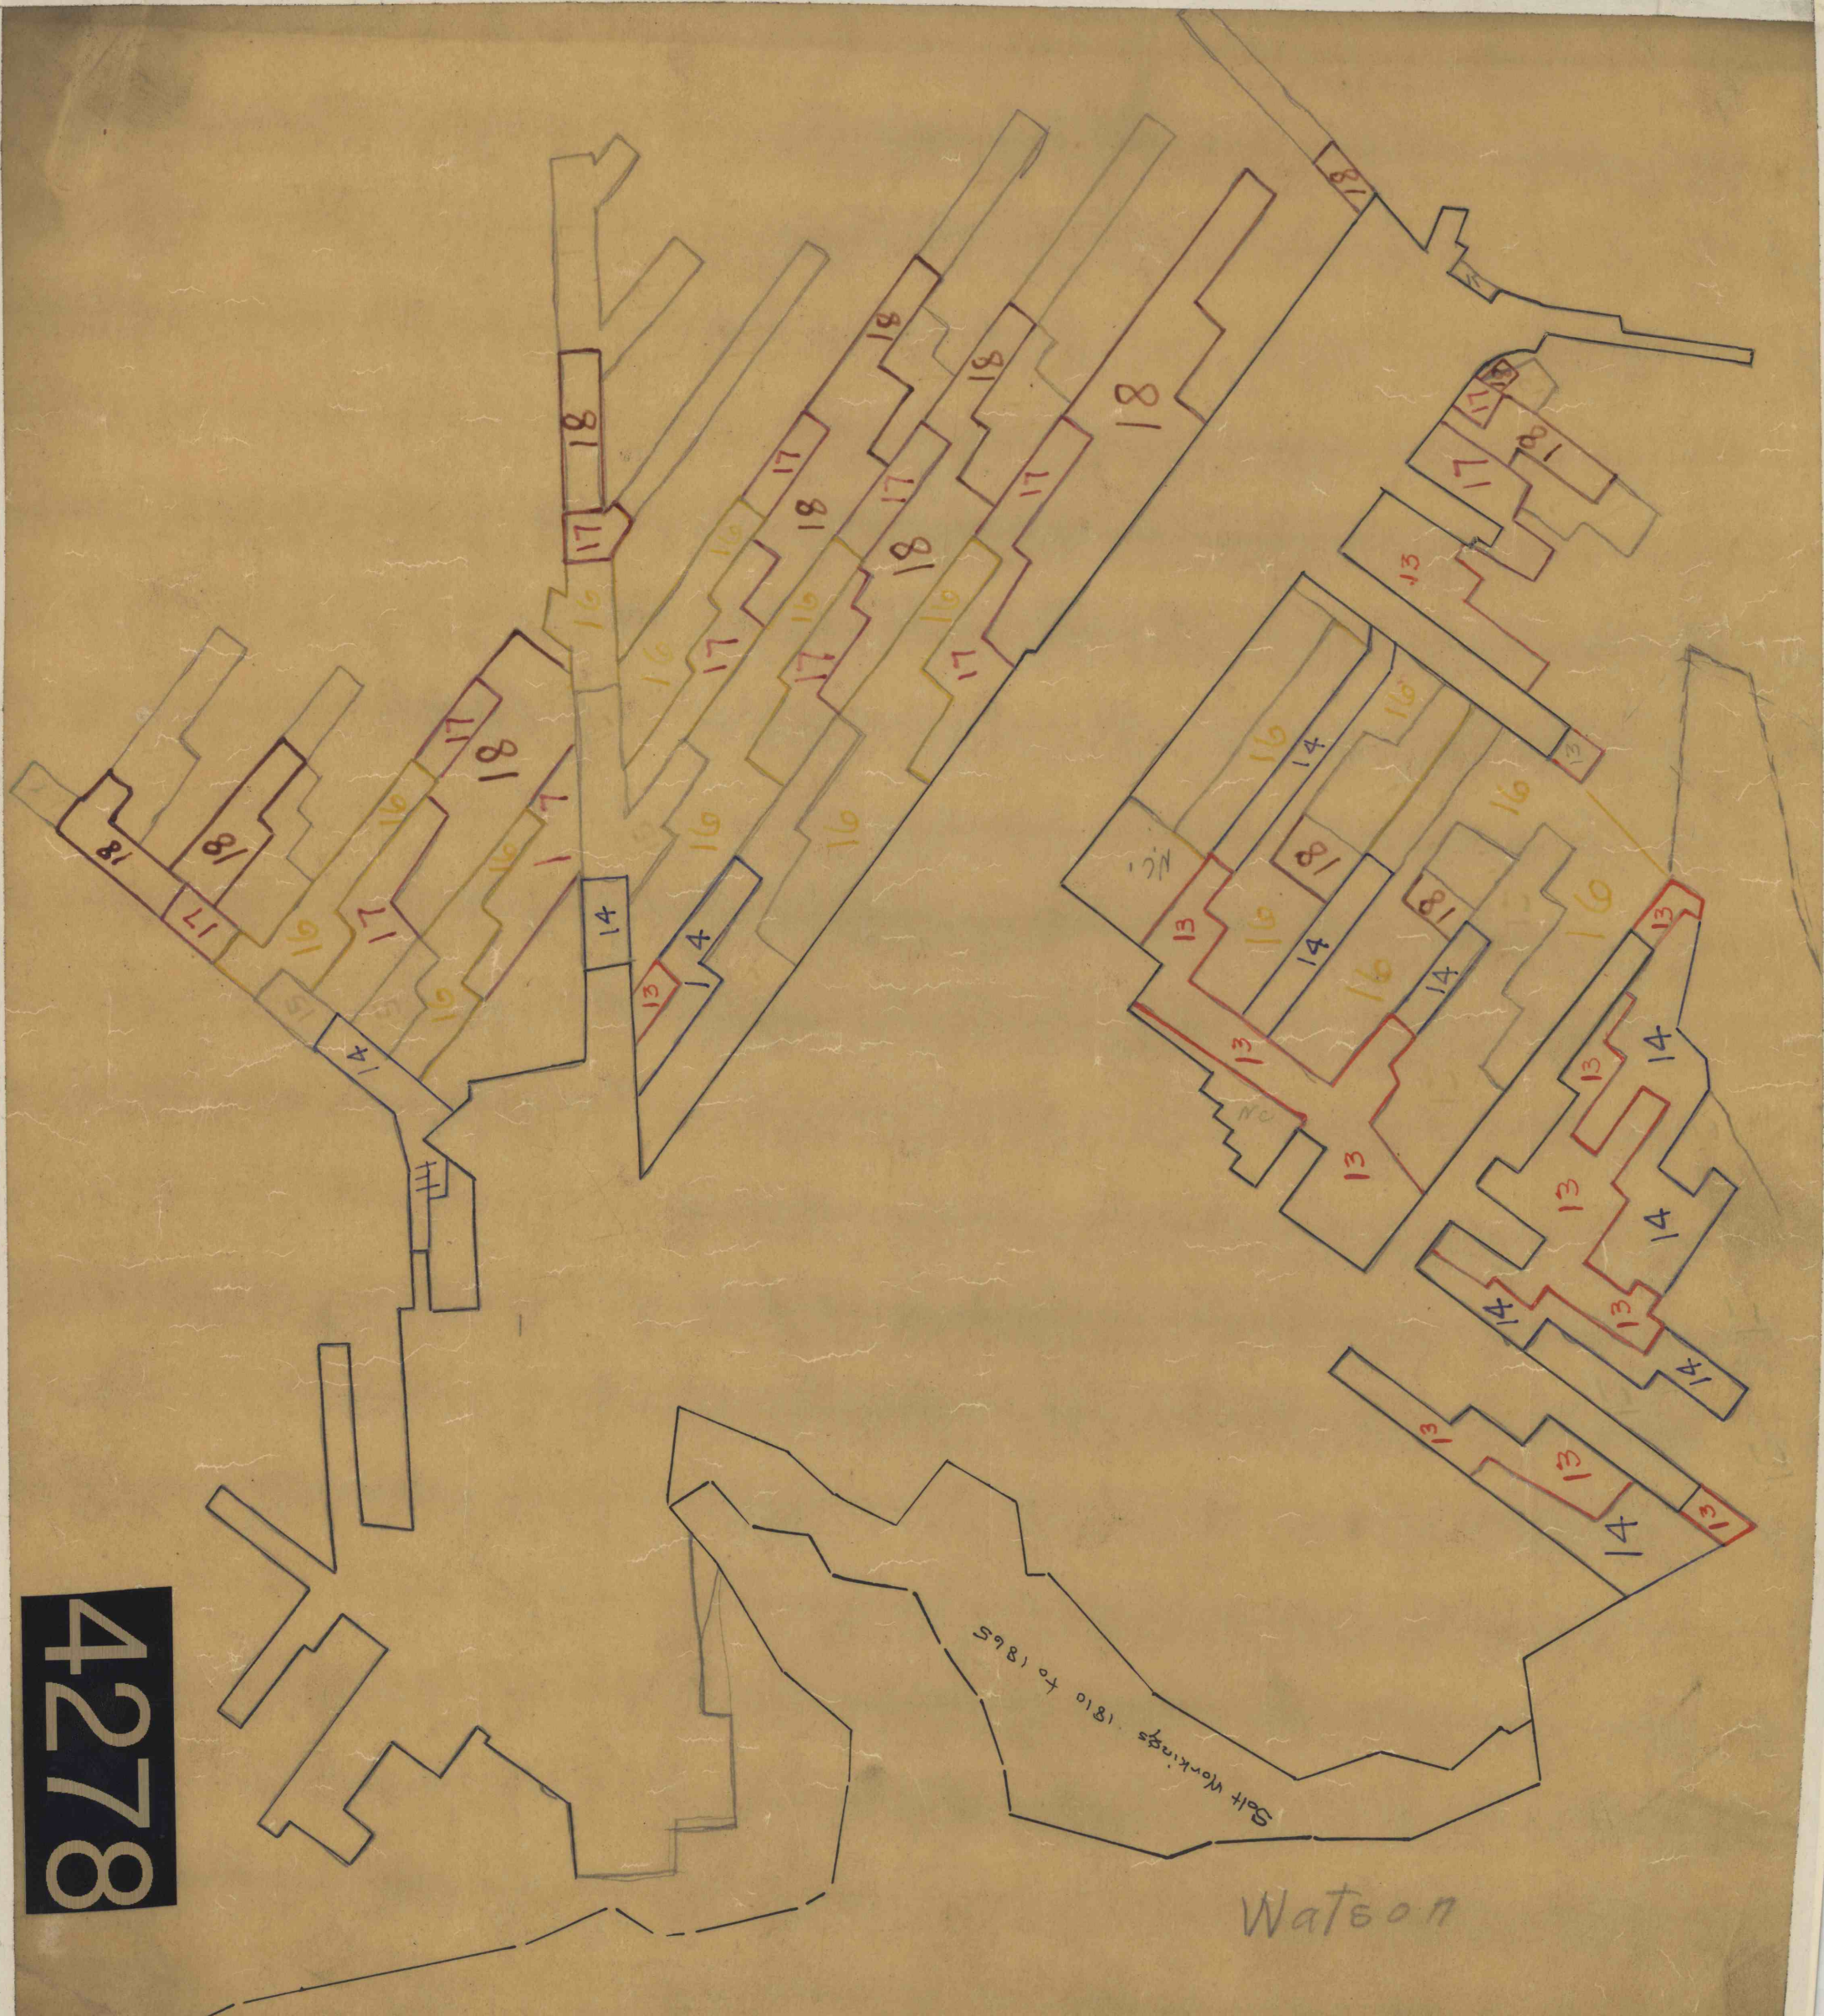

Watson

Wat 5007
~~2269~~ 5-1