
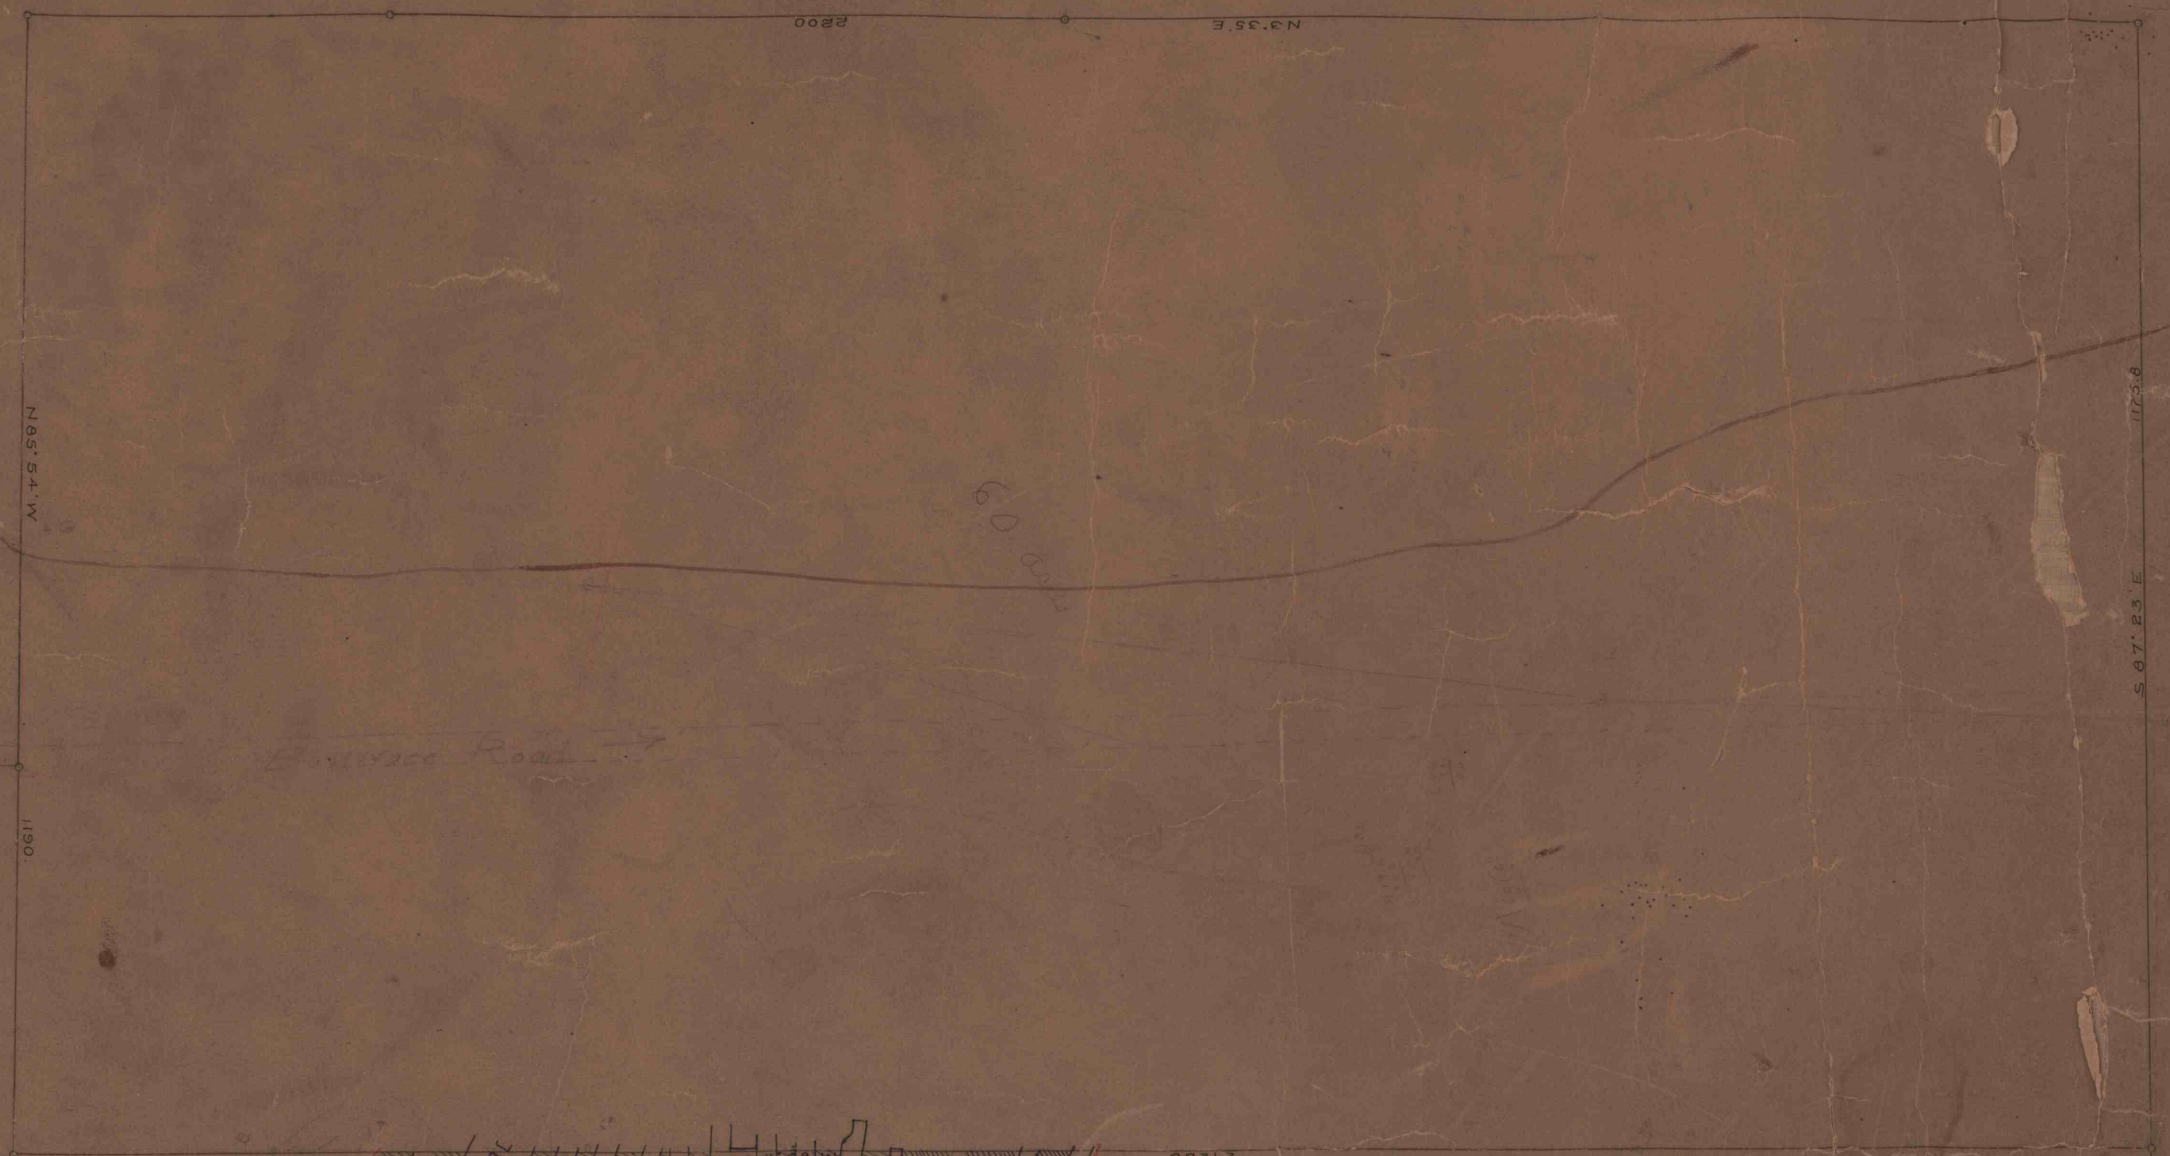



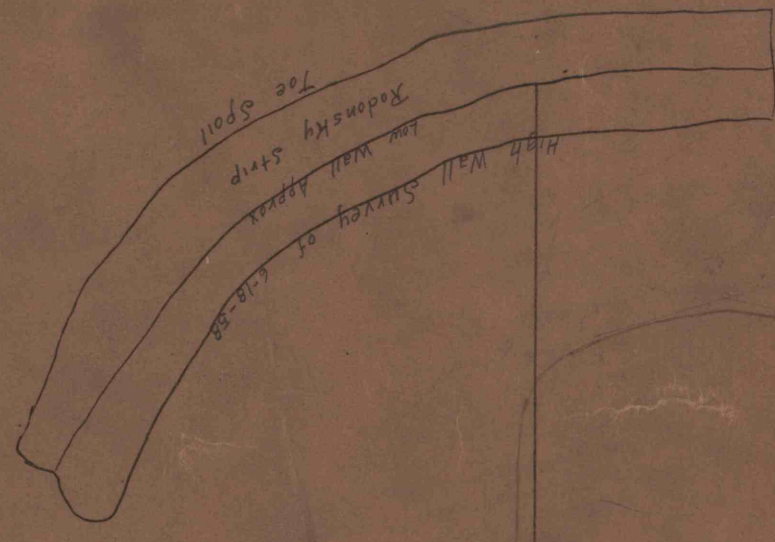

P.C. & C.O.
RES. 10A.

NAGLE

FRANCIS YEAGER

MICHAEL THOMAS