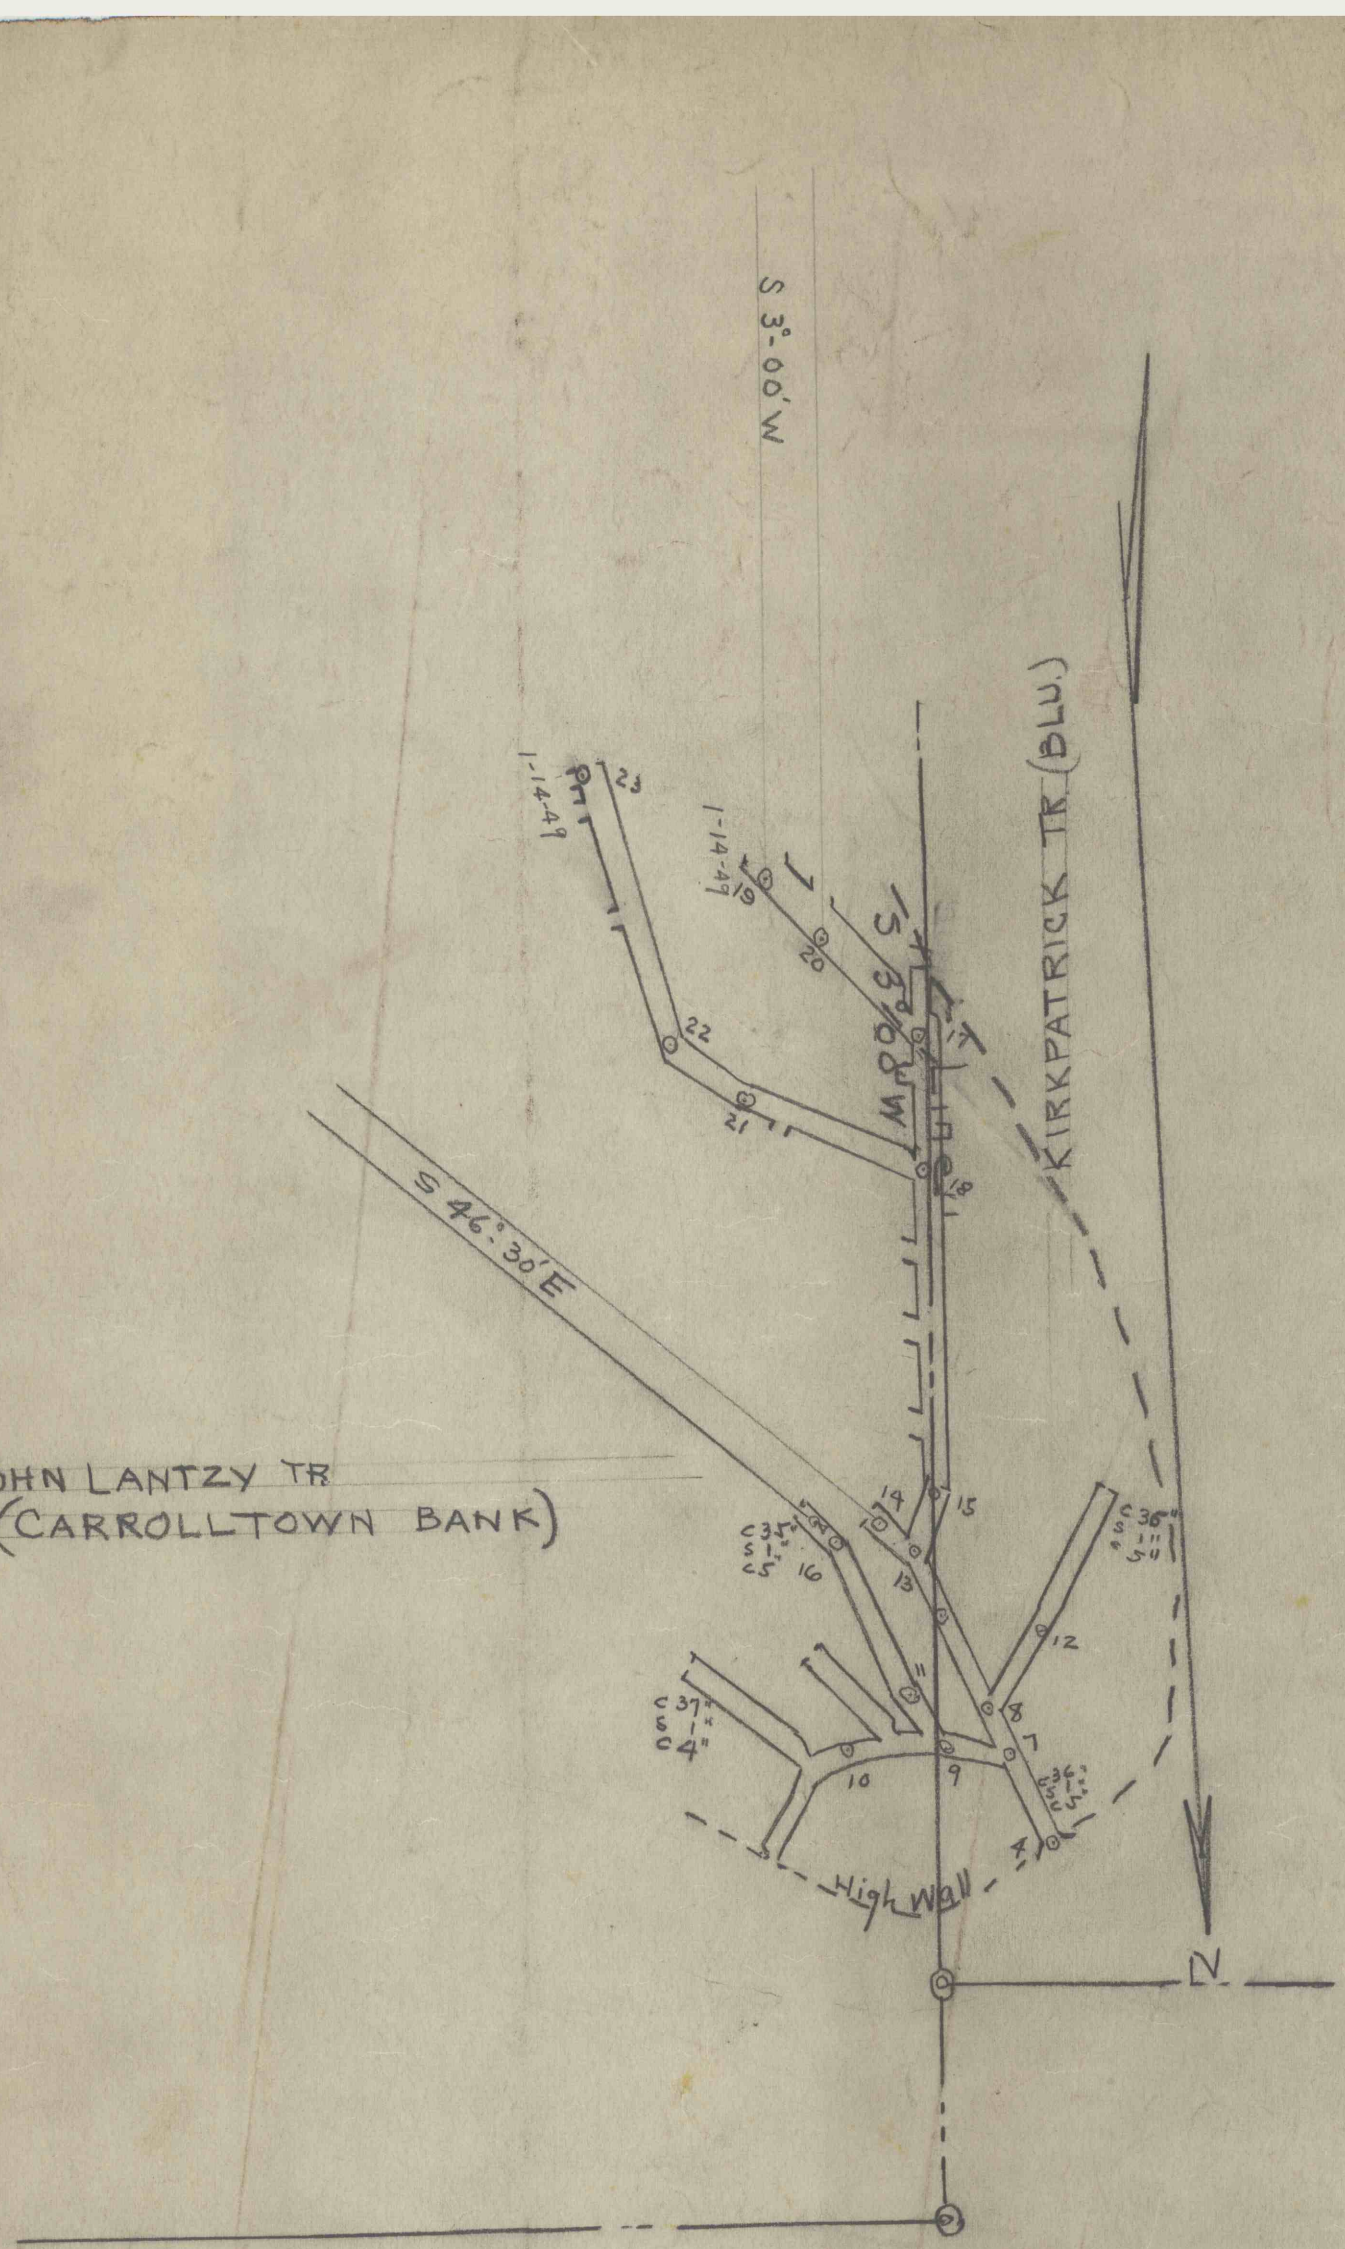

Vol. 159
Page 5