


BIGLER LEASE

KINPORT LEASE

Empire workings

FAULTY AREA

Rose Ann Coal Co
E. Scan
D. Thorpe

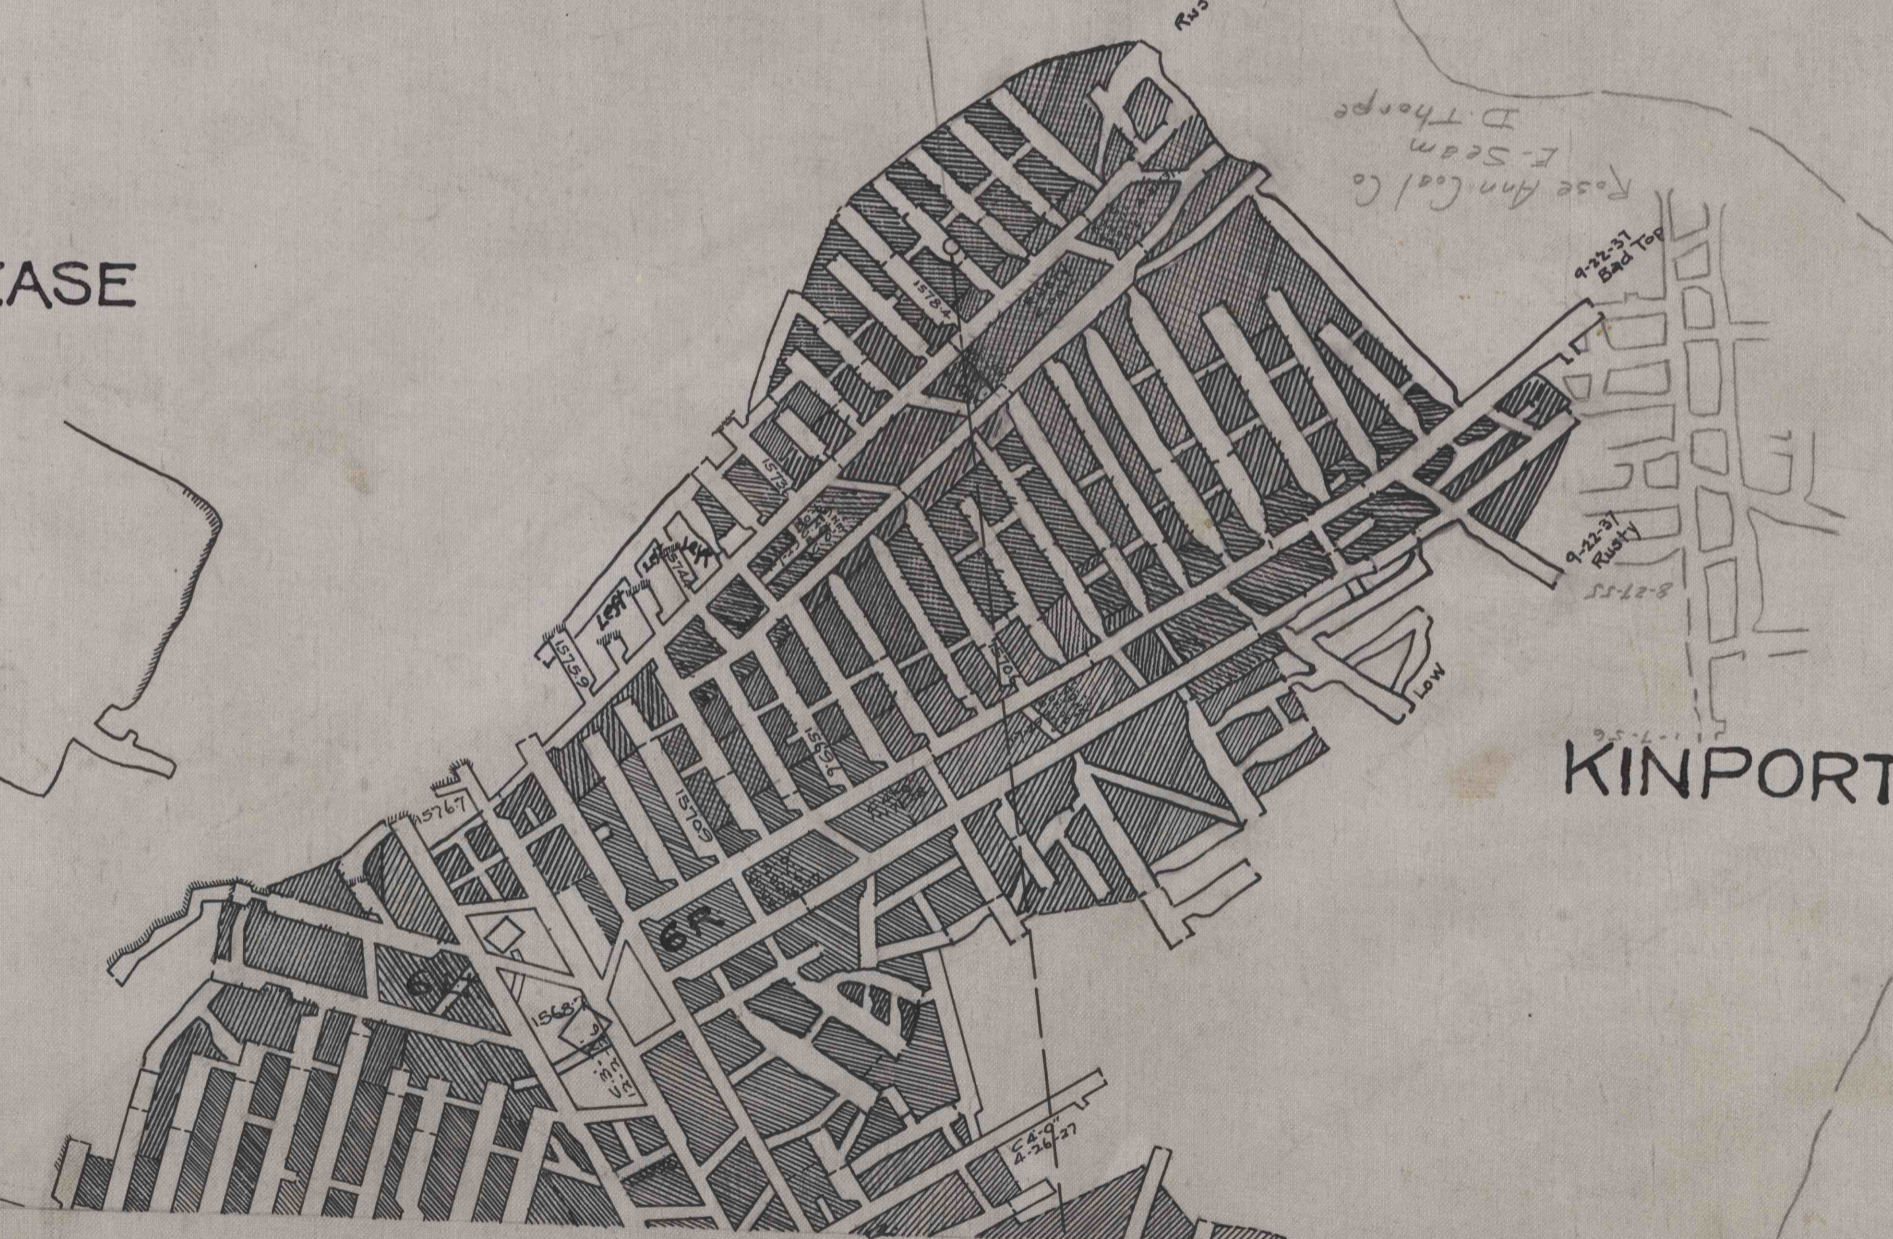

74 U

74 U