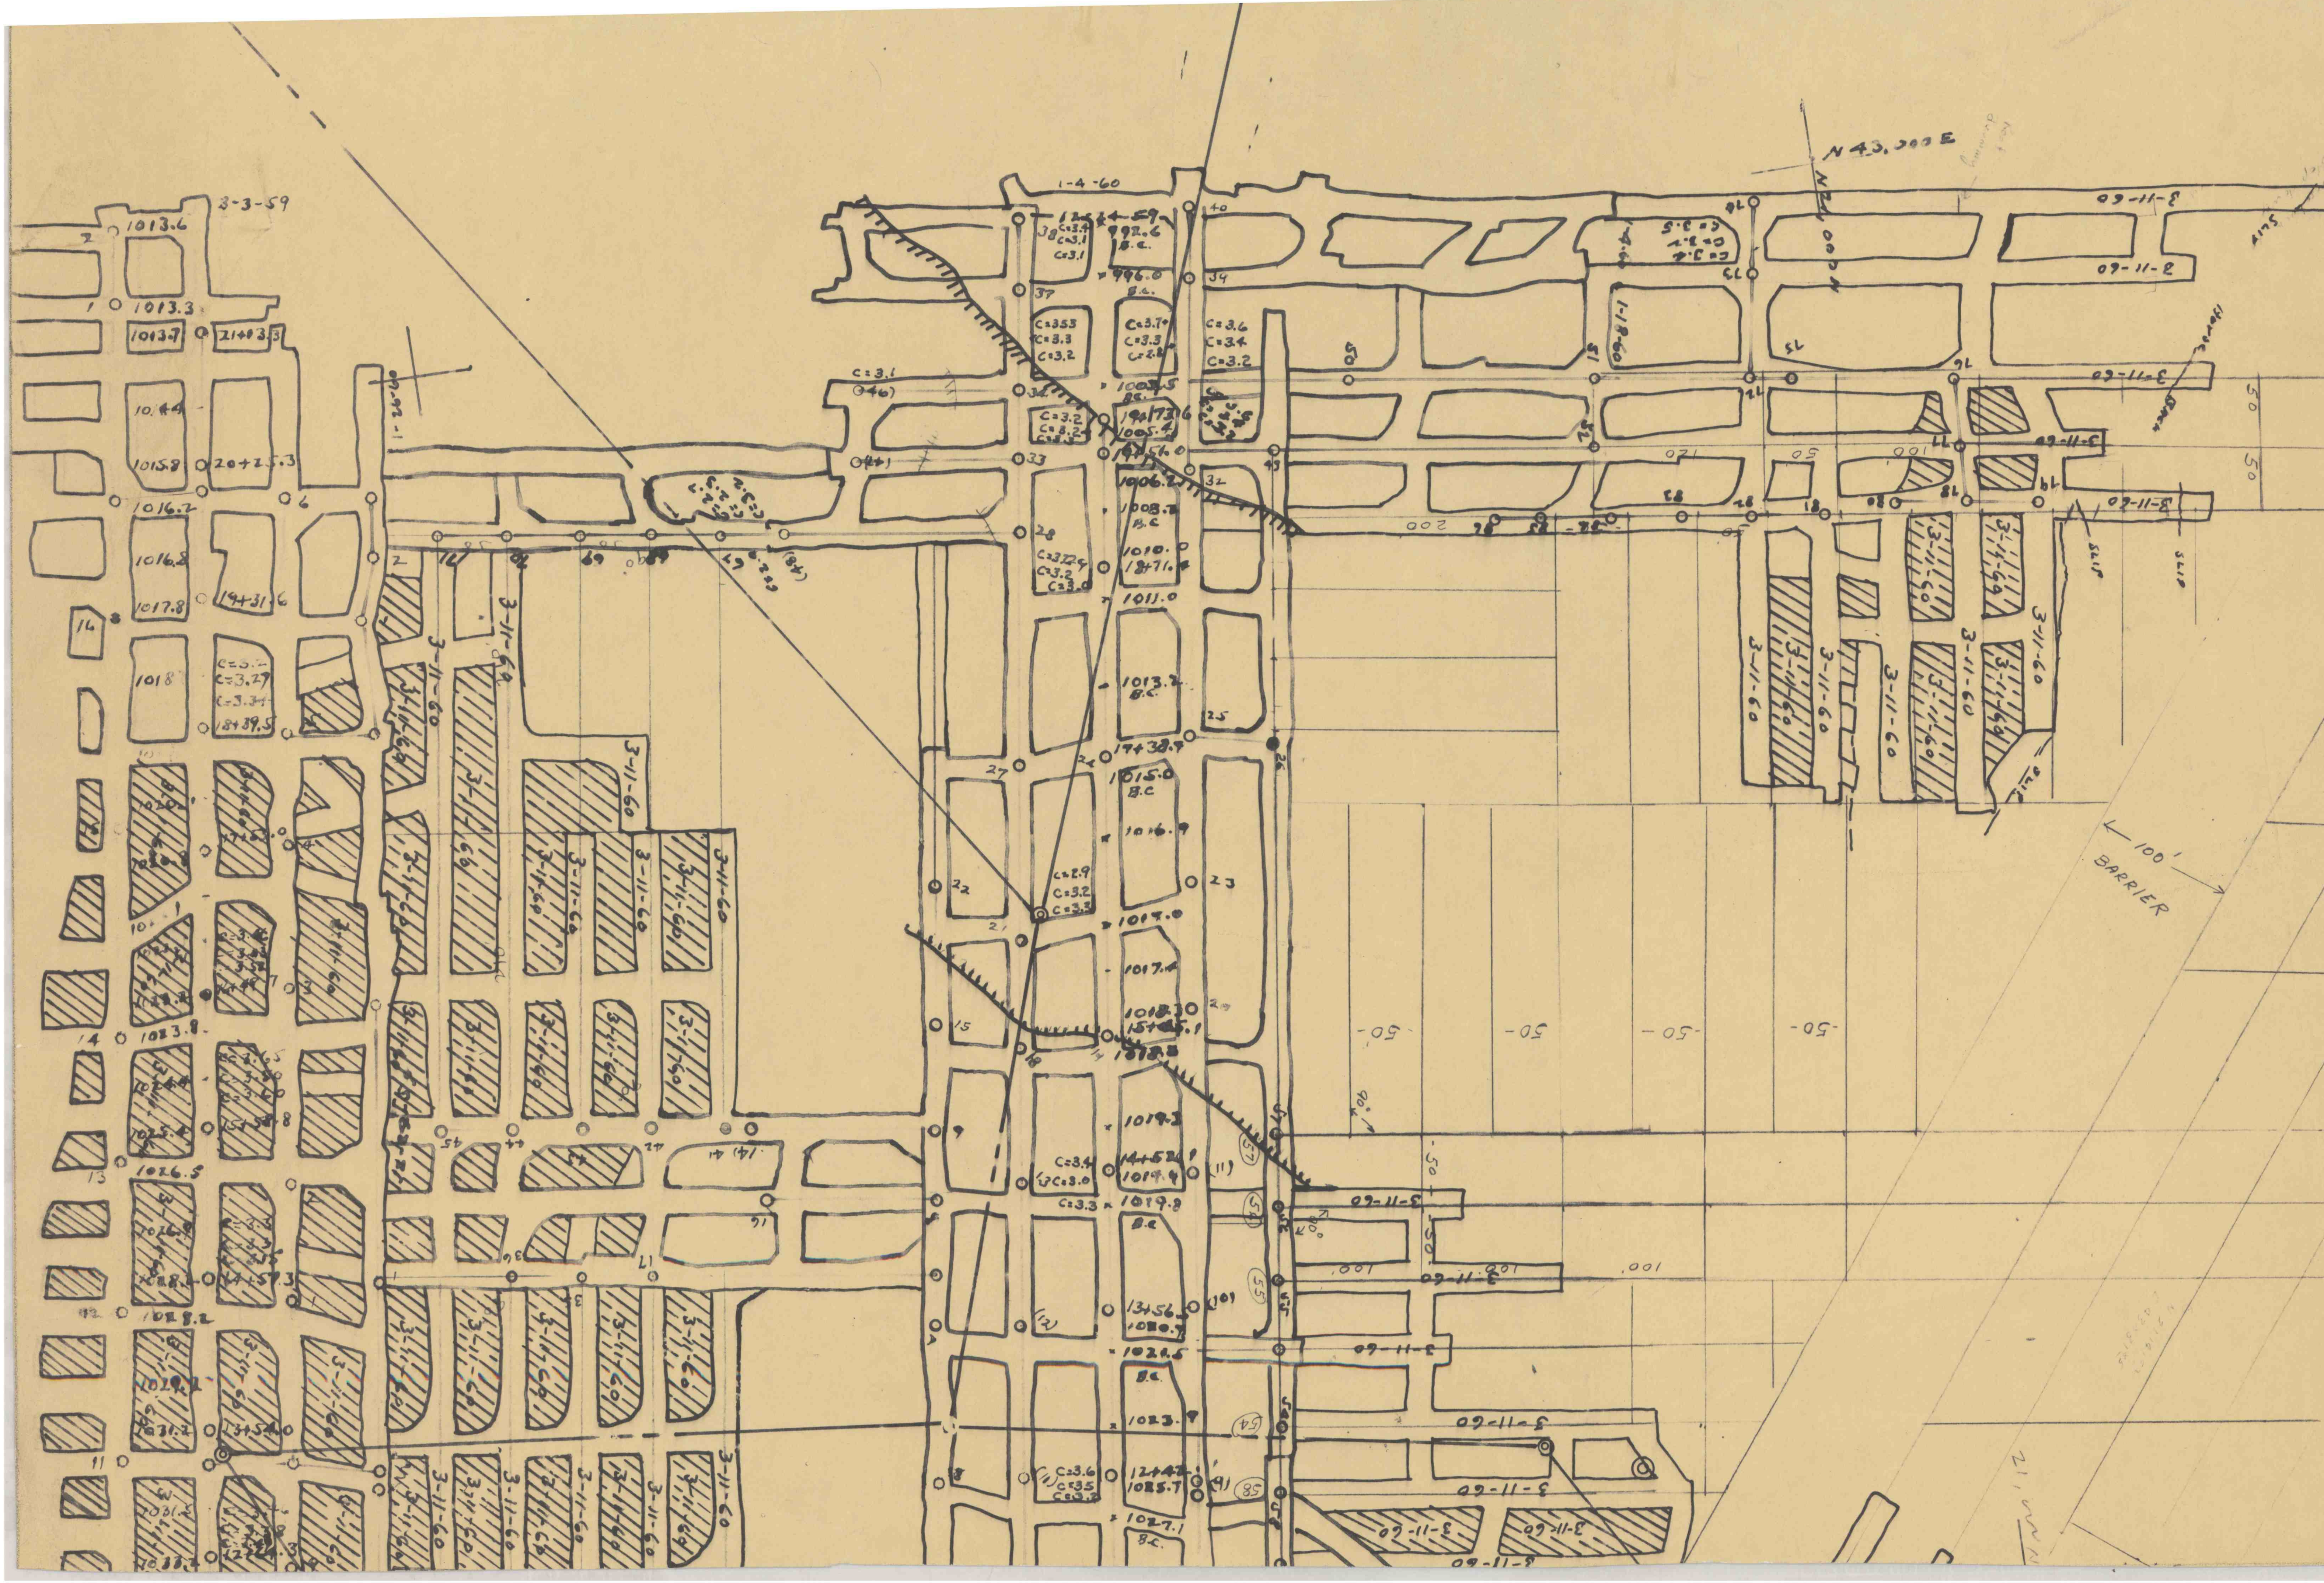
3-3-59
1013.6
1013.3
1013.7
21+13.3
1015.8
20+25.3
1016.2
1016.8
1017.8
19+31.6
1018
18+39.5
1023.8
1026.5
1028.2
1031.2
1-4-60
992.6
B.C.
996.0
C=3.1
1006.2
1008.2
1010.0
1011.0
1013.2
17+38.7
1015.0
1016.9
C=2.9
C=3.2
C=3.3
1017.0
1019.3
1019.4
1019.8
1023.4
1025.7
1027.1
N 43,000 E
N 21,000
1-18-60
3-11-60
SLIP
50
100
200
90°
100' BARRIER