


C.A. SCOTT

SURFACE - 180.00 AC.  
STRIP COAL - 56.30 AC.  
DEEP COAL - 55.50 AC.

DAVID ZOLLAR

SURFACE - 158.75 AC.  
STRIP COAL - 52.16 AC.  
DEEP COAL - 10.18 AC.

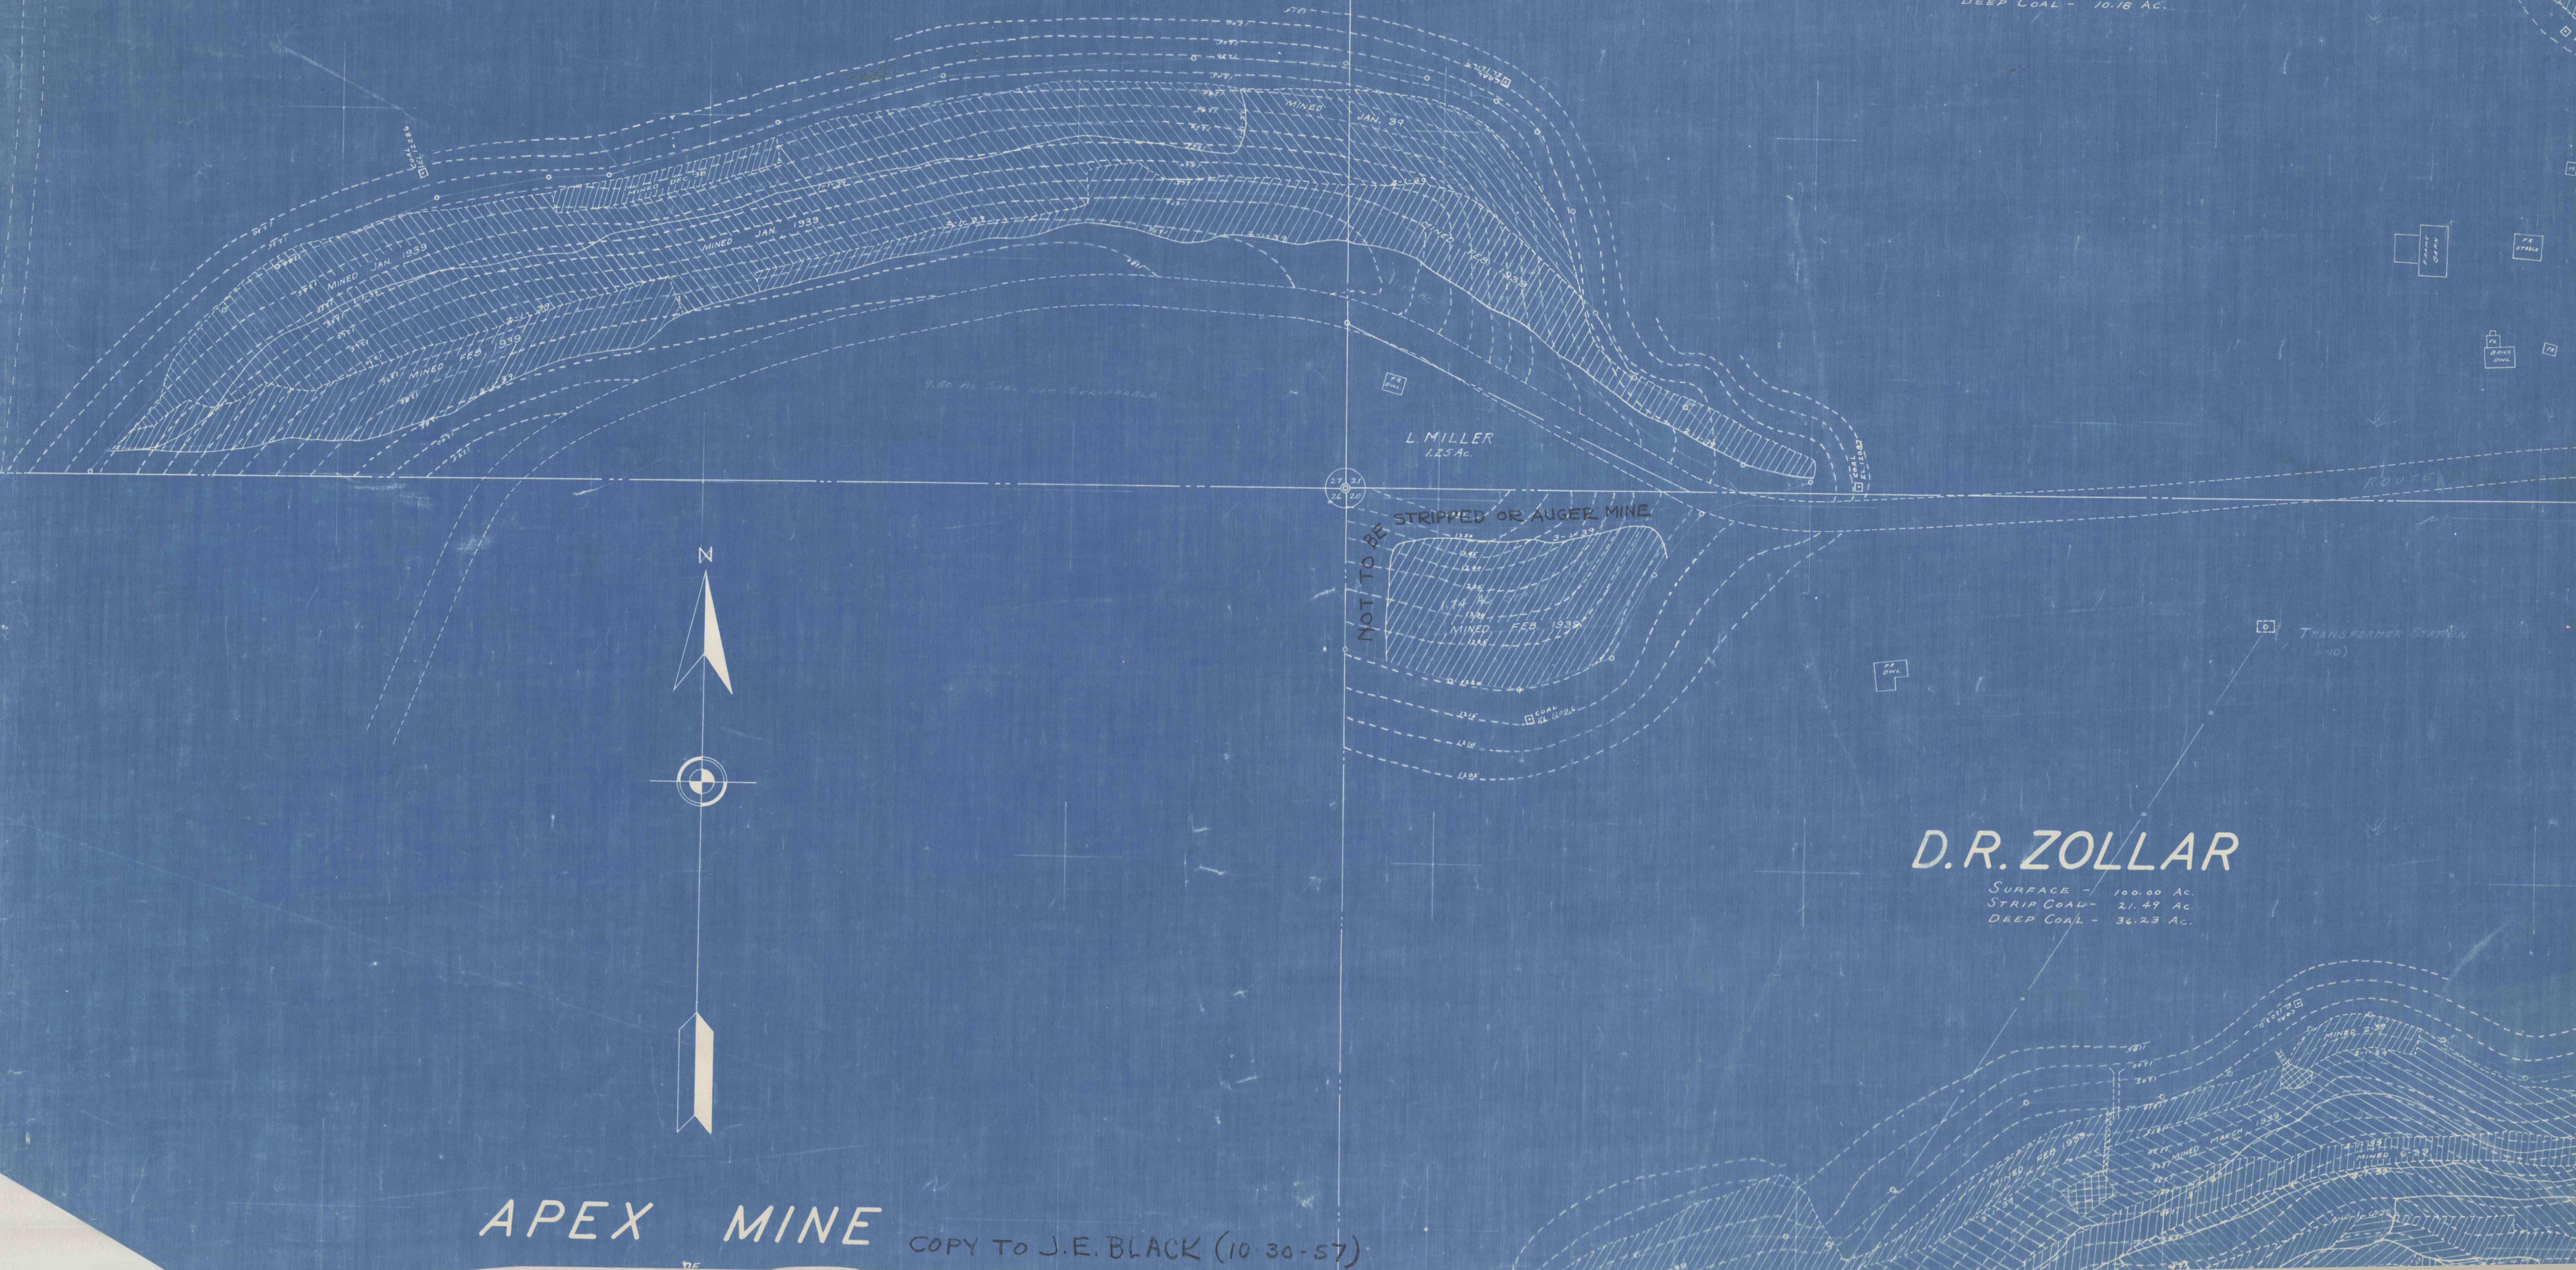

D.R. ZOLLAR

SURFACE - 100.00 AC.  
STRIP COAL - 21.49 AC.  
DEEP COAL - 36.23 AC.

APEX MINE

COPY TO J.E. BLACK (10-30-57)