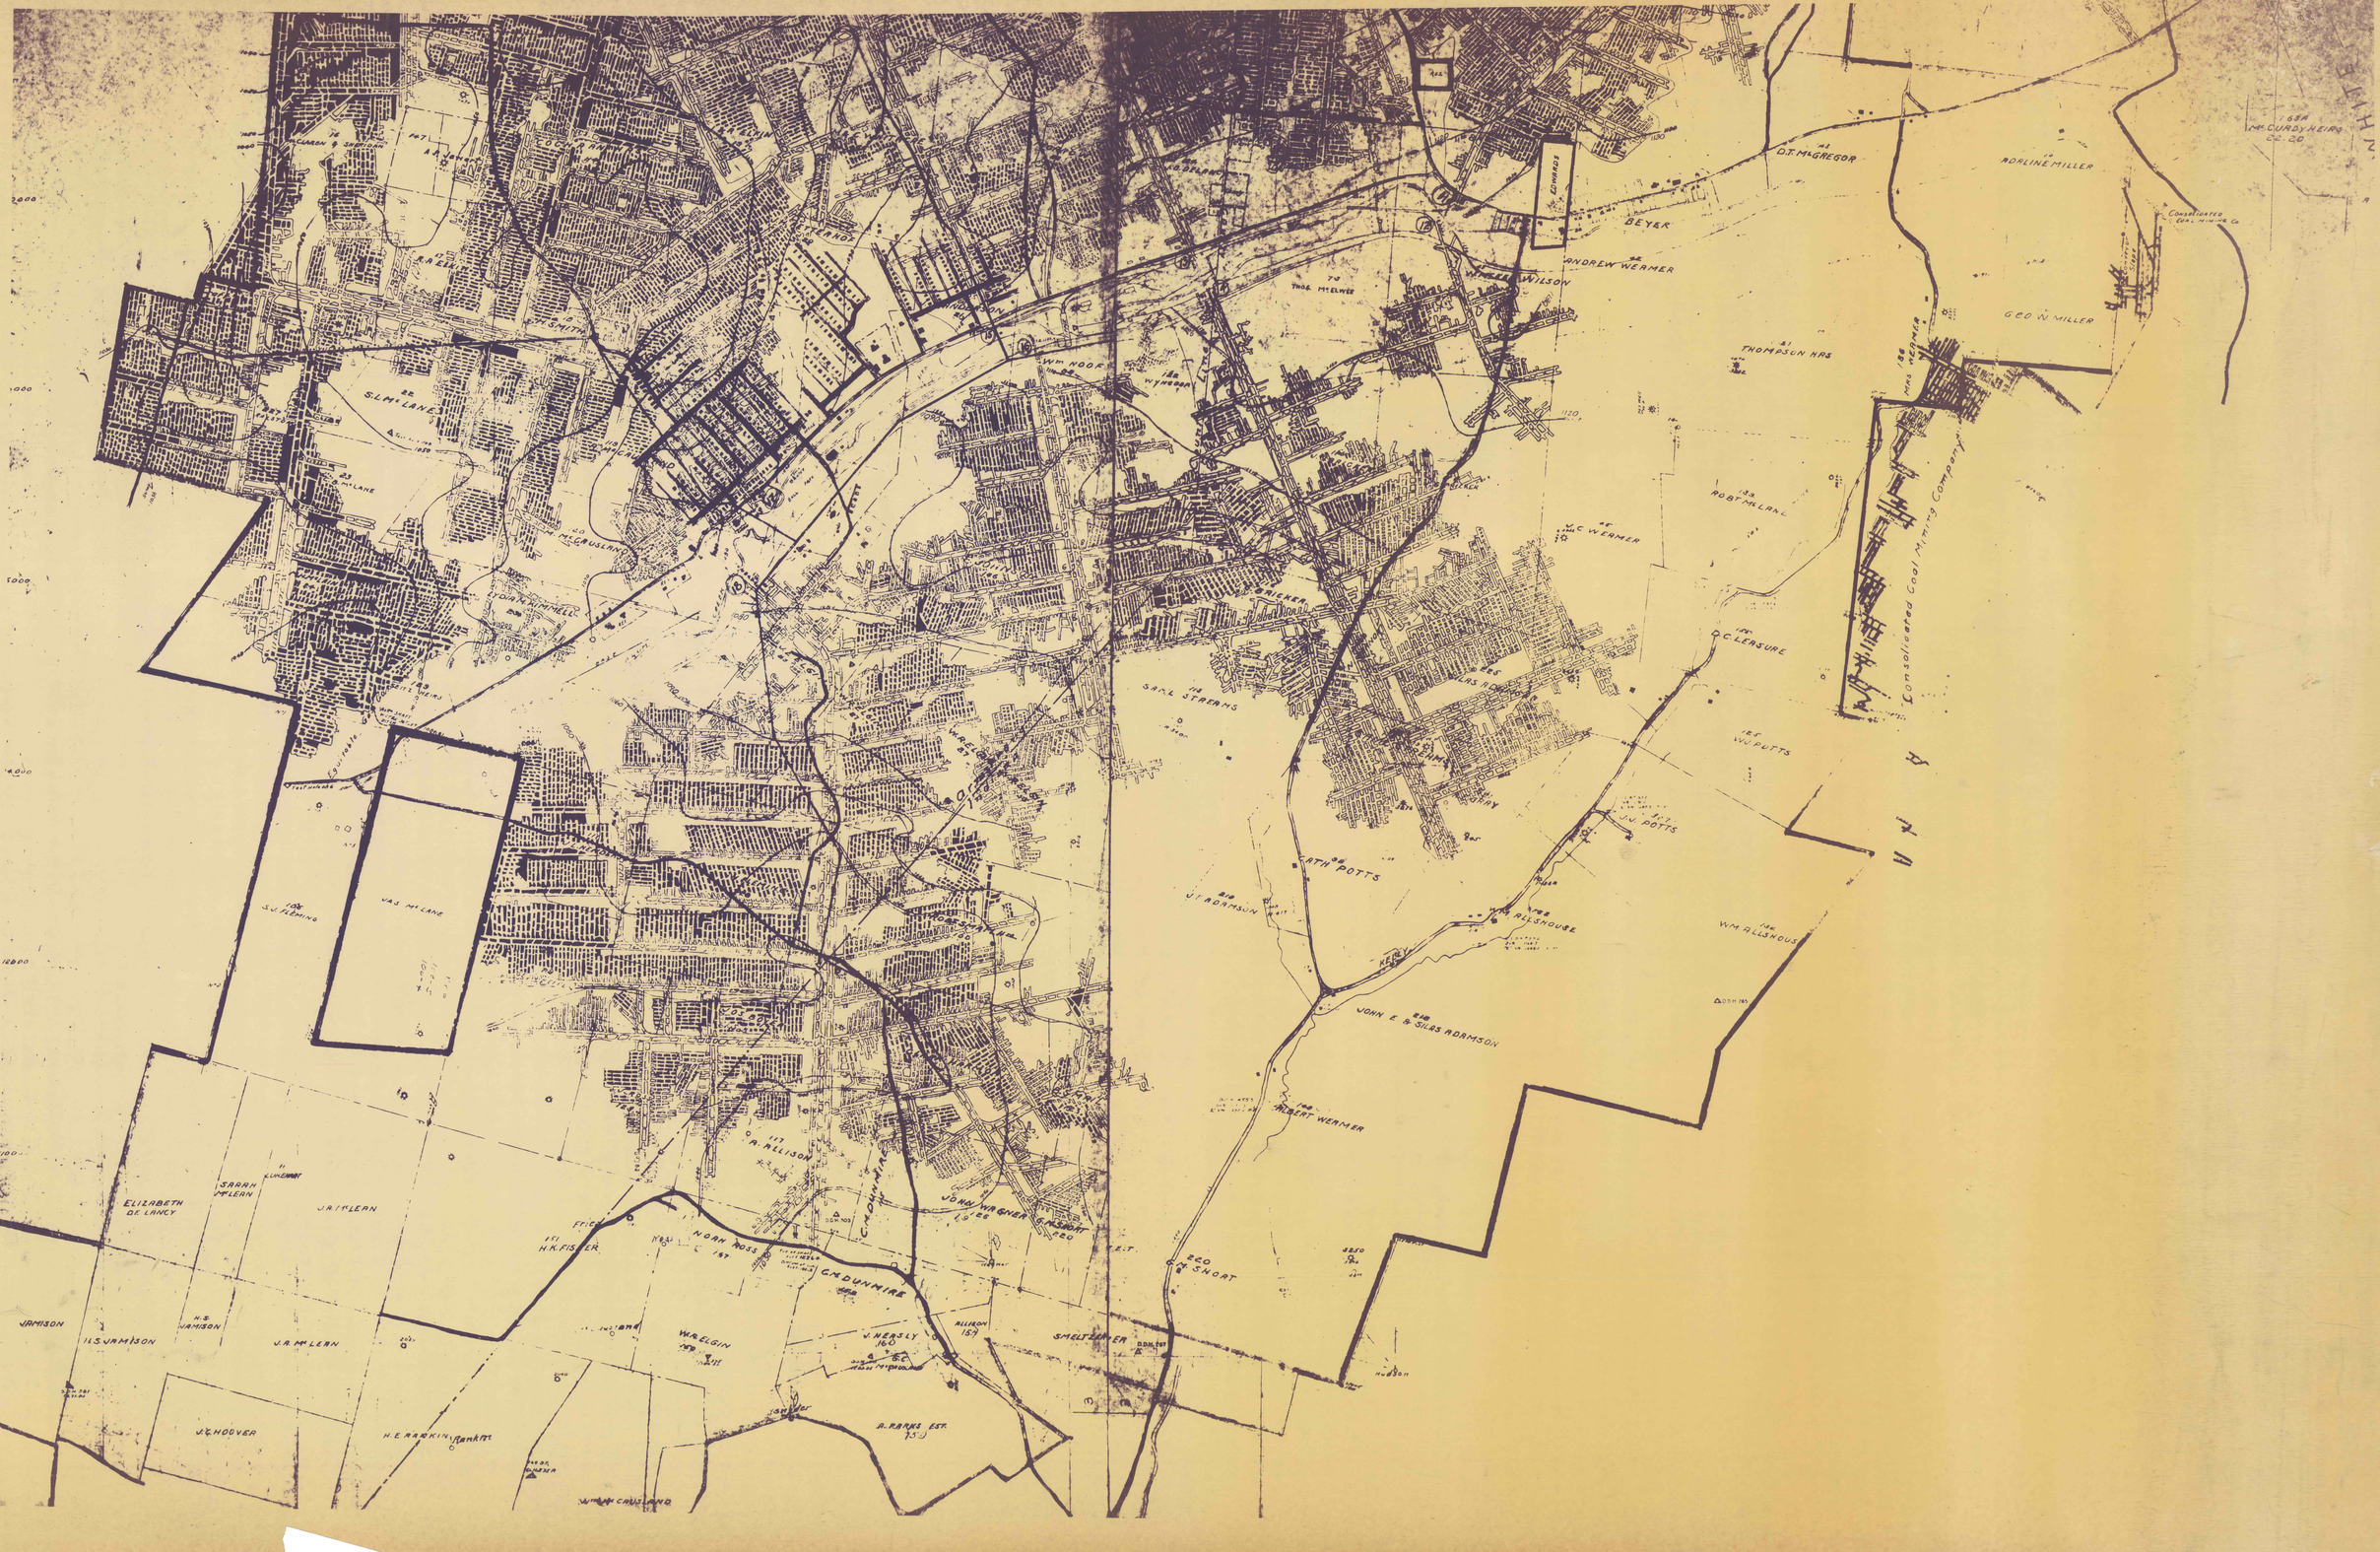

Consolidated Coal Mining Company
D.T. McGREGOR
ADALINE MILLER
BEYER
ANDREW WEAMER
WILSON
THOMPSON HRS
GEO W MILLER
ROBT McLANE
J.C. WEAMER
D.C. LEASURE
W.J. POTTS
J.J. POTTS
CATH POTTS
J.F. ADAMSON
W.M. ALLSHOUSE
JOHN E. & SILAS ADAMSON
ALBERT WEAMER
SAML STREAMS
BRICKER
Wm HOOF
S.L. McLANE
LYDIA M. KIMMELL
JAS McLANE
S.J. FLEMING
ELIZABETH DE LANCY
SARAH McLEAN
J.A. McLEAN
JAMISON
H.S. JAMISON
J.A. McLEAN
J.C. HOOVER
H.E. RARKIN
Rankin
W.R. ELGIN
H.K. FISHER
NOAH ROSS
C.M. DUNMIRE
J. HEASLY
A. PARKS EST.
A. ALLISON
JOHN WAGNER
SMELTZER
M. SHORT