


2000 ft. from top of 2000 ft. level

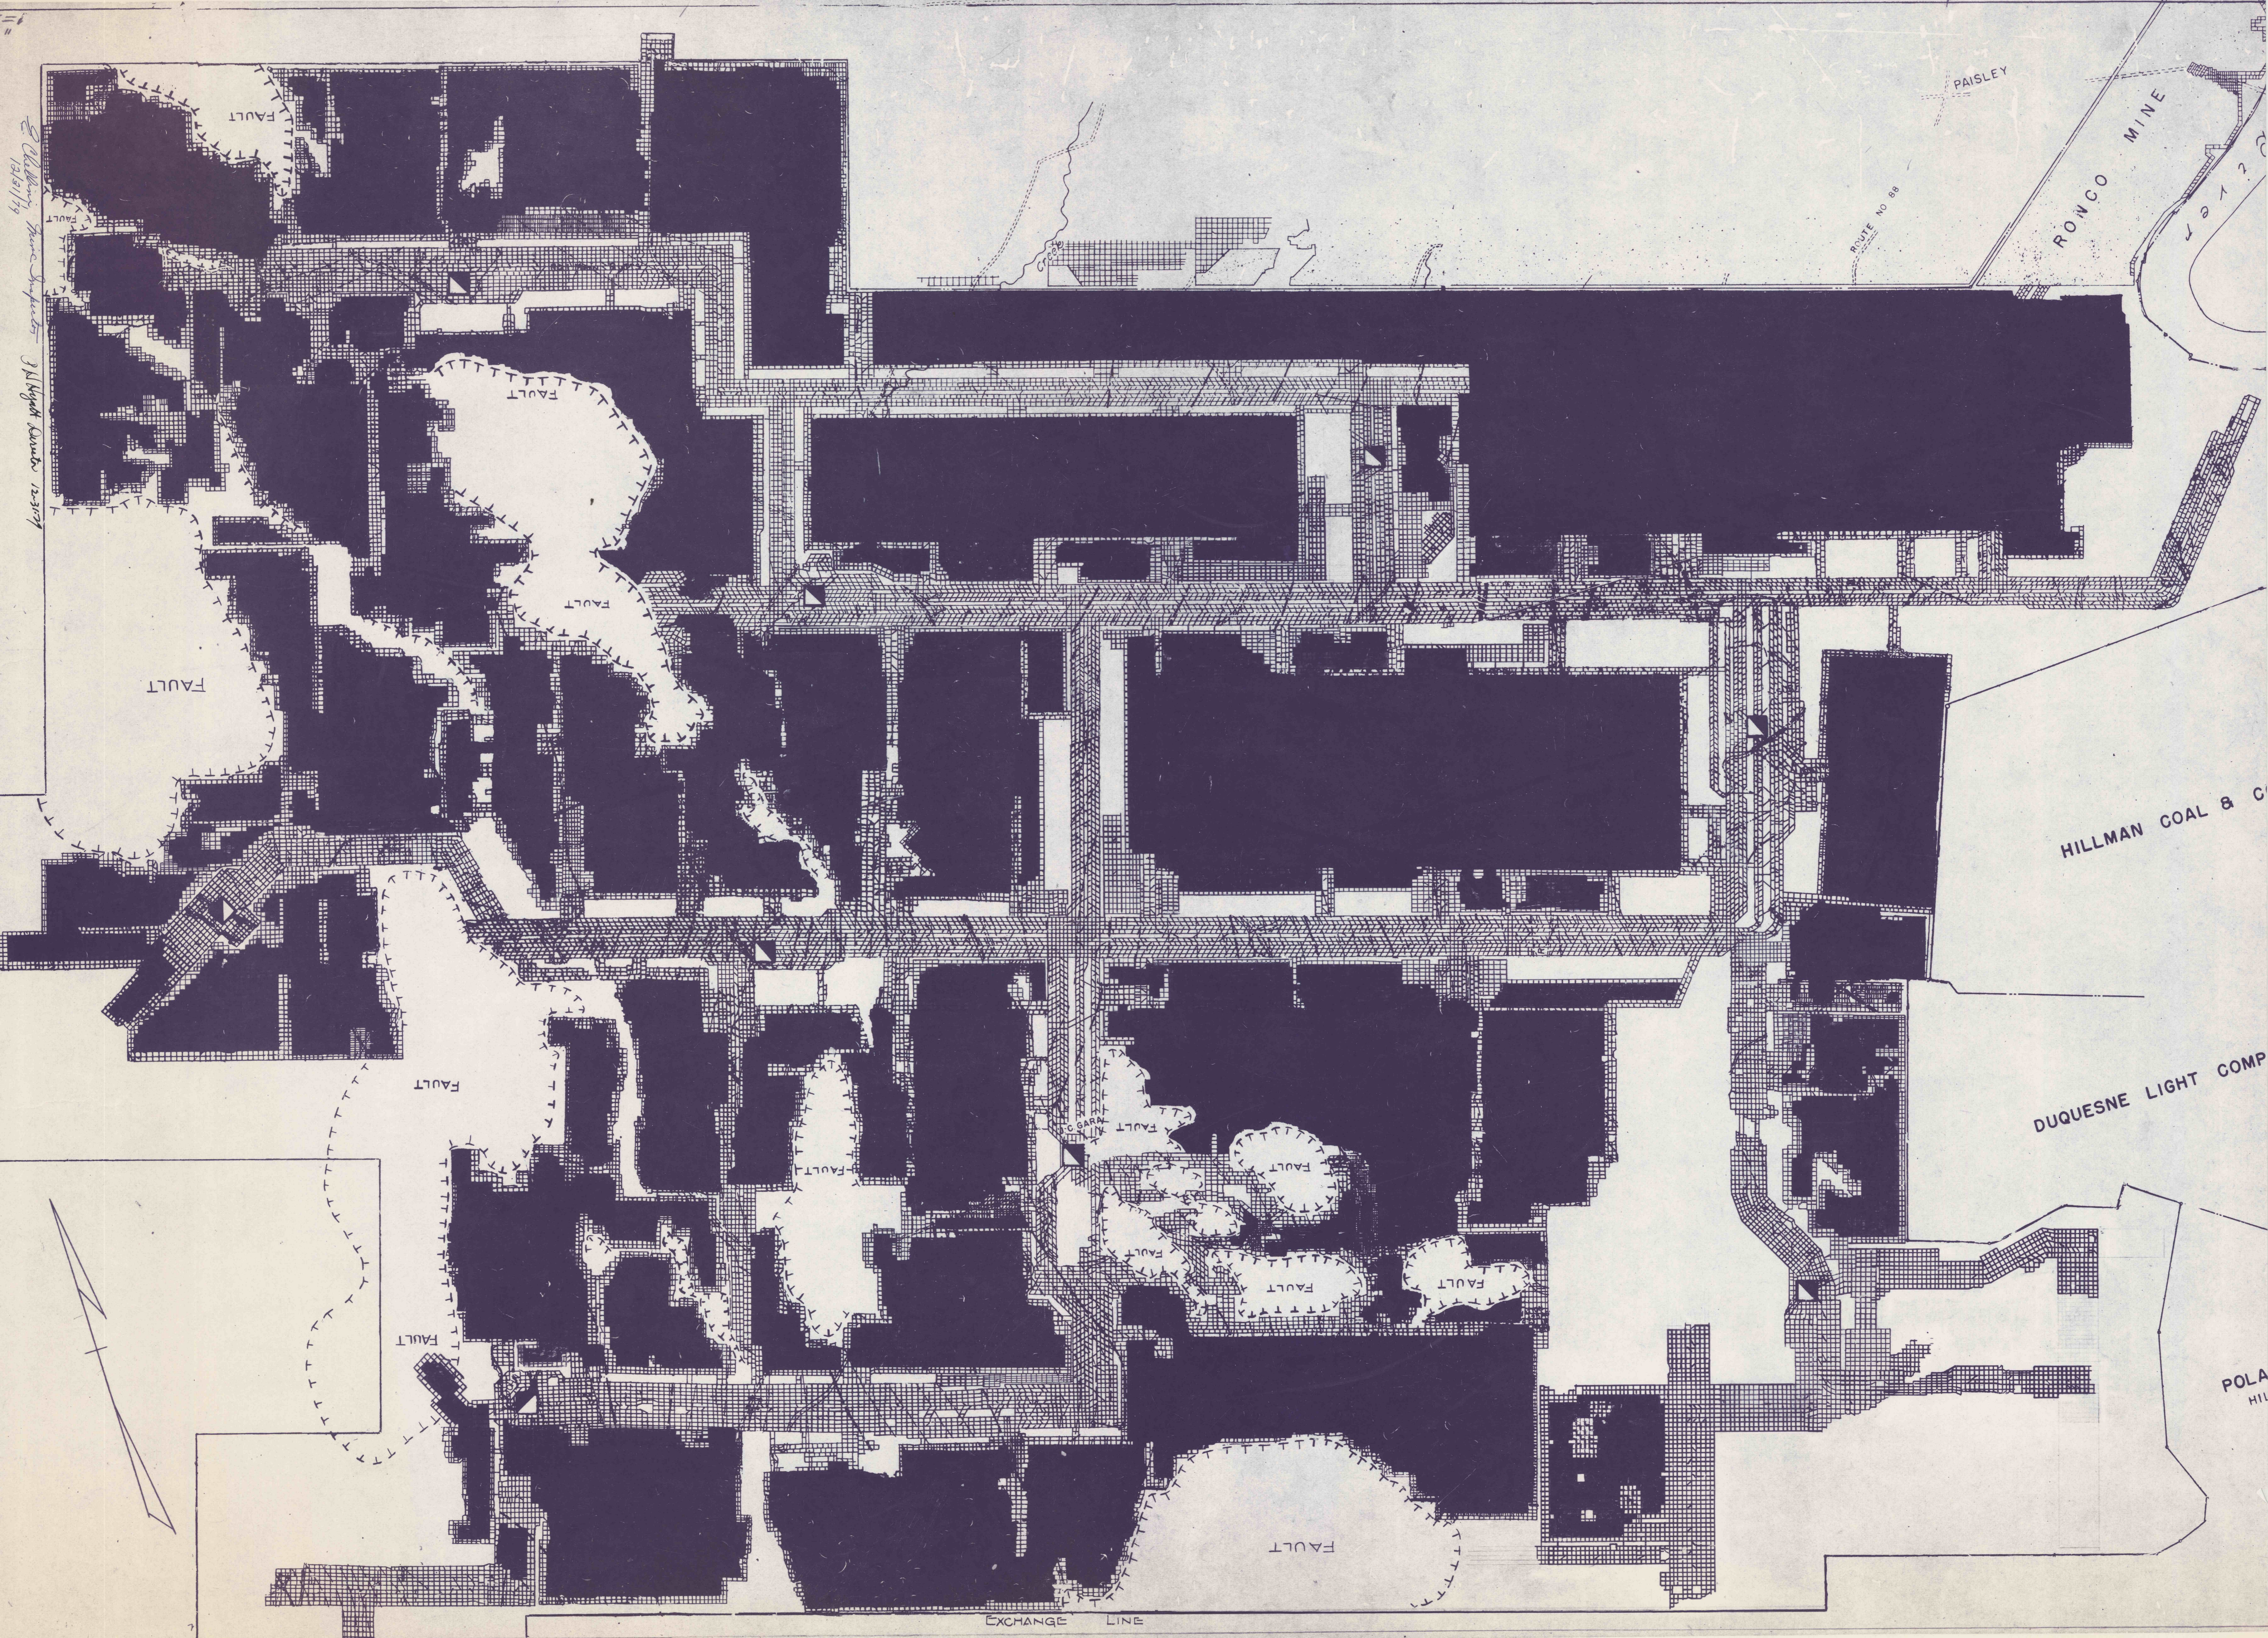

PAISLEY

ROUTE NO 88

ROWCO MINE

HILLMAN COAL & C

DUQUESNE LIGHT COMP

POLA
HIL

EXCHANGE LINE