


LEGEND  
BAND SAMPLES COLLECTED  
UNLESS INDICATED


- F - FLOOR
  - R - ROOF
  - RI - RIBS
  - DUST SAMPLES
  - N - NONE
  - T - TRACE
  - S - SMALL
  - L - LARGE
  - VL - VERY LARGE
- INDICATES  
AMOUNT  
OF COKE IN  
SAMPLES

2

8 LEFT

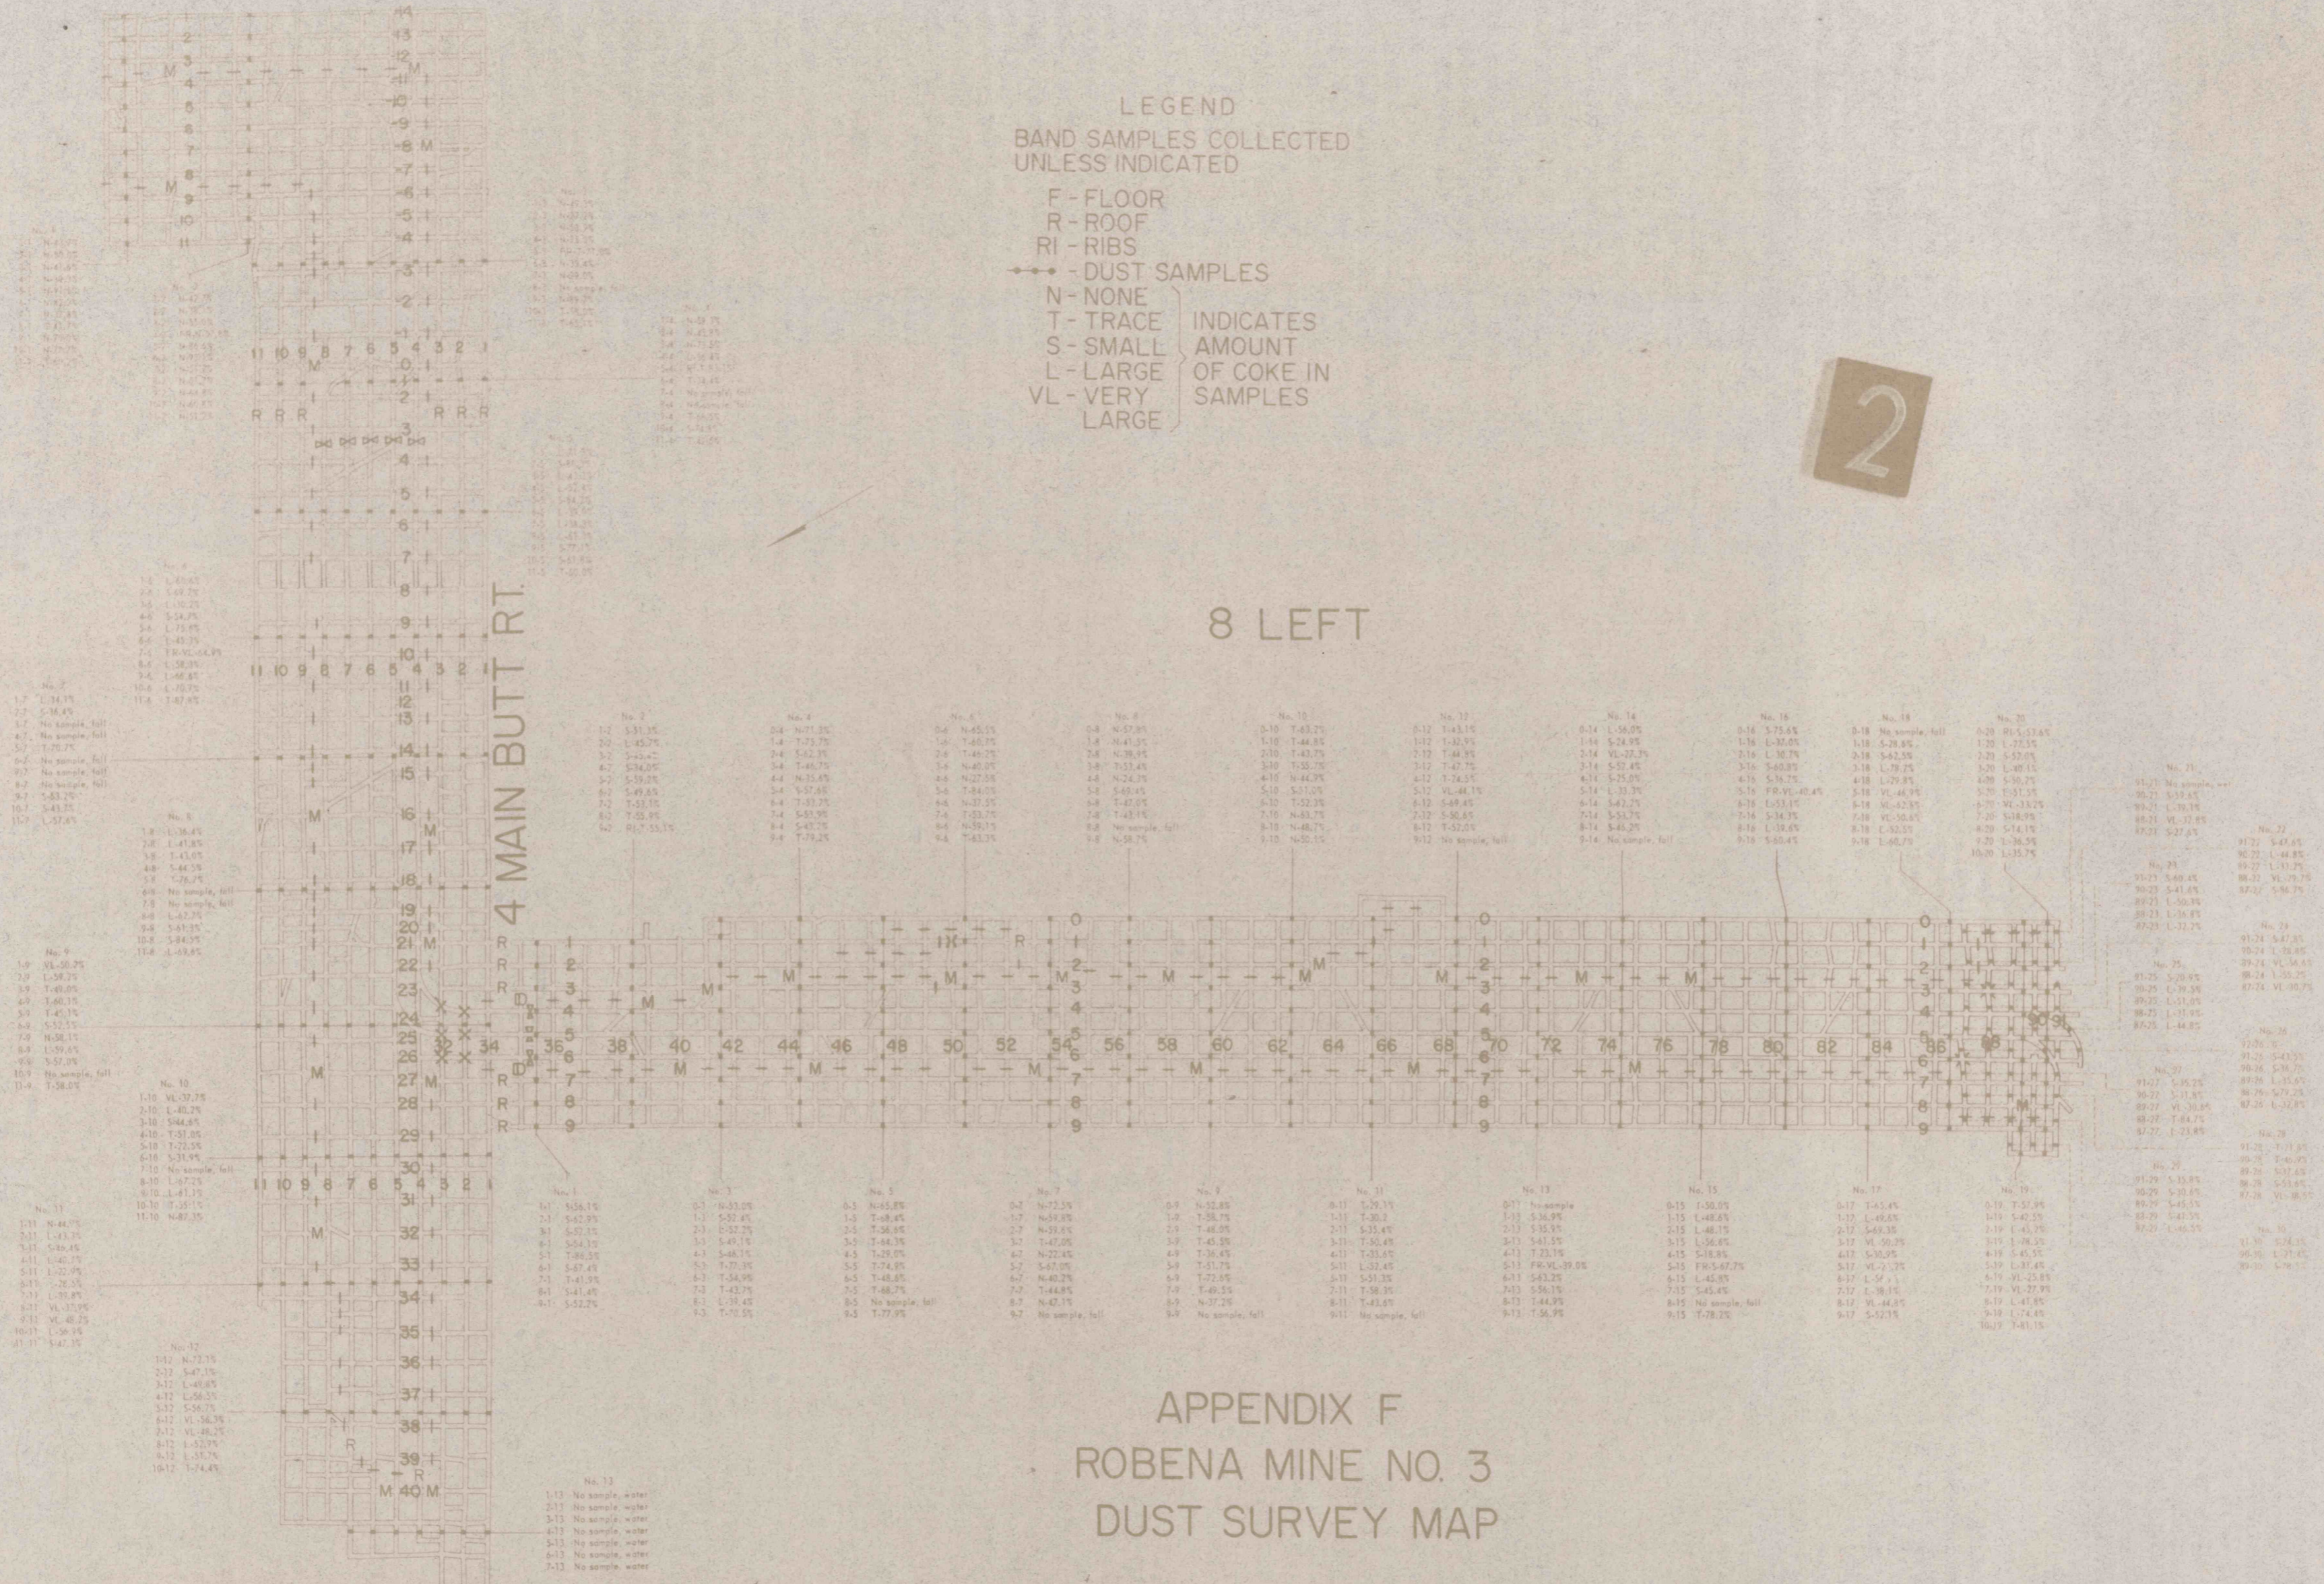

APPENDIX F  
ROBENA MINE NO. 3  
DUST SURVEY MAP

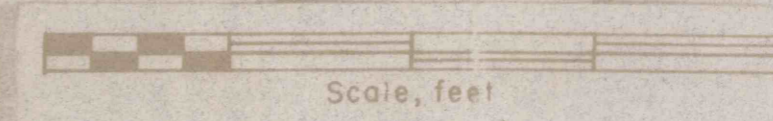

HS 2 03062 40.8 15X 322319