

1405
C-79"

12

11

10

9

8

7

6

5

4

3

2


1

4 - 87

1 - 87

S-239

House

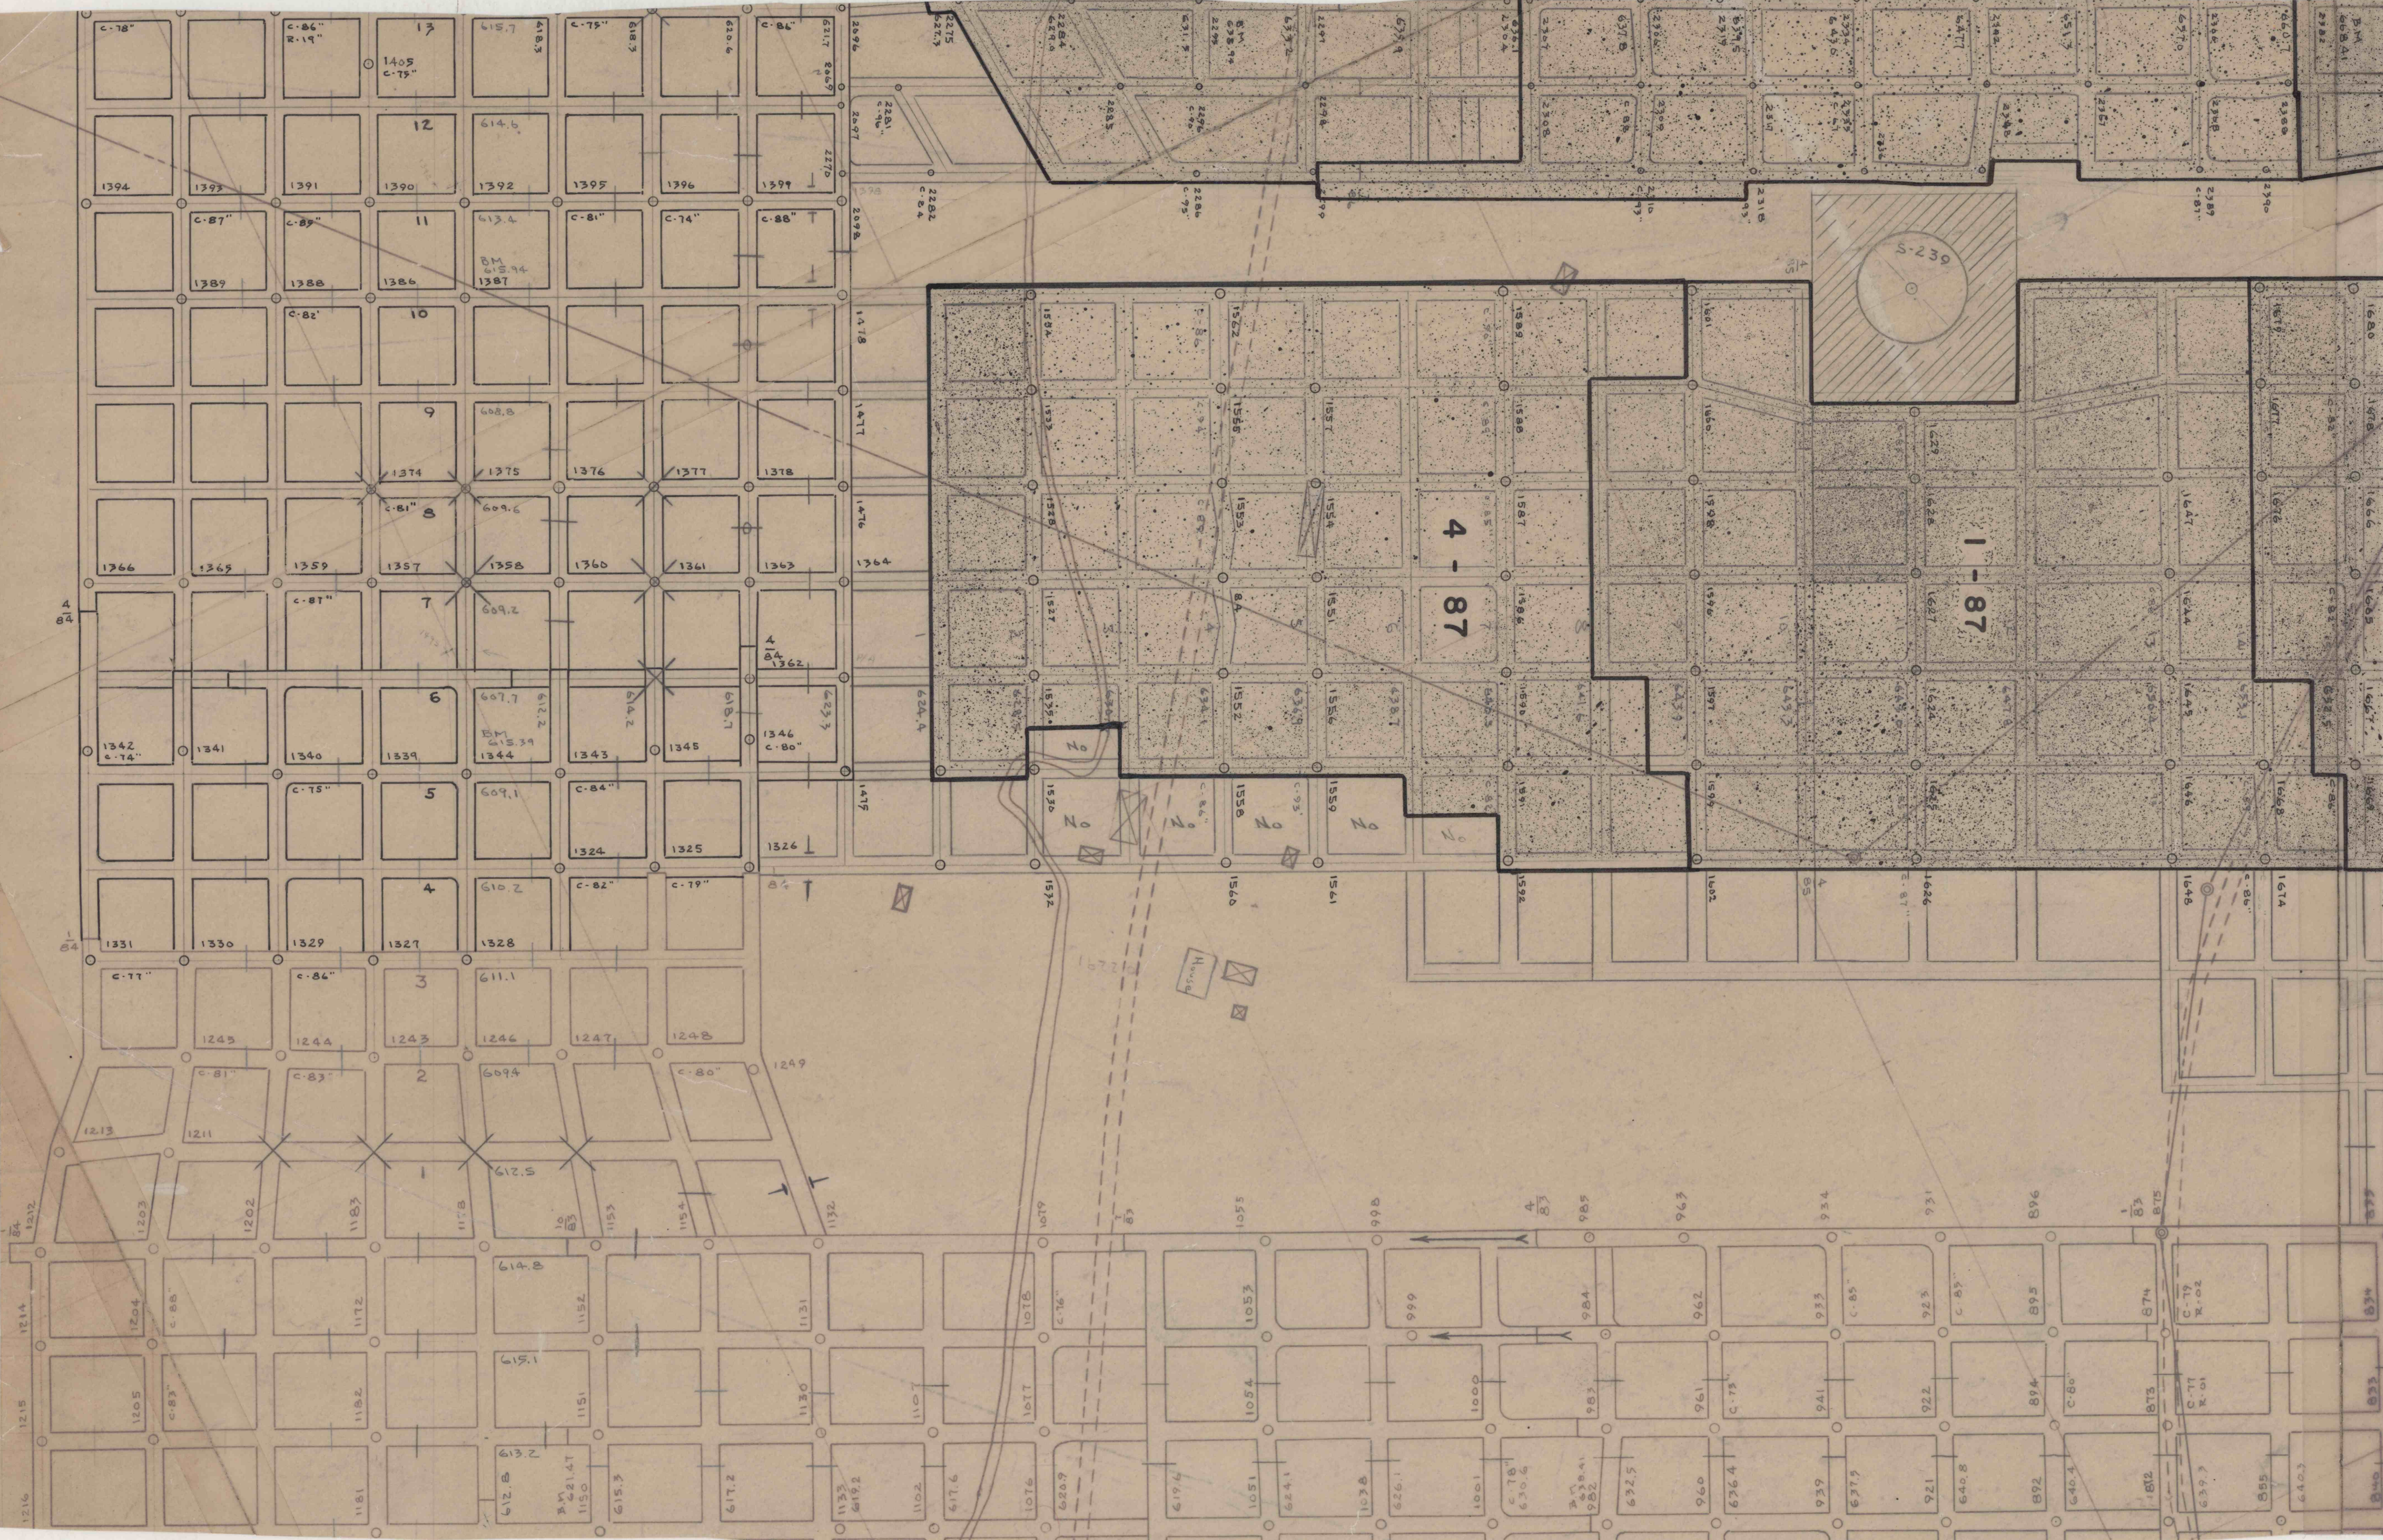

1405
C-79"

12

11

10

9

8

7

6

5

4

3

2

1

4 - 87

1 - 87

S-239

House