


MT. CARMEL COAL AND IRON CO. TRACT

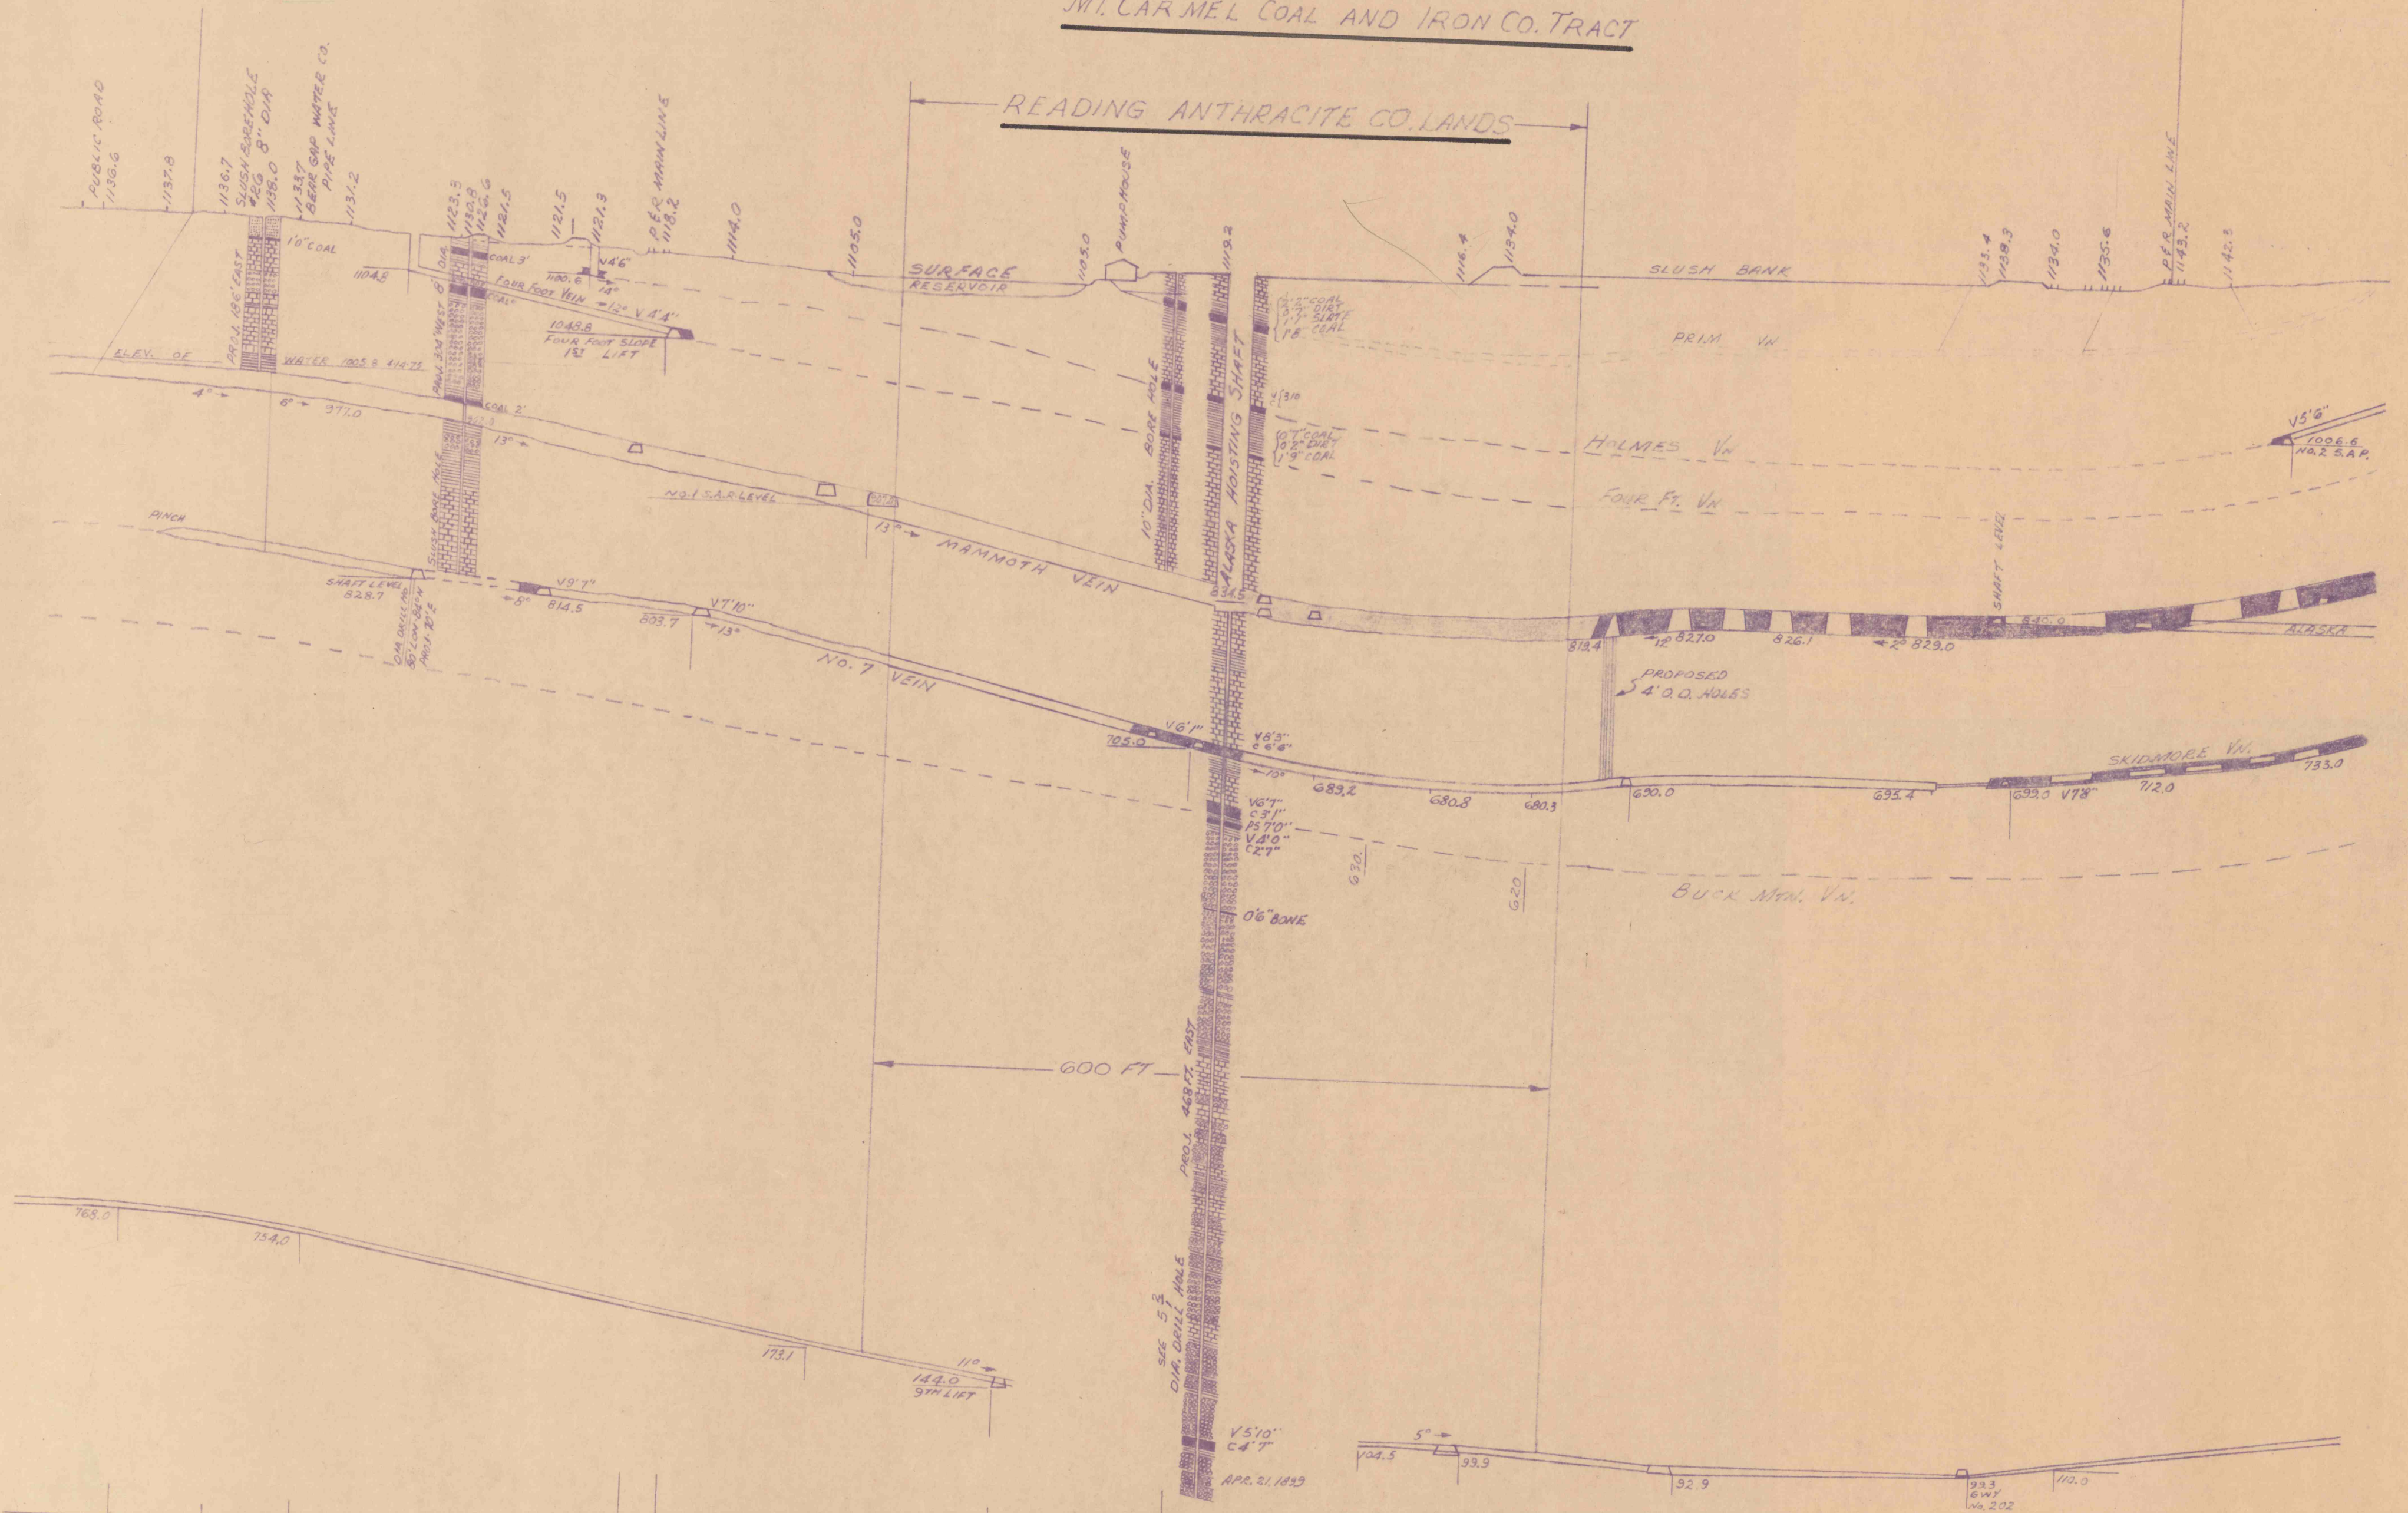

DATUM MID TIDE
WESTERN MIDDLE FIELD. ALASKA Colliery. 1"=100'. MT. CARMEL TWP.,
NORTHUMBERLAND COUNTY, PA.,

LOOKING EAST