


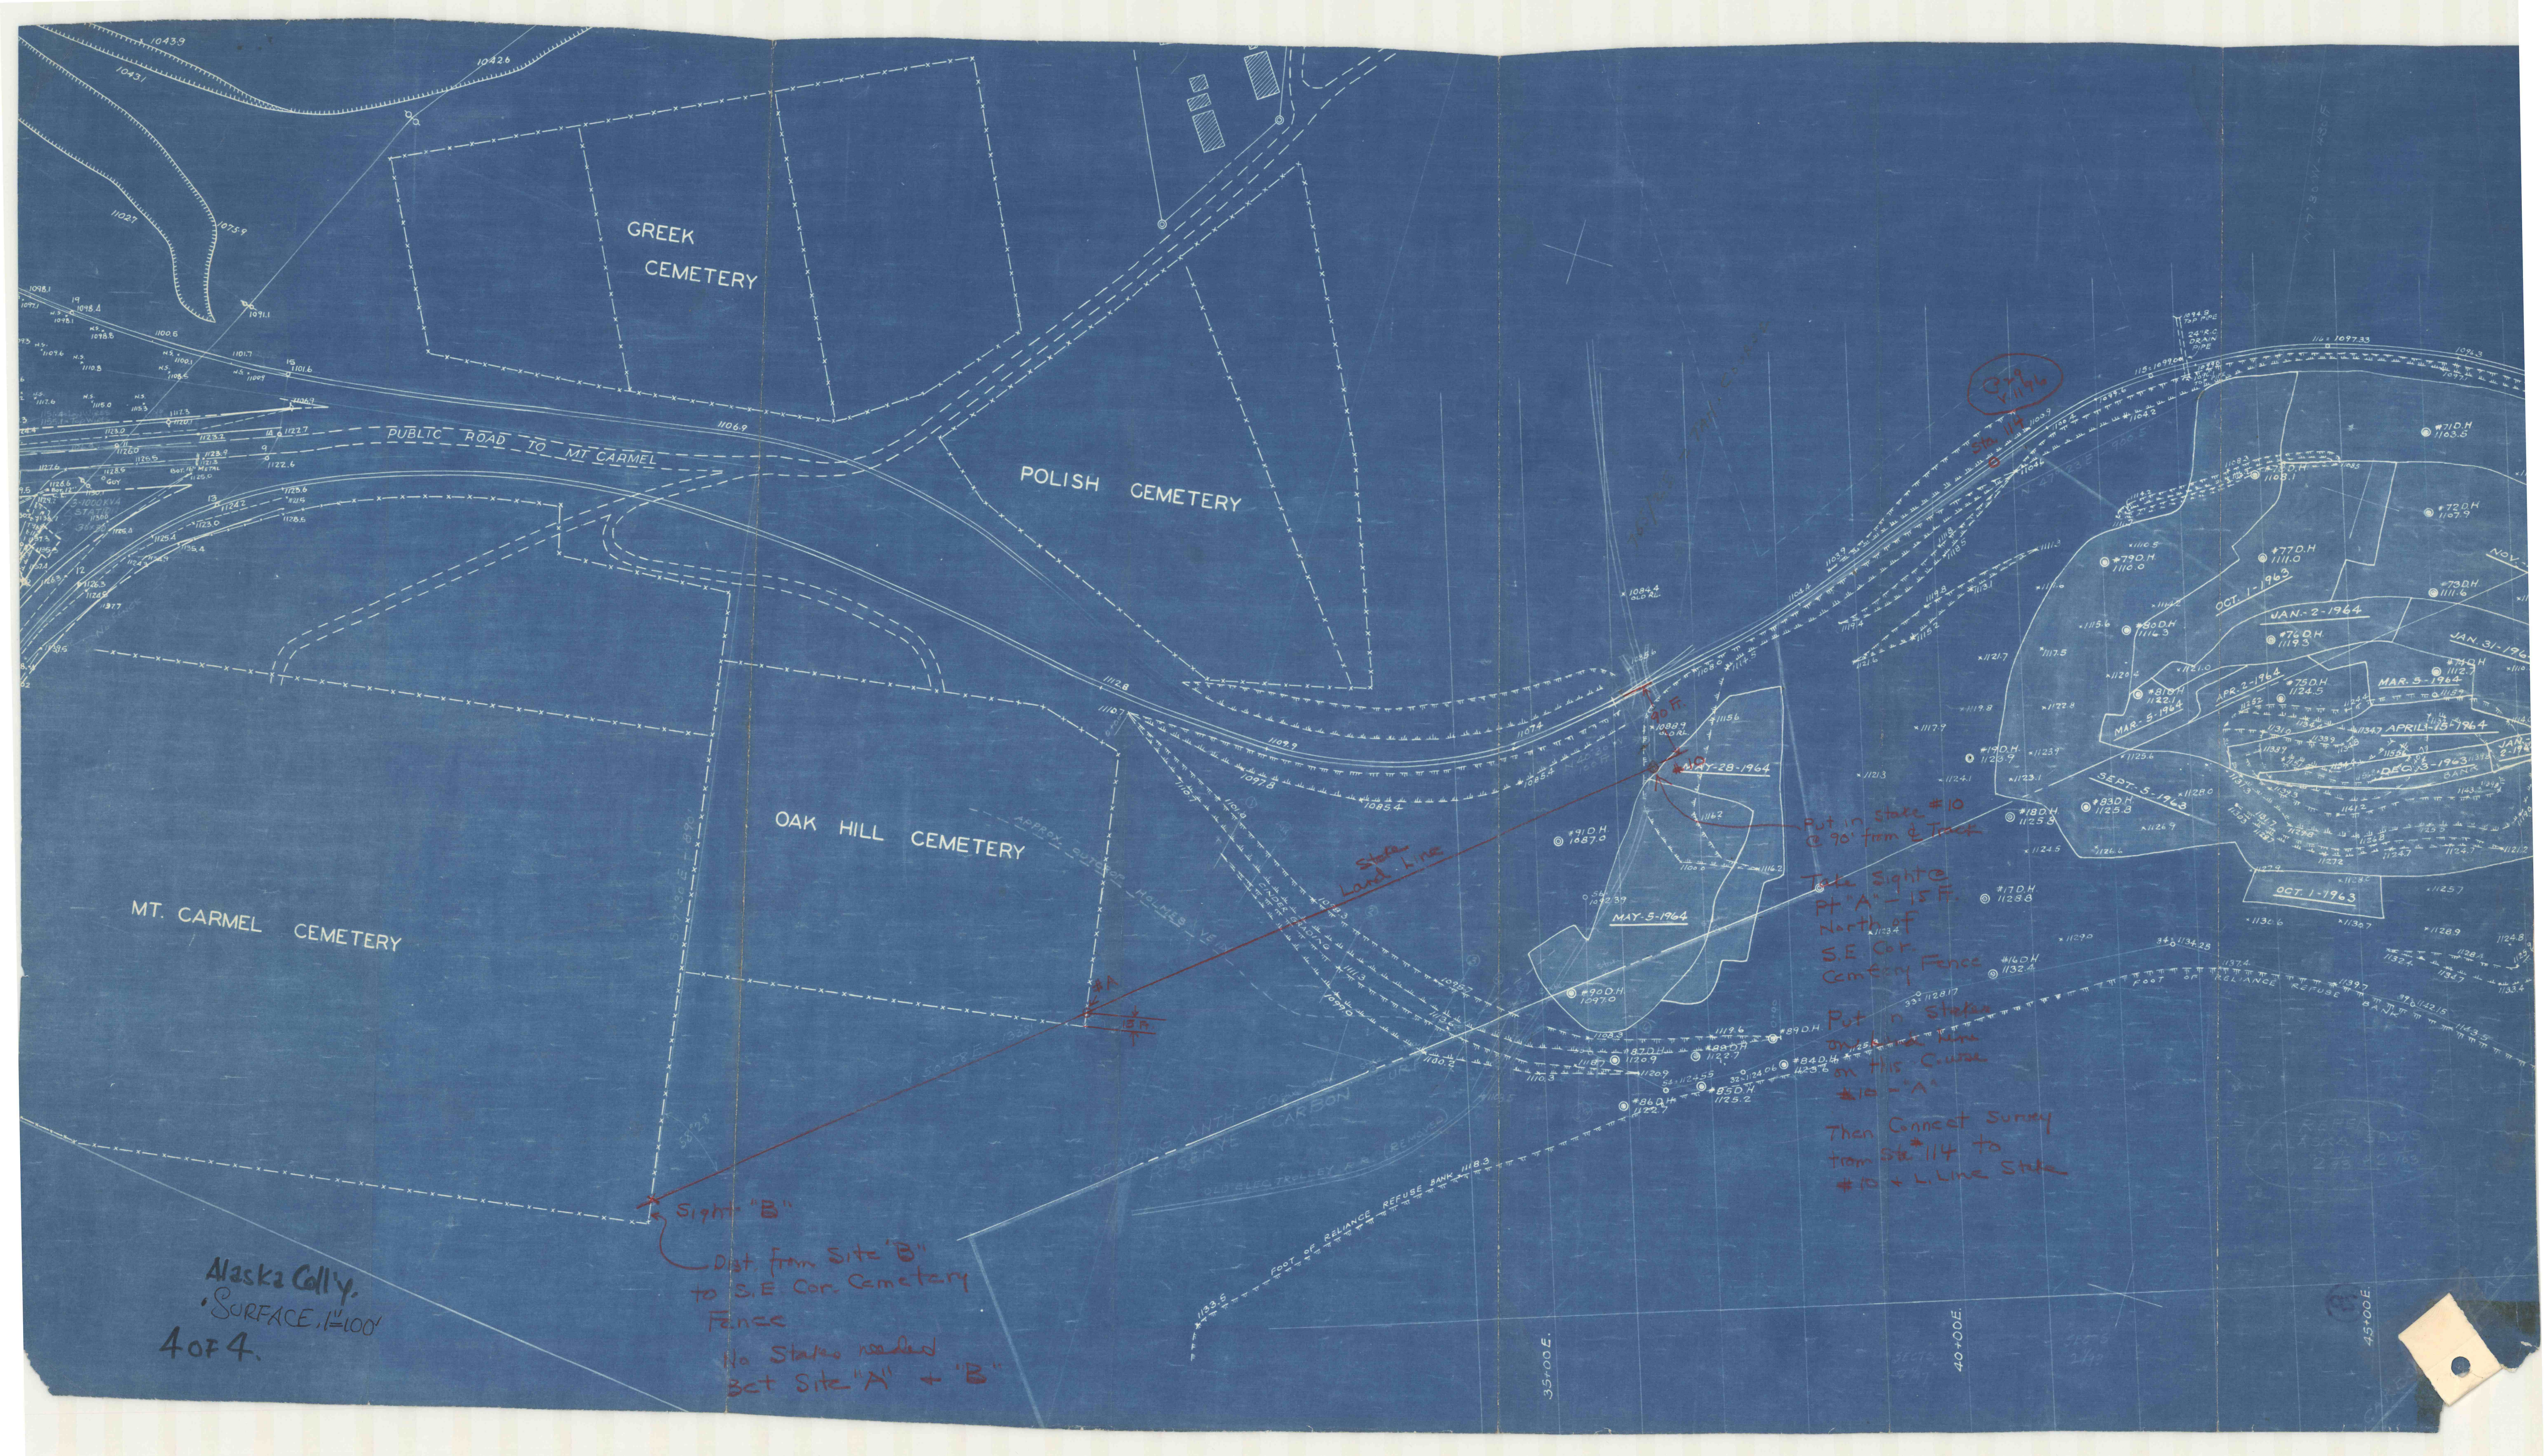

GREEK CEMETERY

POLISH CEMETERY

OAK HILL CEMETERY

MT. CARMEL CEMETERY

PUBLIC ROAD TO MT CARMEL

Site "B"

Dist. from Site "B" to S.E. Cor. Cemetery Fence

No Stakes needed bet Site "A" + "B"

Alaska Coll'y.
SURFACE, 1"=100'
4 of 4.

Put in stake #10 @ 90° from E. Track
Take sight @ Pt "A" - 15 ft. North of S.E. Cor. Cemetery Fence

Put in stake on this course #10 - "A"

Then Connect Survey from Sta #14 to #10 + L. Line Stake

MAY 28-1964

MAY 5-1964

OCT 1-1962

JAN 2-1964

APR 2-1964

MAR 5-1964

APR 15-1964

SEPT 5-1963

JAN 31-1964

JAN 2-1964

JAN 31-1964

JAN 31-1964

