


APR 7 1961
M.F.

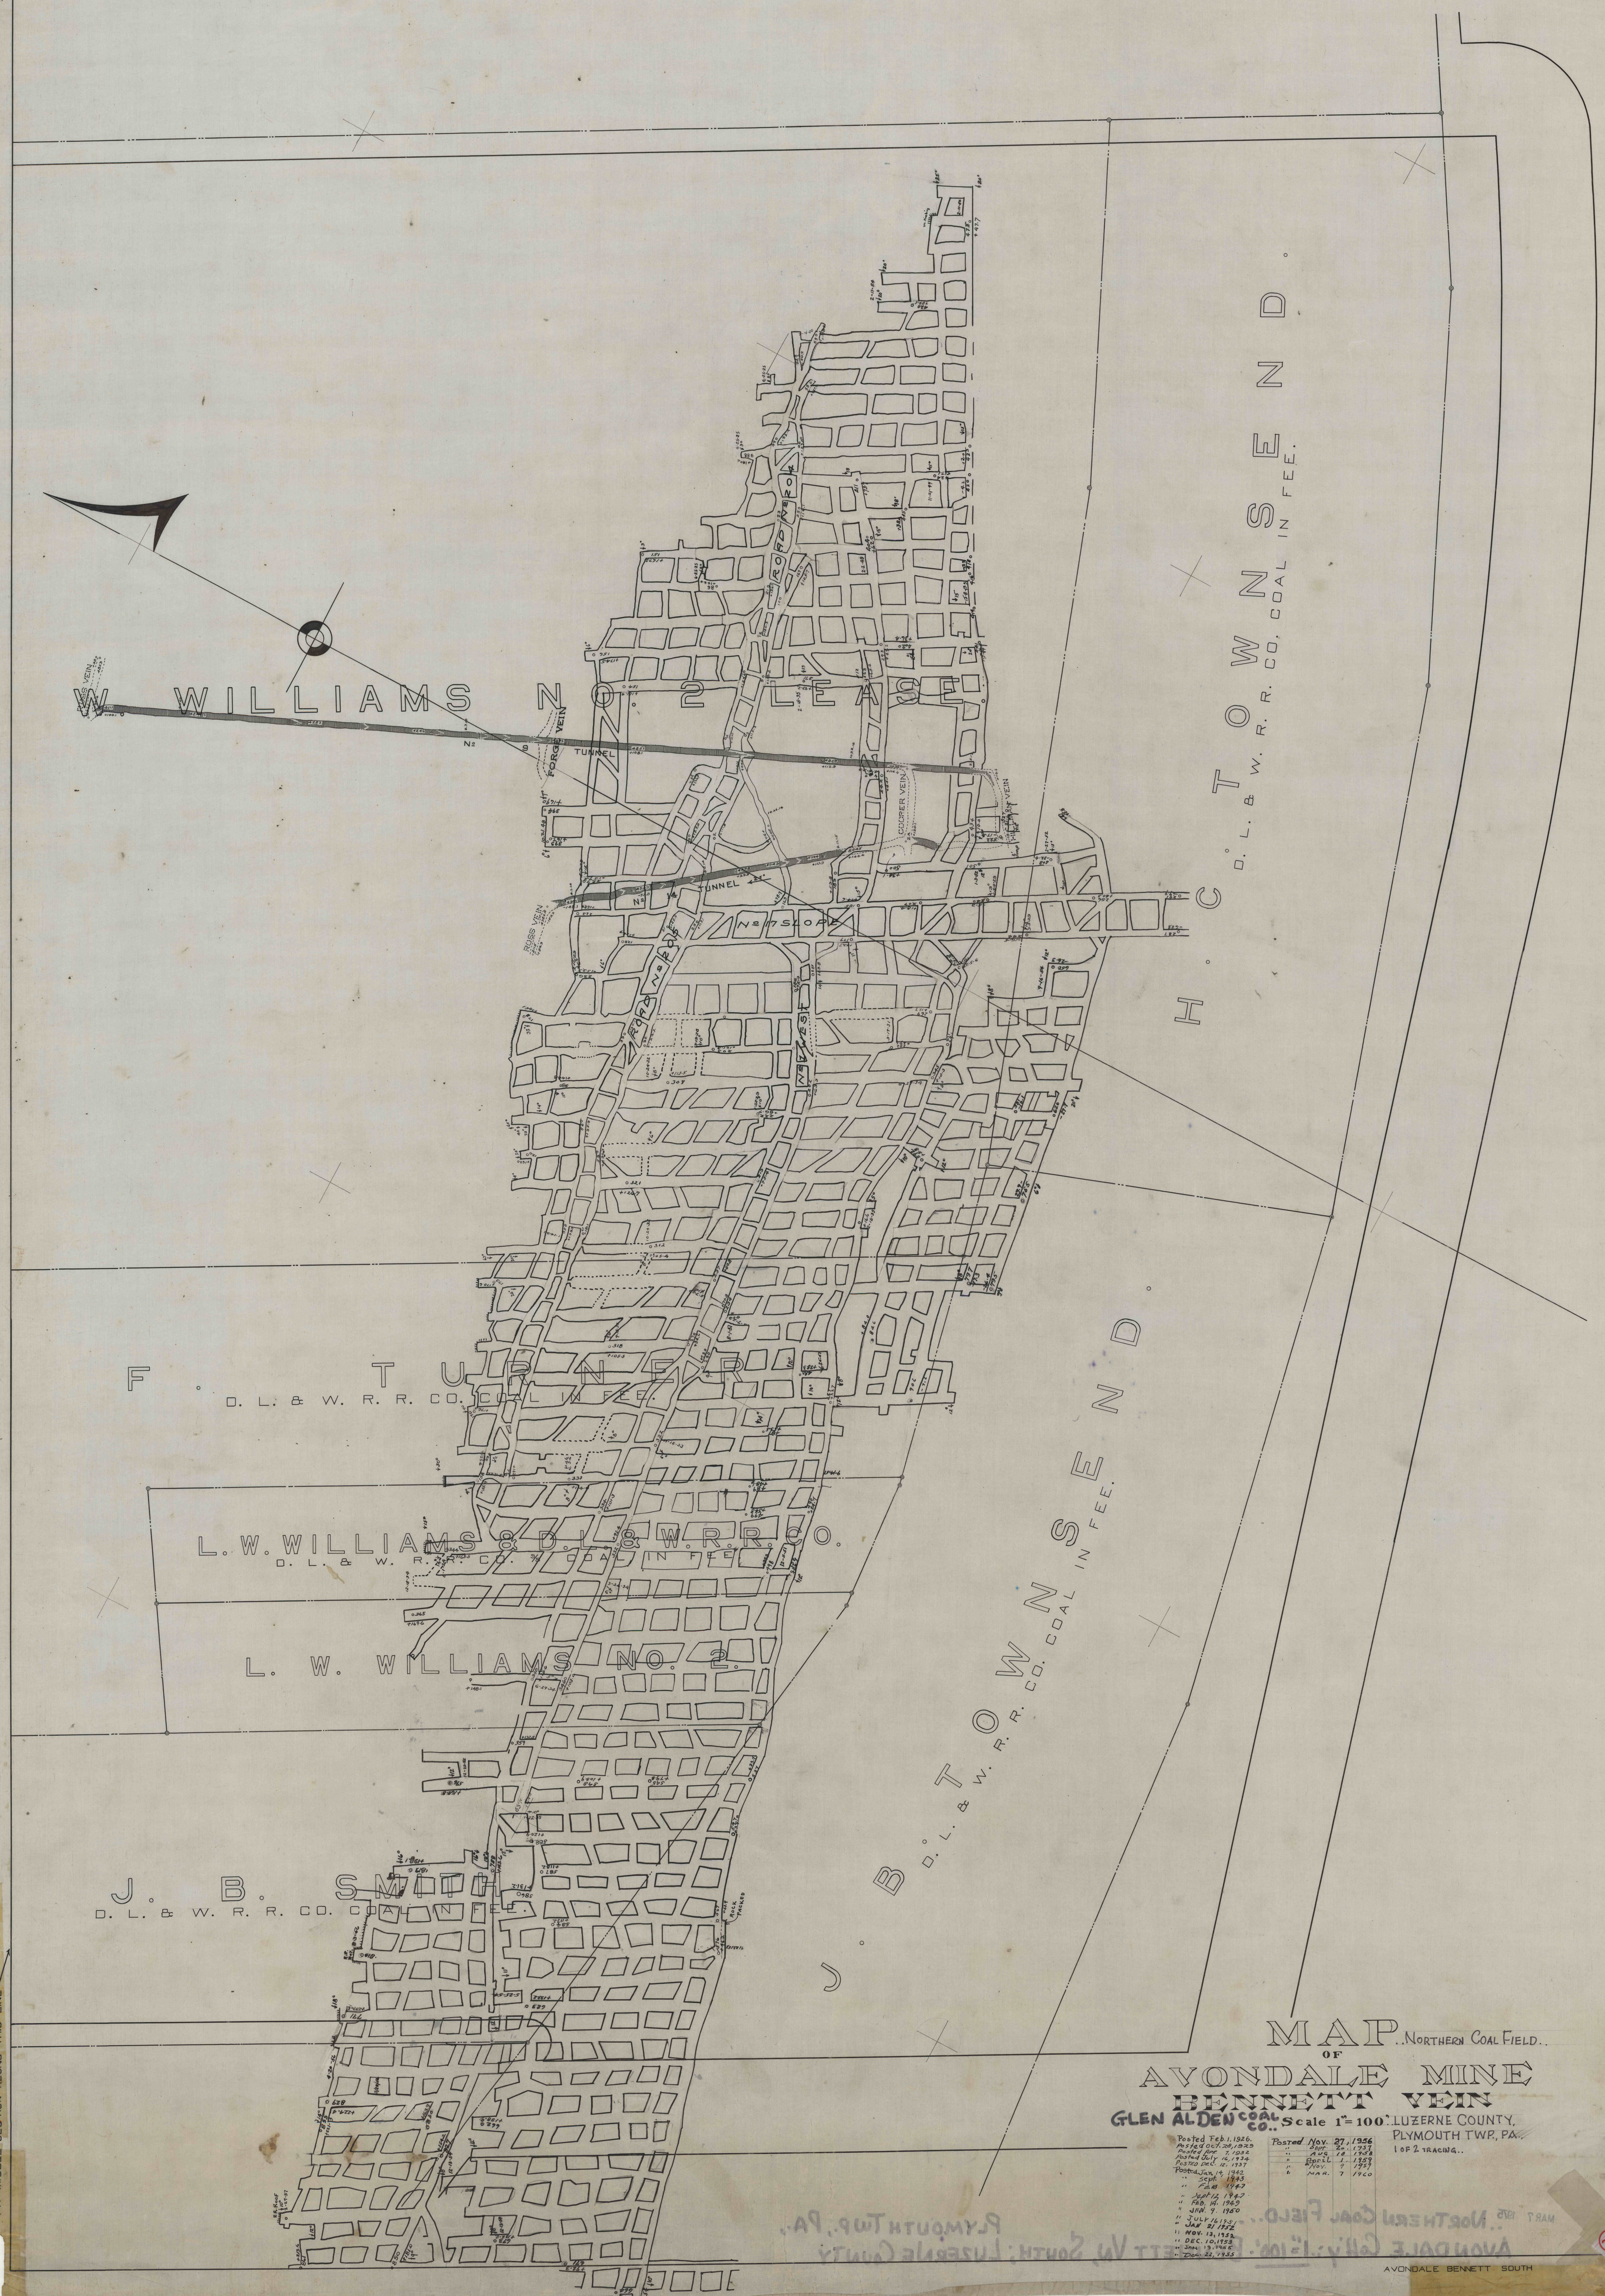

— FIT MIDDLE SECTION ALONG THIS LINE —

MAP OF NORTHERN COAL FIELD.
AVONDALE MINE
BENNETT VEIN
GLEN ALDEN CO. Scale 1"=100' LUZERNE COUNTY,
PLYMOUTH TWP., PA.
Posted Feb. 1, 1926. Printed Nov. 27, 1926.

ALDEN CO. Scale 1"=100'

Posted Feb. 1 1926
Ass'd Oct. 20, 1929
Posted Apr. 7, 1932
Ass'd Jan. 12, 1934
Posted Dec. 12, 1937
Posted Jan. 14, 1940
" Feb. 1942
" Sept. 1942
" Feb. 1943
" JPR. 7, 1950
" JULY 16, 1953
" " 21, 1952
" NOV. 12, 1952
" DEC. 10, 1953
" JAH. 1, 1946
" JAH. 27, 1945


AVONDALE BENNETT SOUTH