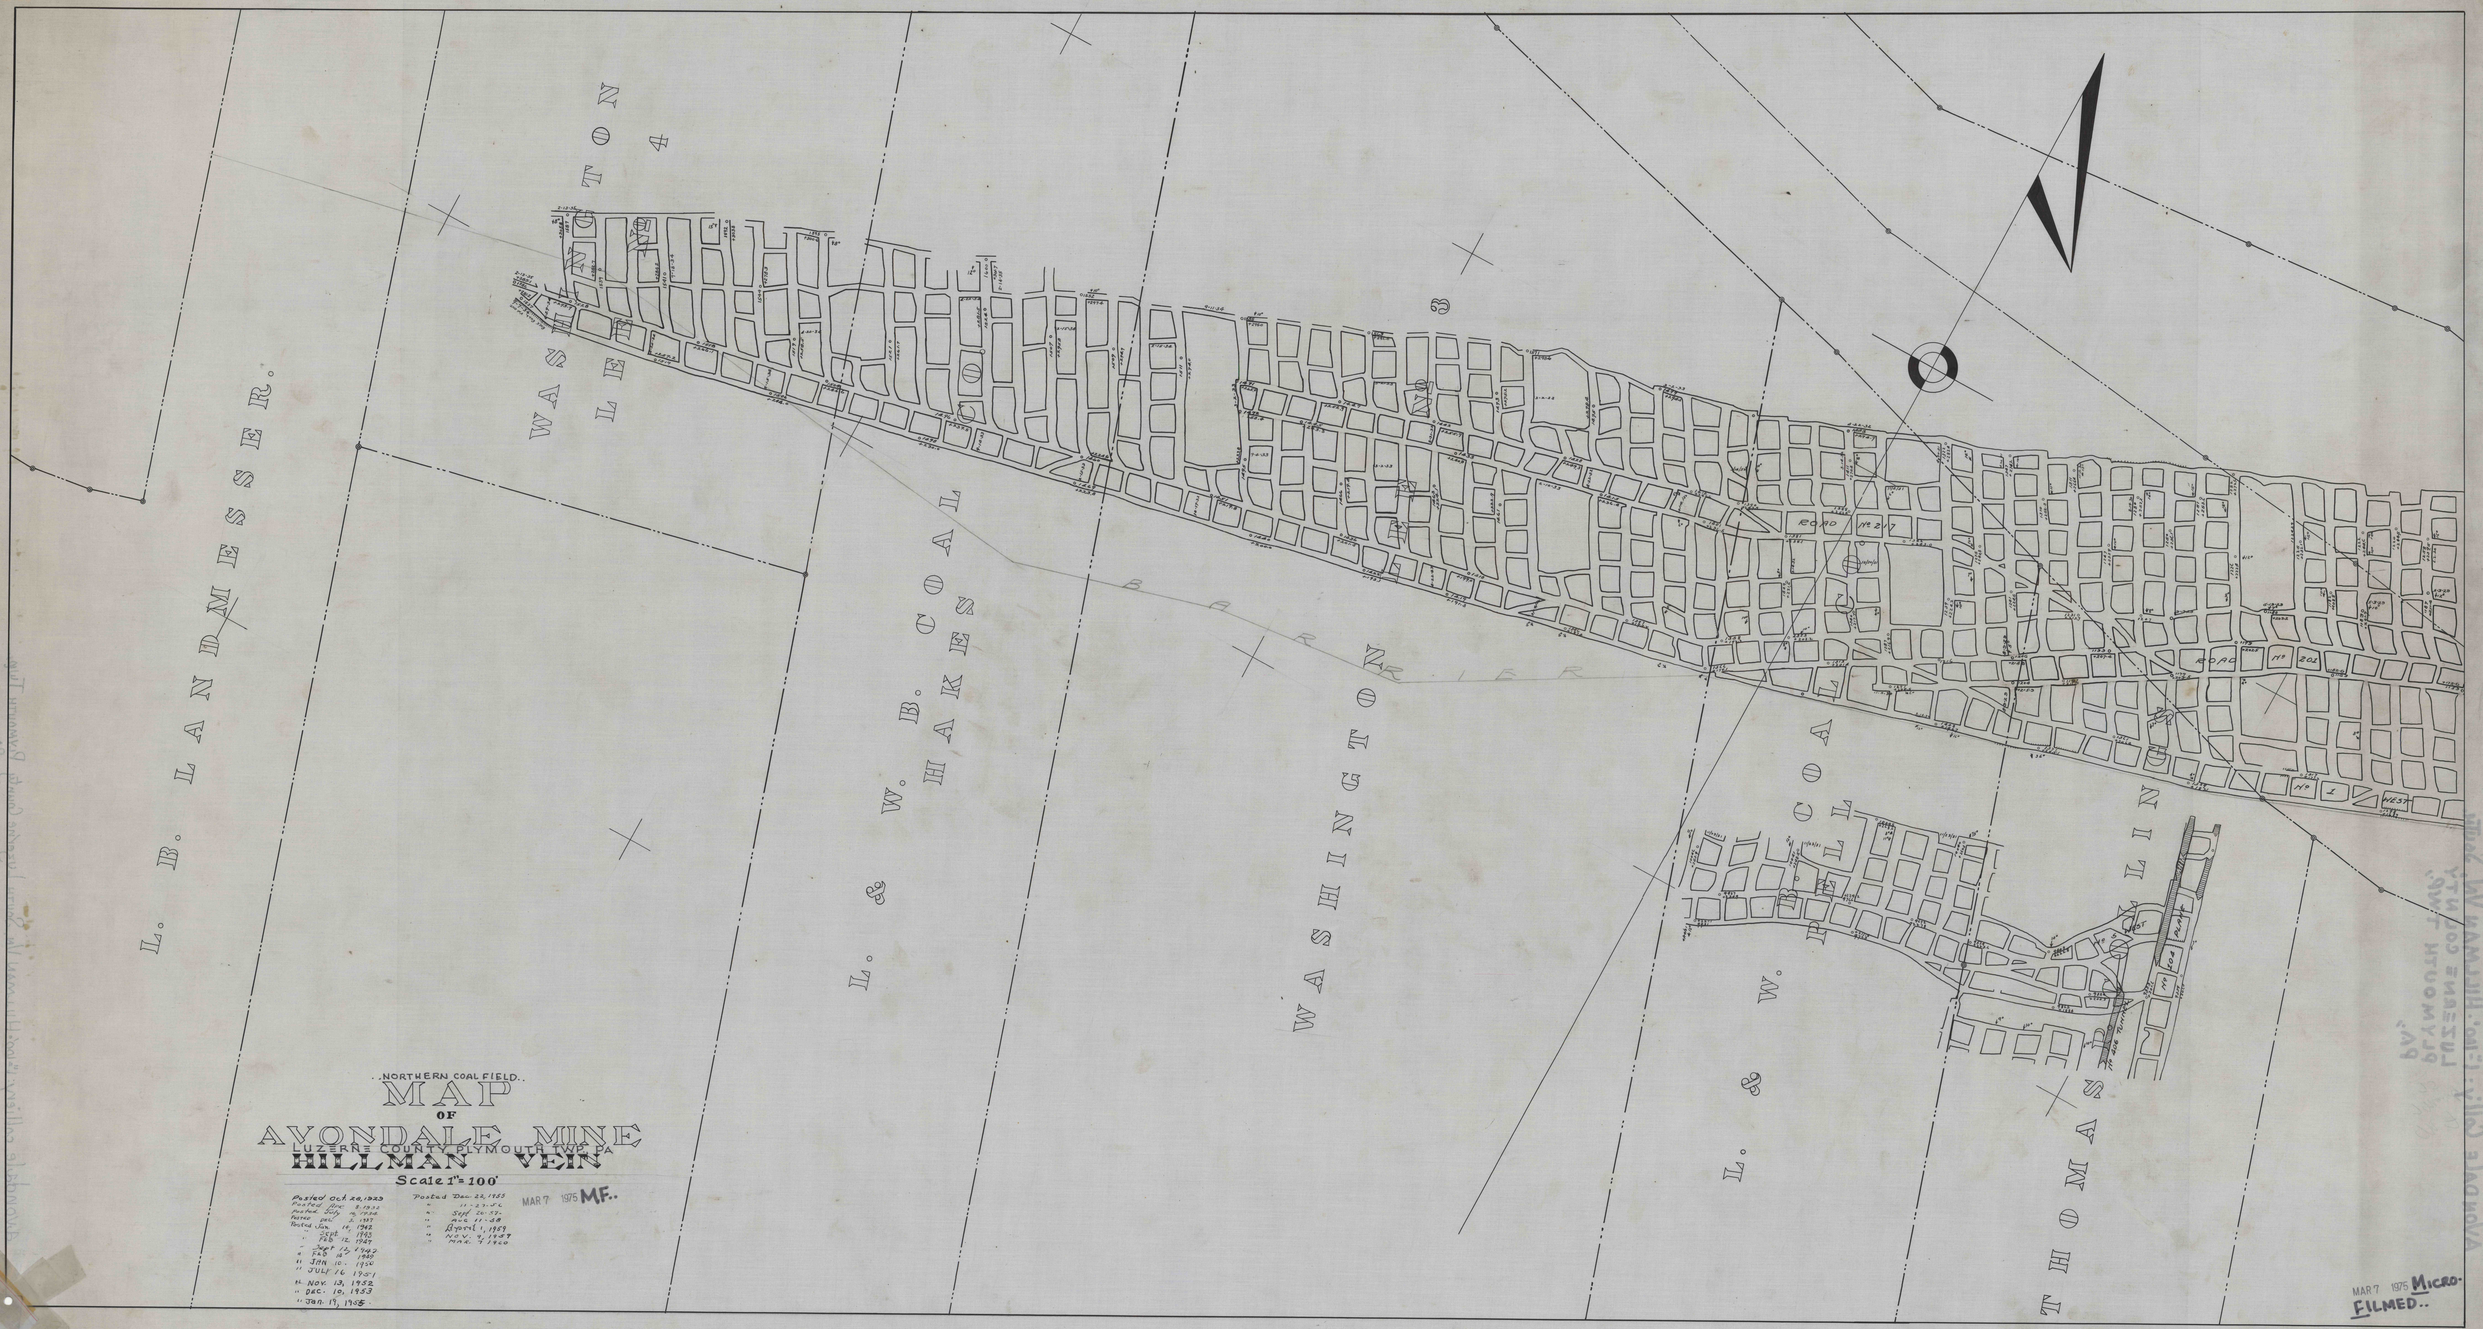

NORTHERN COAL FIELD
MAP
OF
AVONDALE MINE
LUZERNE COUNTY PLYMOUTH TWP. PA
HILLMAN VEIN
Scale 1" = 100'
Posted Oct. 20, 1923
Posted Apr. 8, 1932
Posted July 9, 1934
Posted Dec. 5, 1937
Posted Jan. 14, 1942
" Sept. 1, 1943
" Feb. 12, 1947
" Sept. 12, 1947
" Feb. 13, 1948
" Jan. 10, 1950
" July 16, 1951
" Nov. 13, 1952
" Dec. 10, 1953
" Jan. 19, 1955
Posted Dec. 22, 1955
" 11-27-56
" Sept. 20, 57
" Aug. 11, 58
" April 1, 1959
" Nov. 9, 1959
" Mar. 7, 1960
MAR 7 1975 MF.
L. B. LANDMESSER.
WASHINGTON
L. & W. B. COAL CO.
HAKES
WASHINGTON
L. & W. B. COAL CO.
PELL
THOMAS
BARRIER
ROAD No 217
ROAD No 201
No 1 WEST
No 204 PLANE
MAR 7 1975 MICRO-FILMED.