


AVONDALE RED ASH

AVONDALE CORP. 1:100 RED ASH

34

MART 1976 ME.

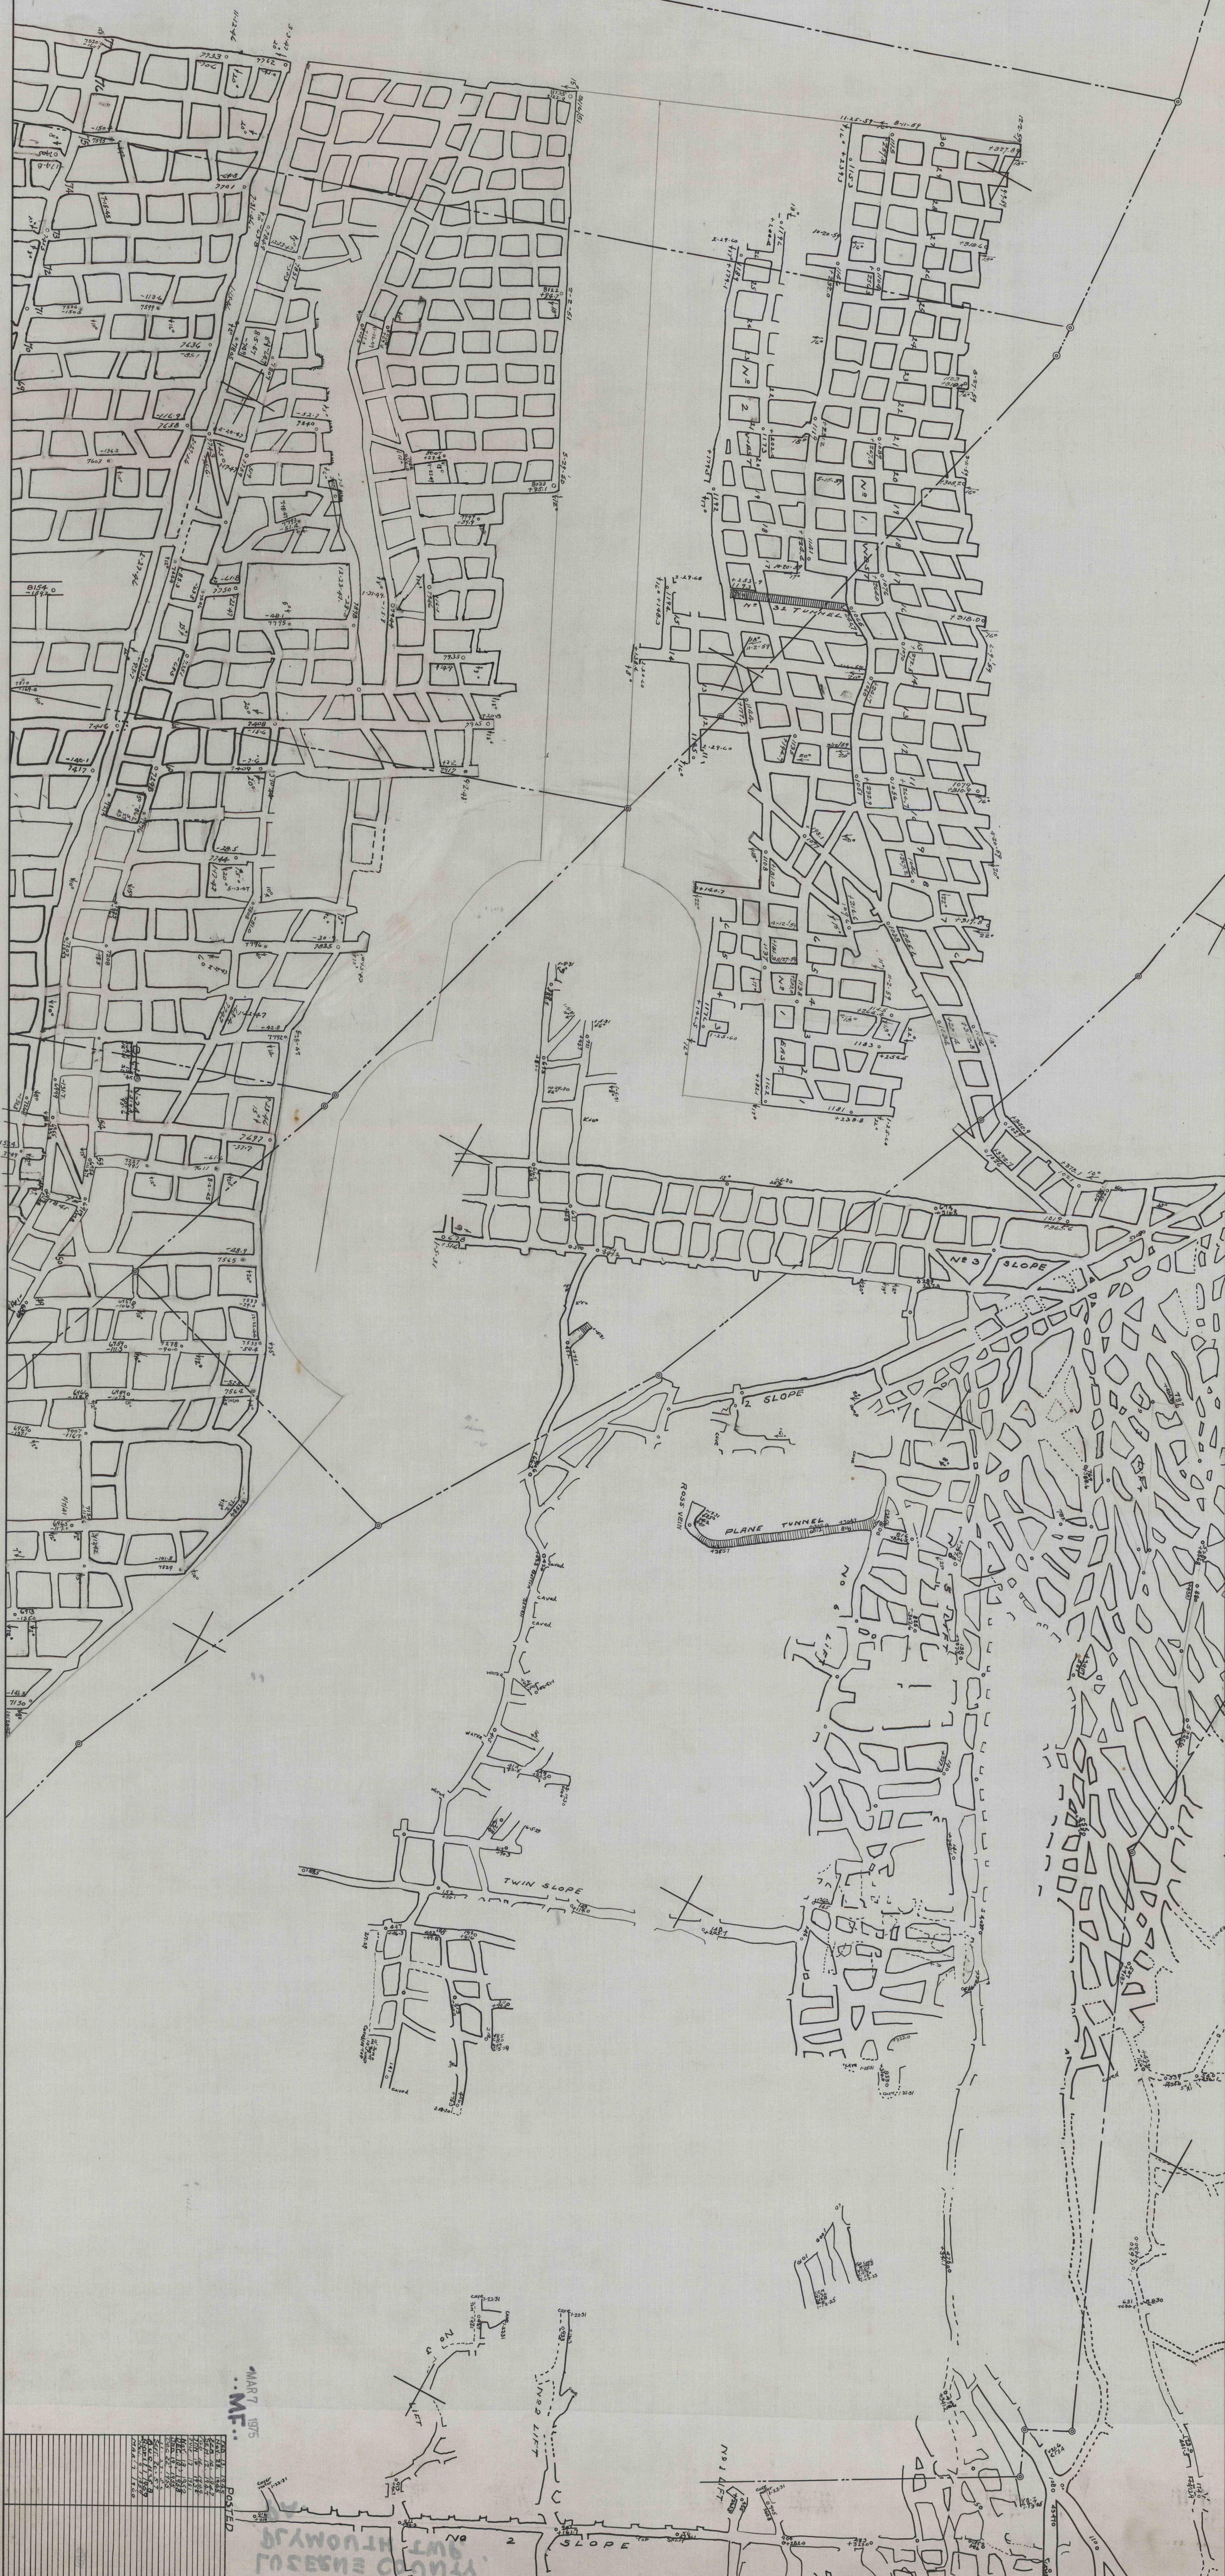

MART 1976 ME.

AVONDALE CORP. 1:100 RED ASH

AVONDALE RED ASH