:NORTHERN FIELD..

ALDEN COAL CO.

POSTED
Oct. 1945 H. Young.

ROSEY VEIN NEWPORT Twp. LUZERNE COUNTY,
NANTICOKE, PA., WILKES-BARRE
DISTRICT. 4.

March 1907

1 in = 100 ft.

MF JUN 9 1972

Mine Inspector's Tracing

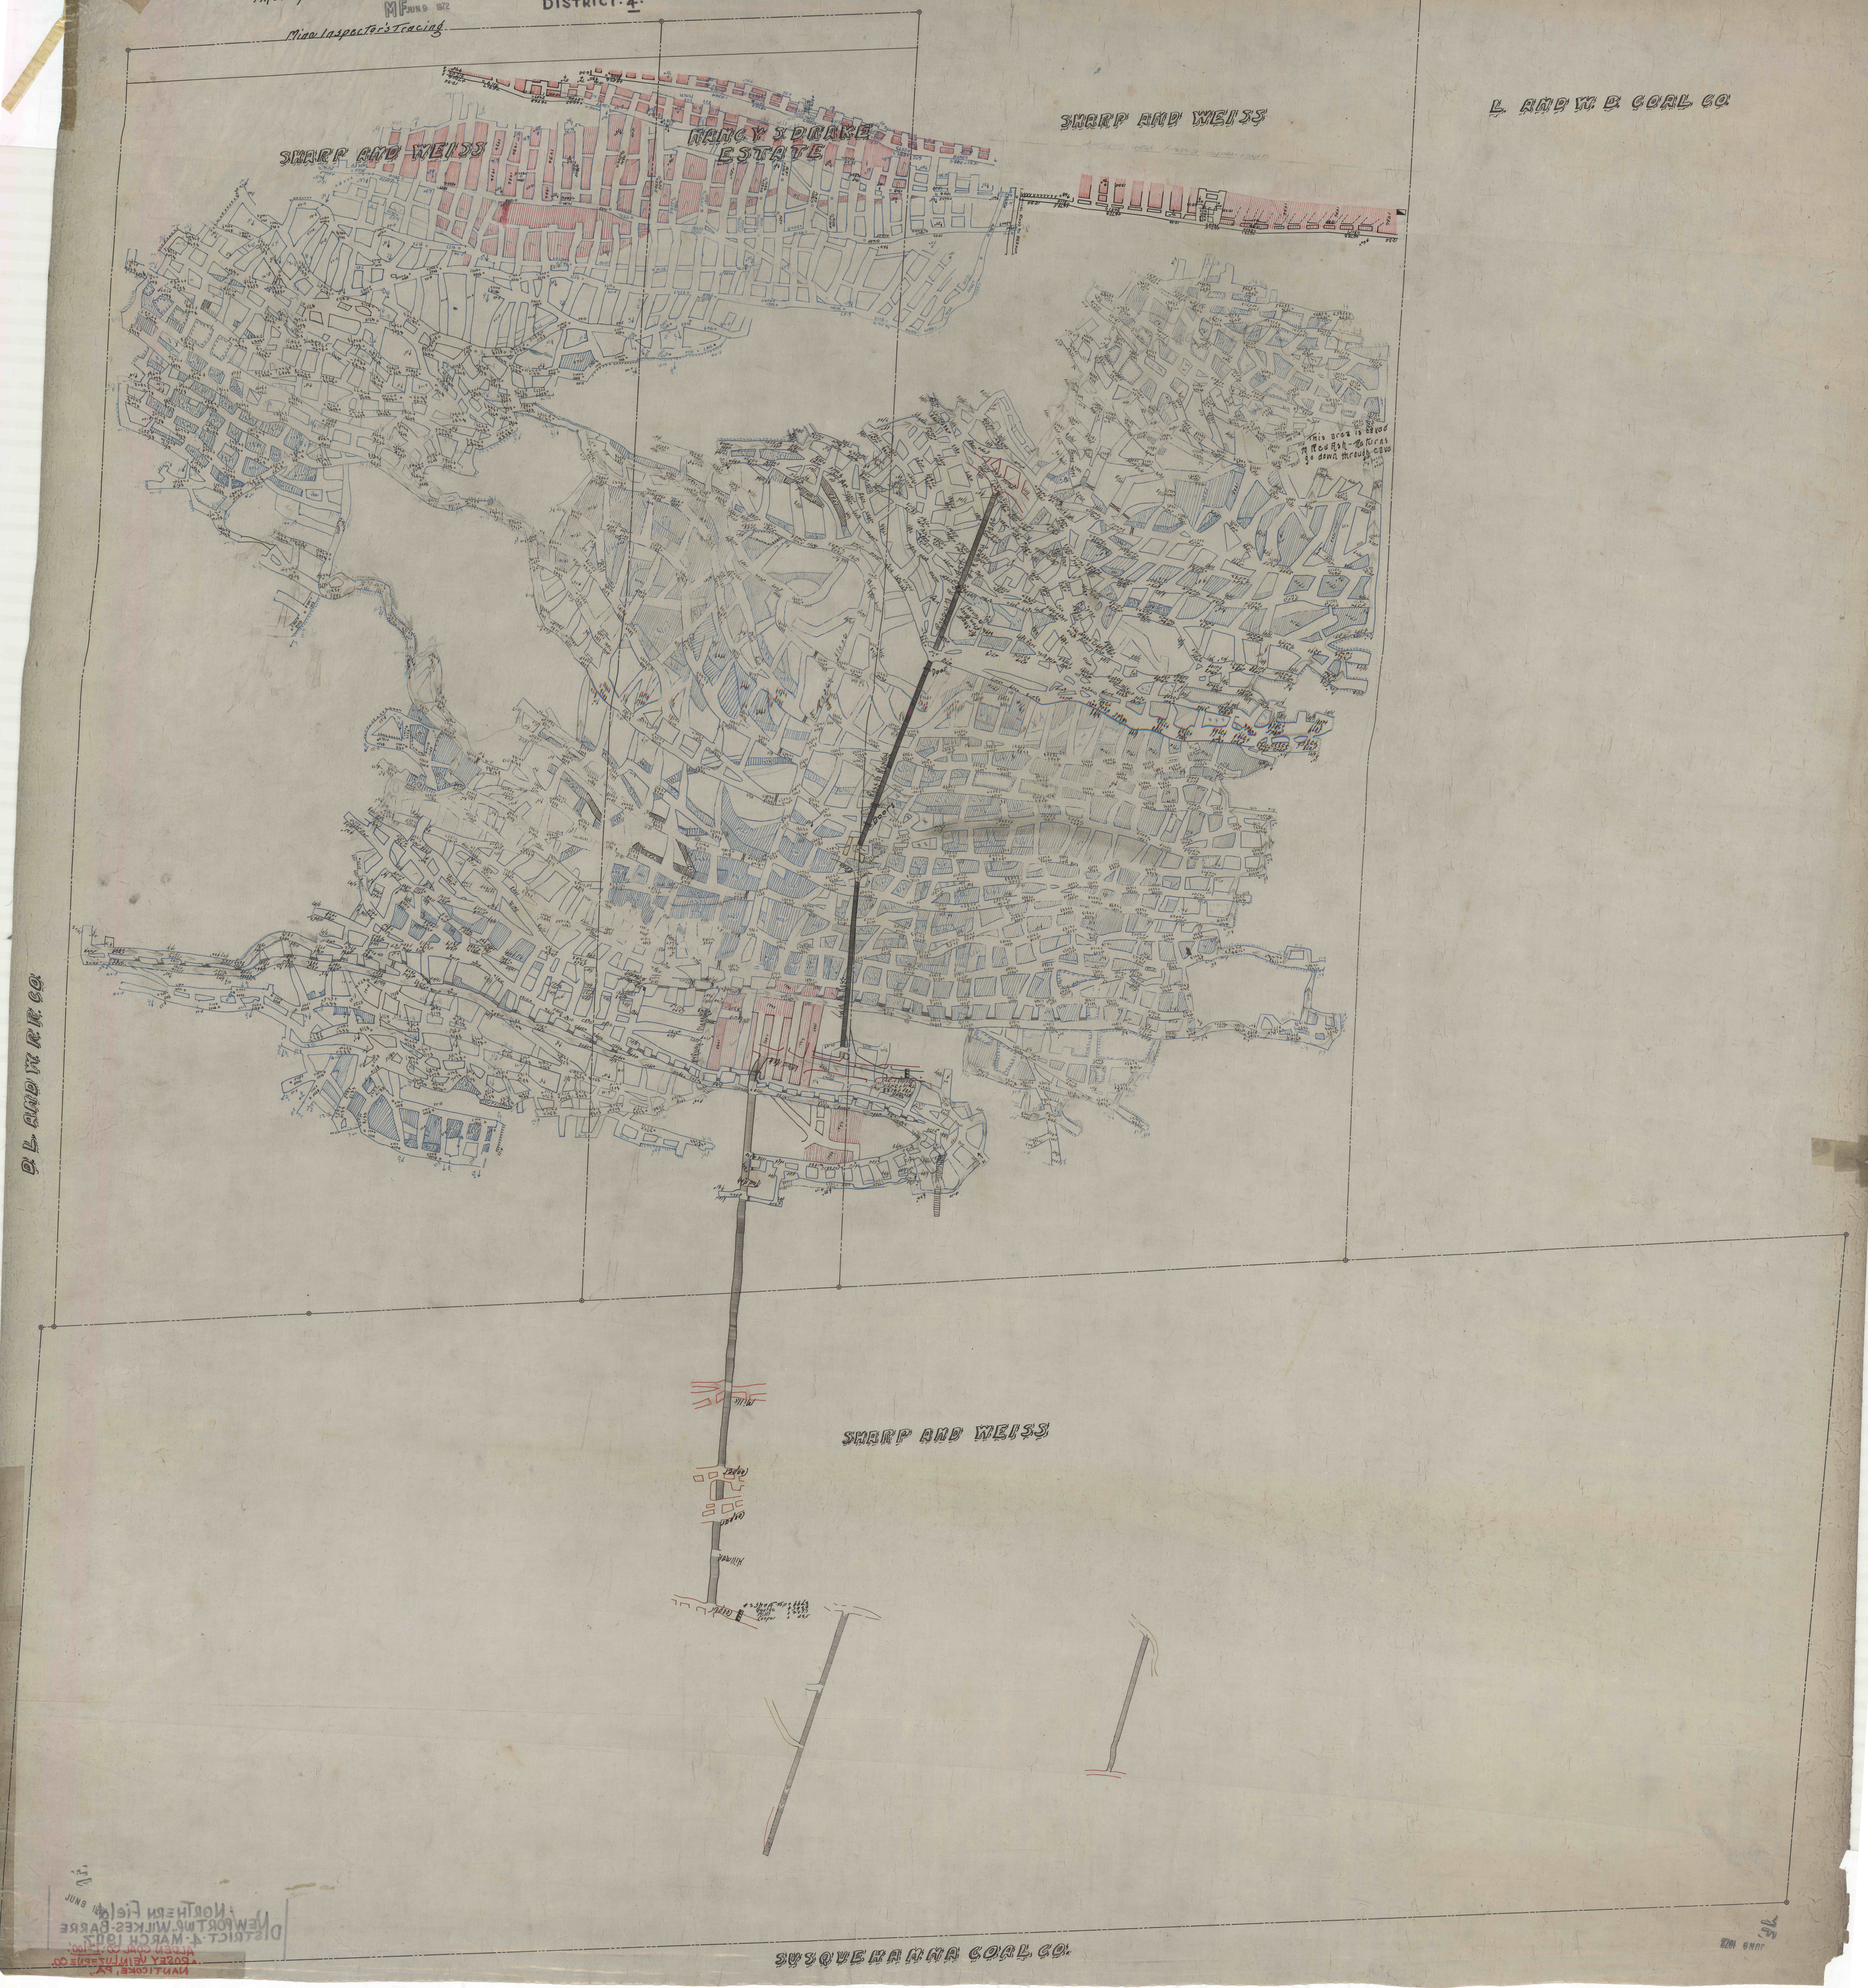
SHARP AND WEISS
NANCY I. DRAKE ESTATE
SHARP AND WEISS
L. AND W. B. COAL CO.
This area is caved to Red Ash - Returns go down through cave
D. L. AND W. R.R. CO.
SHARP AND WEISS
SUSQUEHANNA COAL CO.