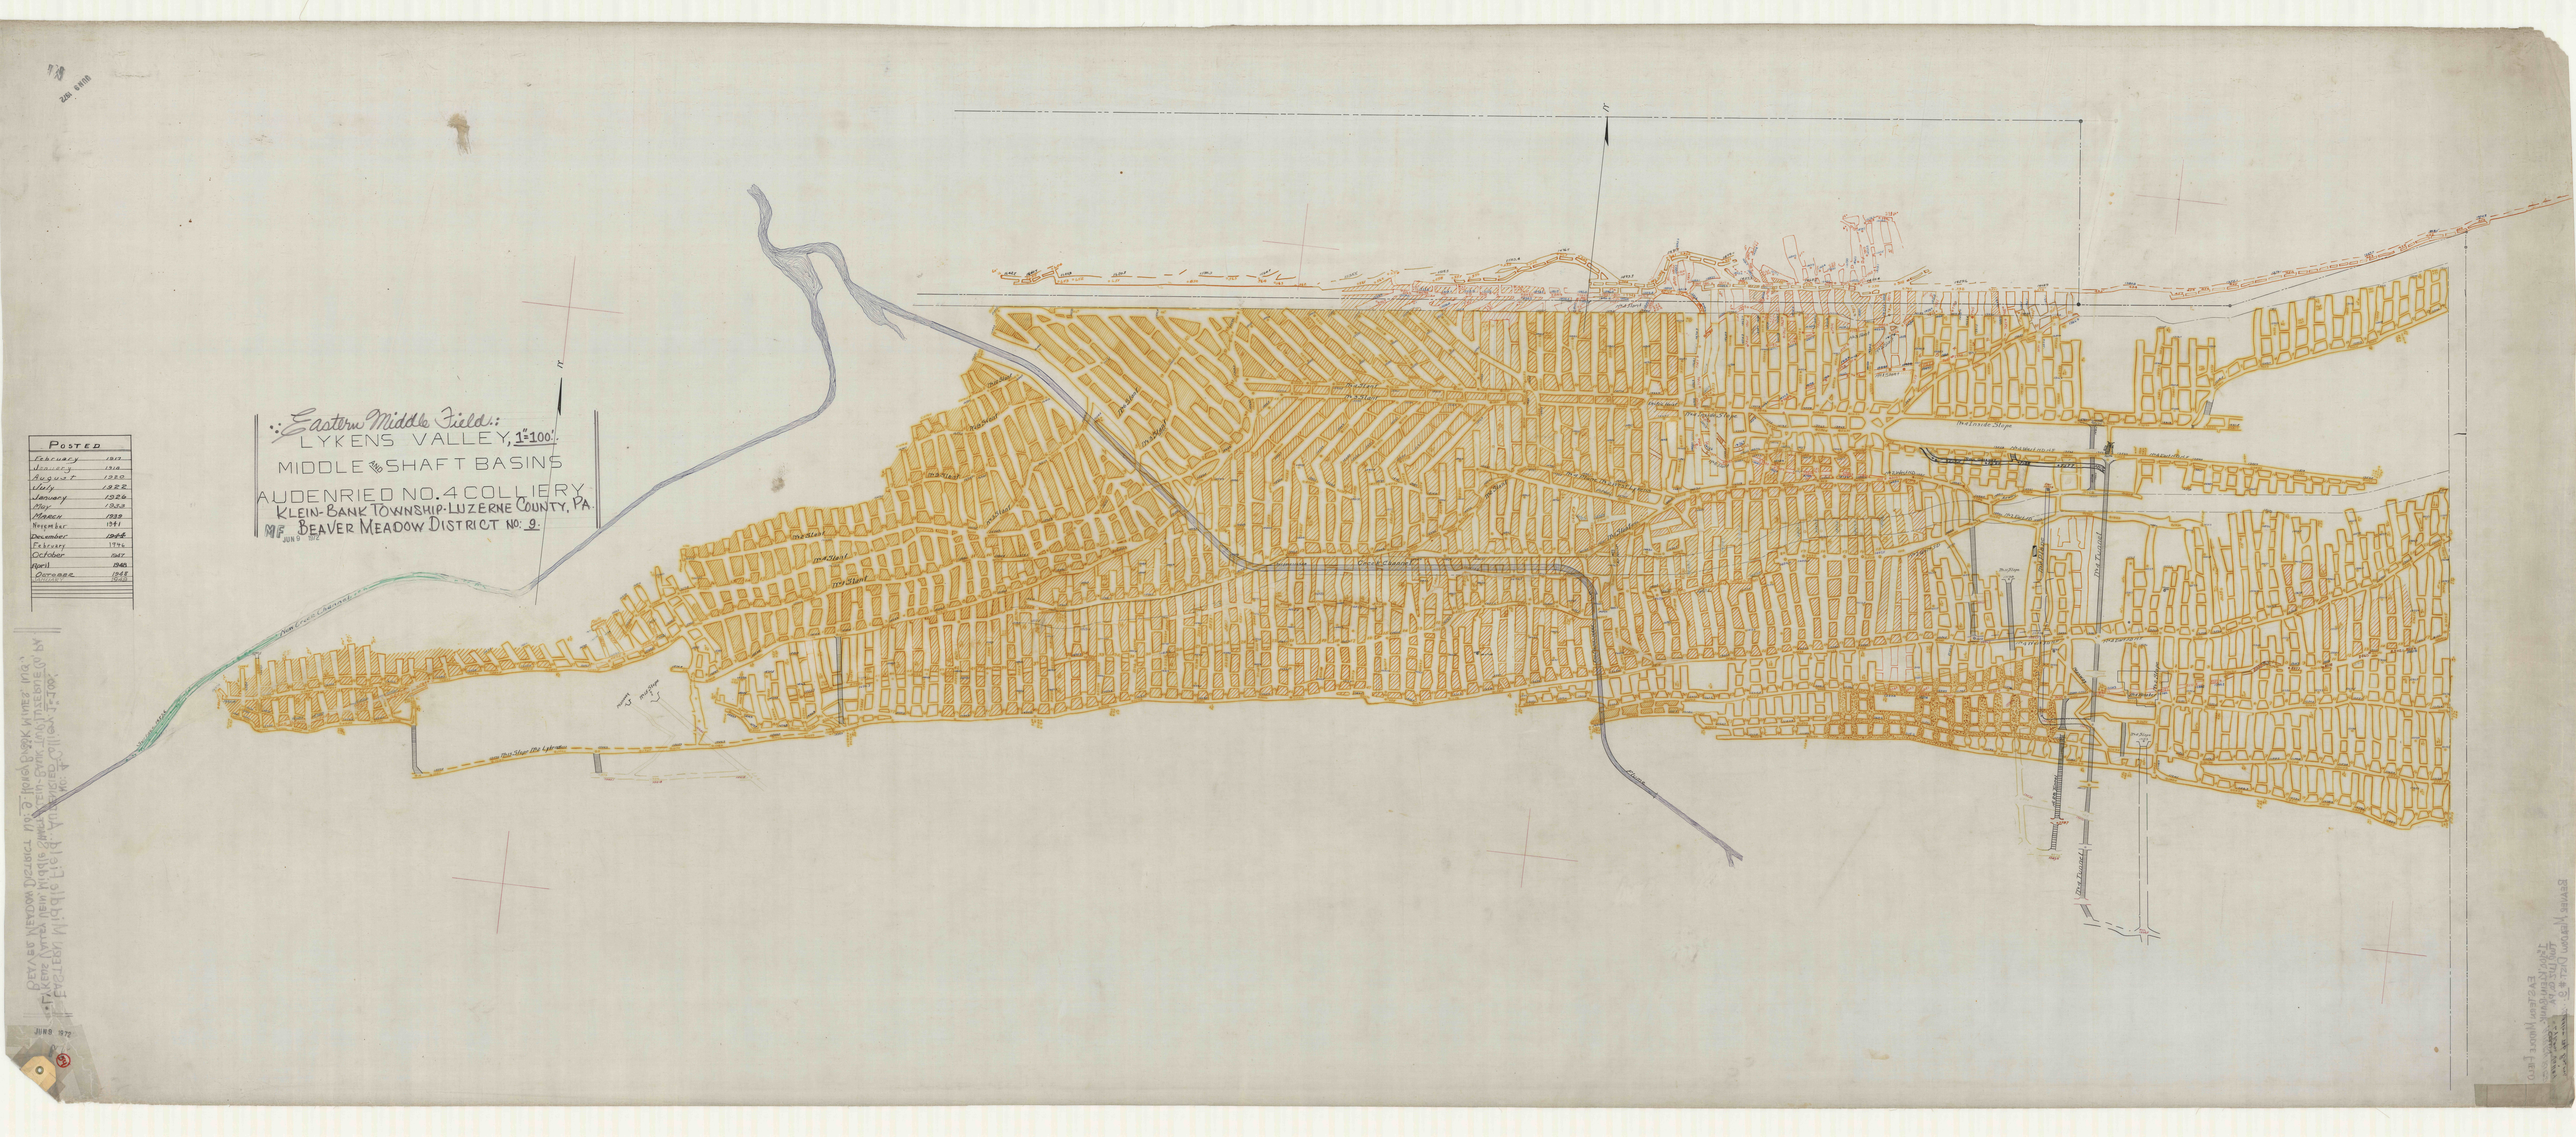

JUN 9 1972

New Creek Channel
Fault

Eastern Middle Field.:

LYKENS VALLEY, 1"=100'.

MIDDLE AND SHAFT BASINS

AUDENRIED NO. 4 COLLIERY

KLEIN-BANK TOWNSHIP · LUZERNE COUNTY, PA.
BEAVER MEADOW DISTRICT NO: 9.

MF JUN 9 1972

POSTED	
February	1917
January	1918
August	1920
July	1922
January	1926
May	1933
MARCH	1939
November	1941
December	1944
February	1946
October	1947
April	1948
OCTOBER	1948
JANUARY	1949

JUN 9 1972

54