


JUN 9 1972

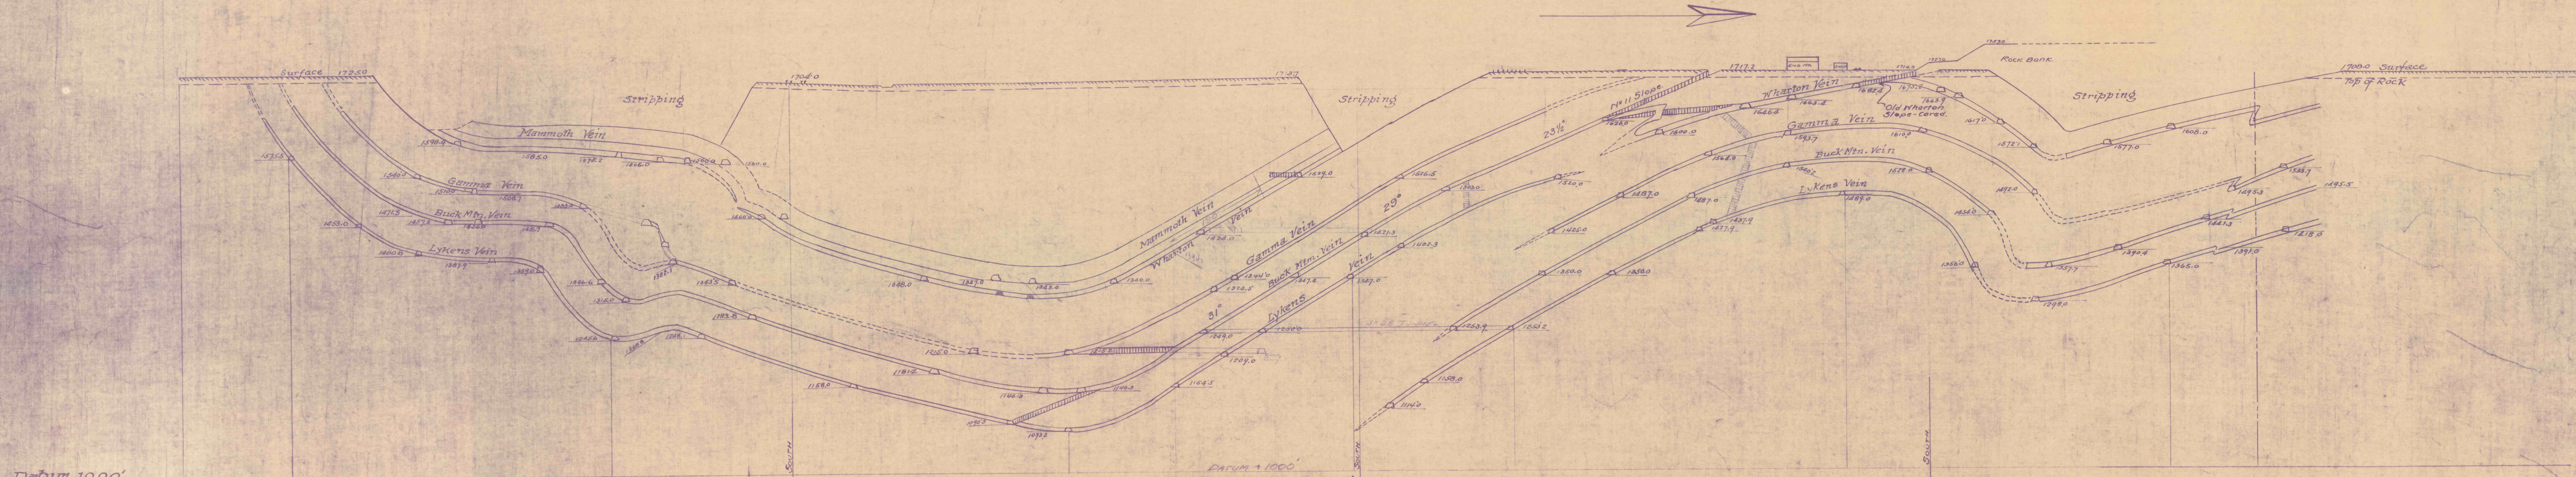

EASTERN MIDDLE FIELD.. BANK TWP. LUZERNE COUNTY, PA.
SECTION LINE NO. 11. SLOPE
AUDENRIED NO. 4. COLLY.
SCALE 1" 100'.
JULY 1921.

JUN 9 1972