


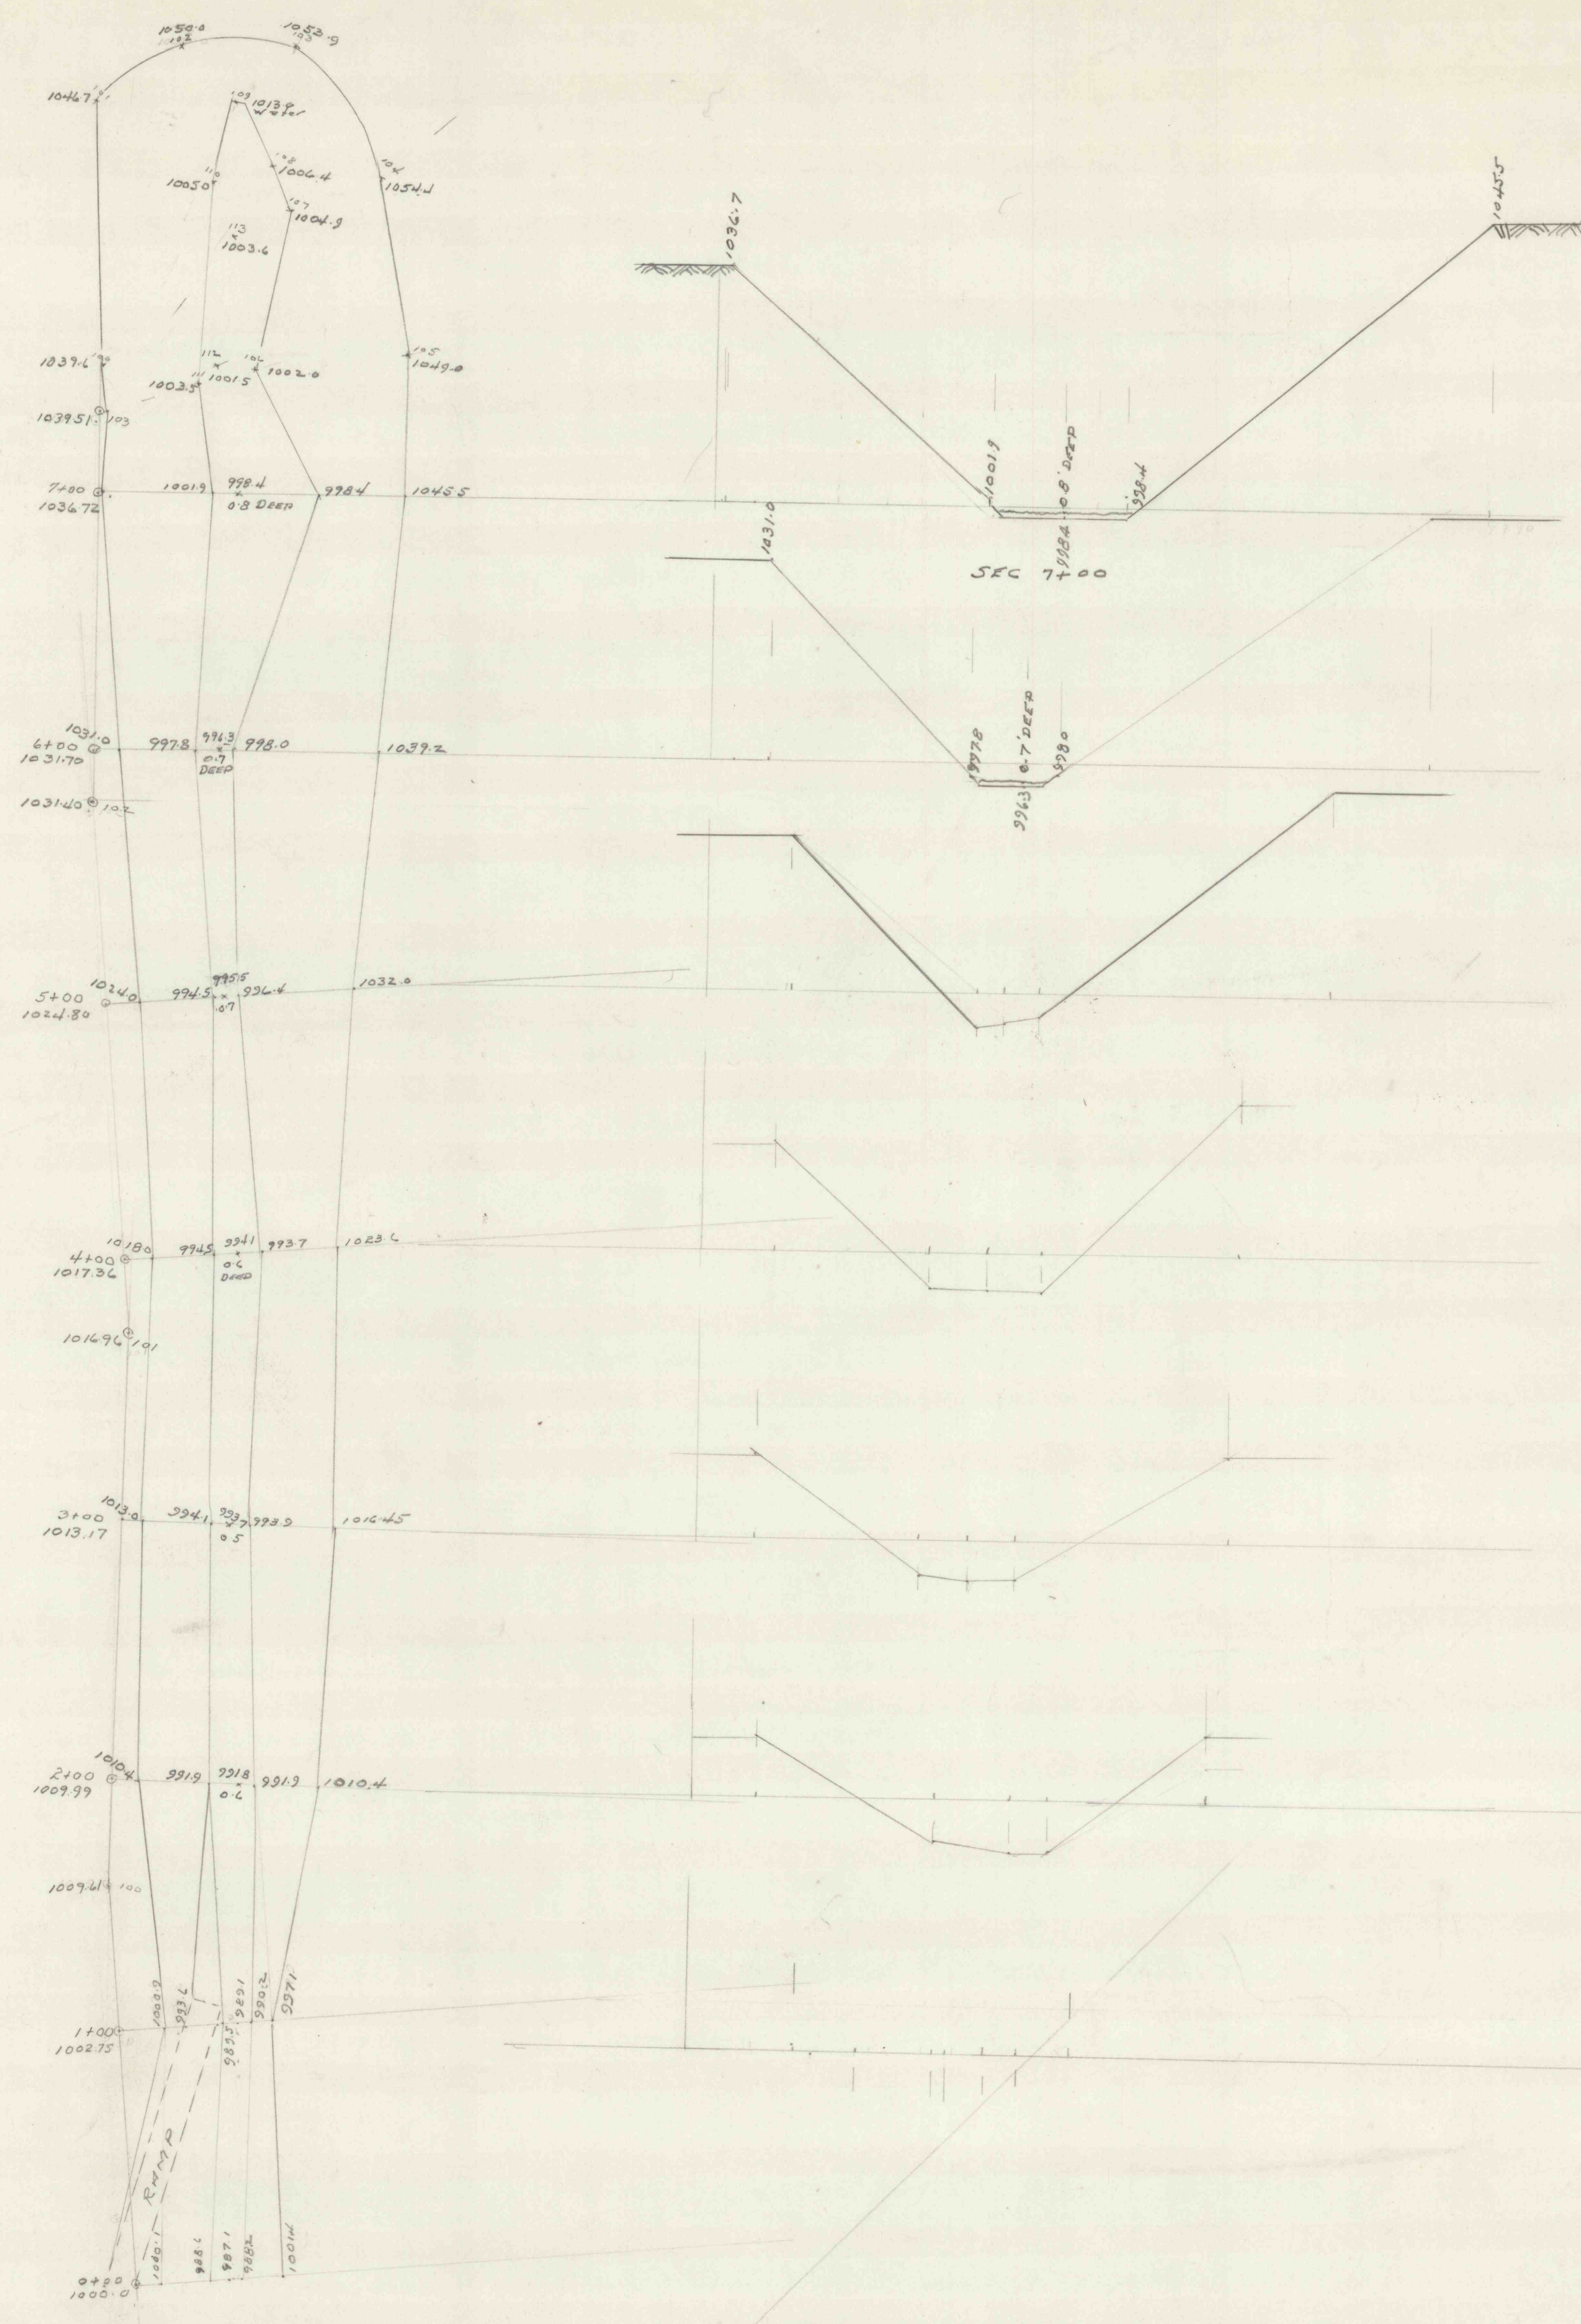

SCALE 1"=50'
QUAKE TUNNEL