6

AUCHINCLOSS TOP ROSS VEIN No 3 SLOPE SECTION

FITTING LINE 6-5

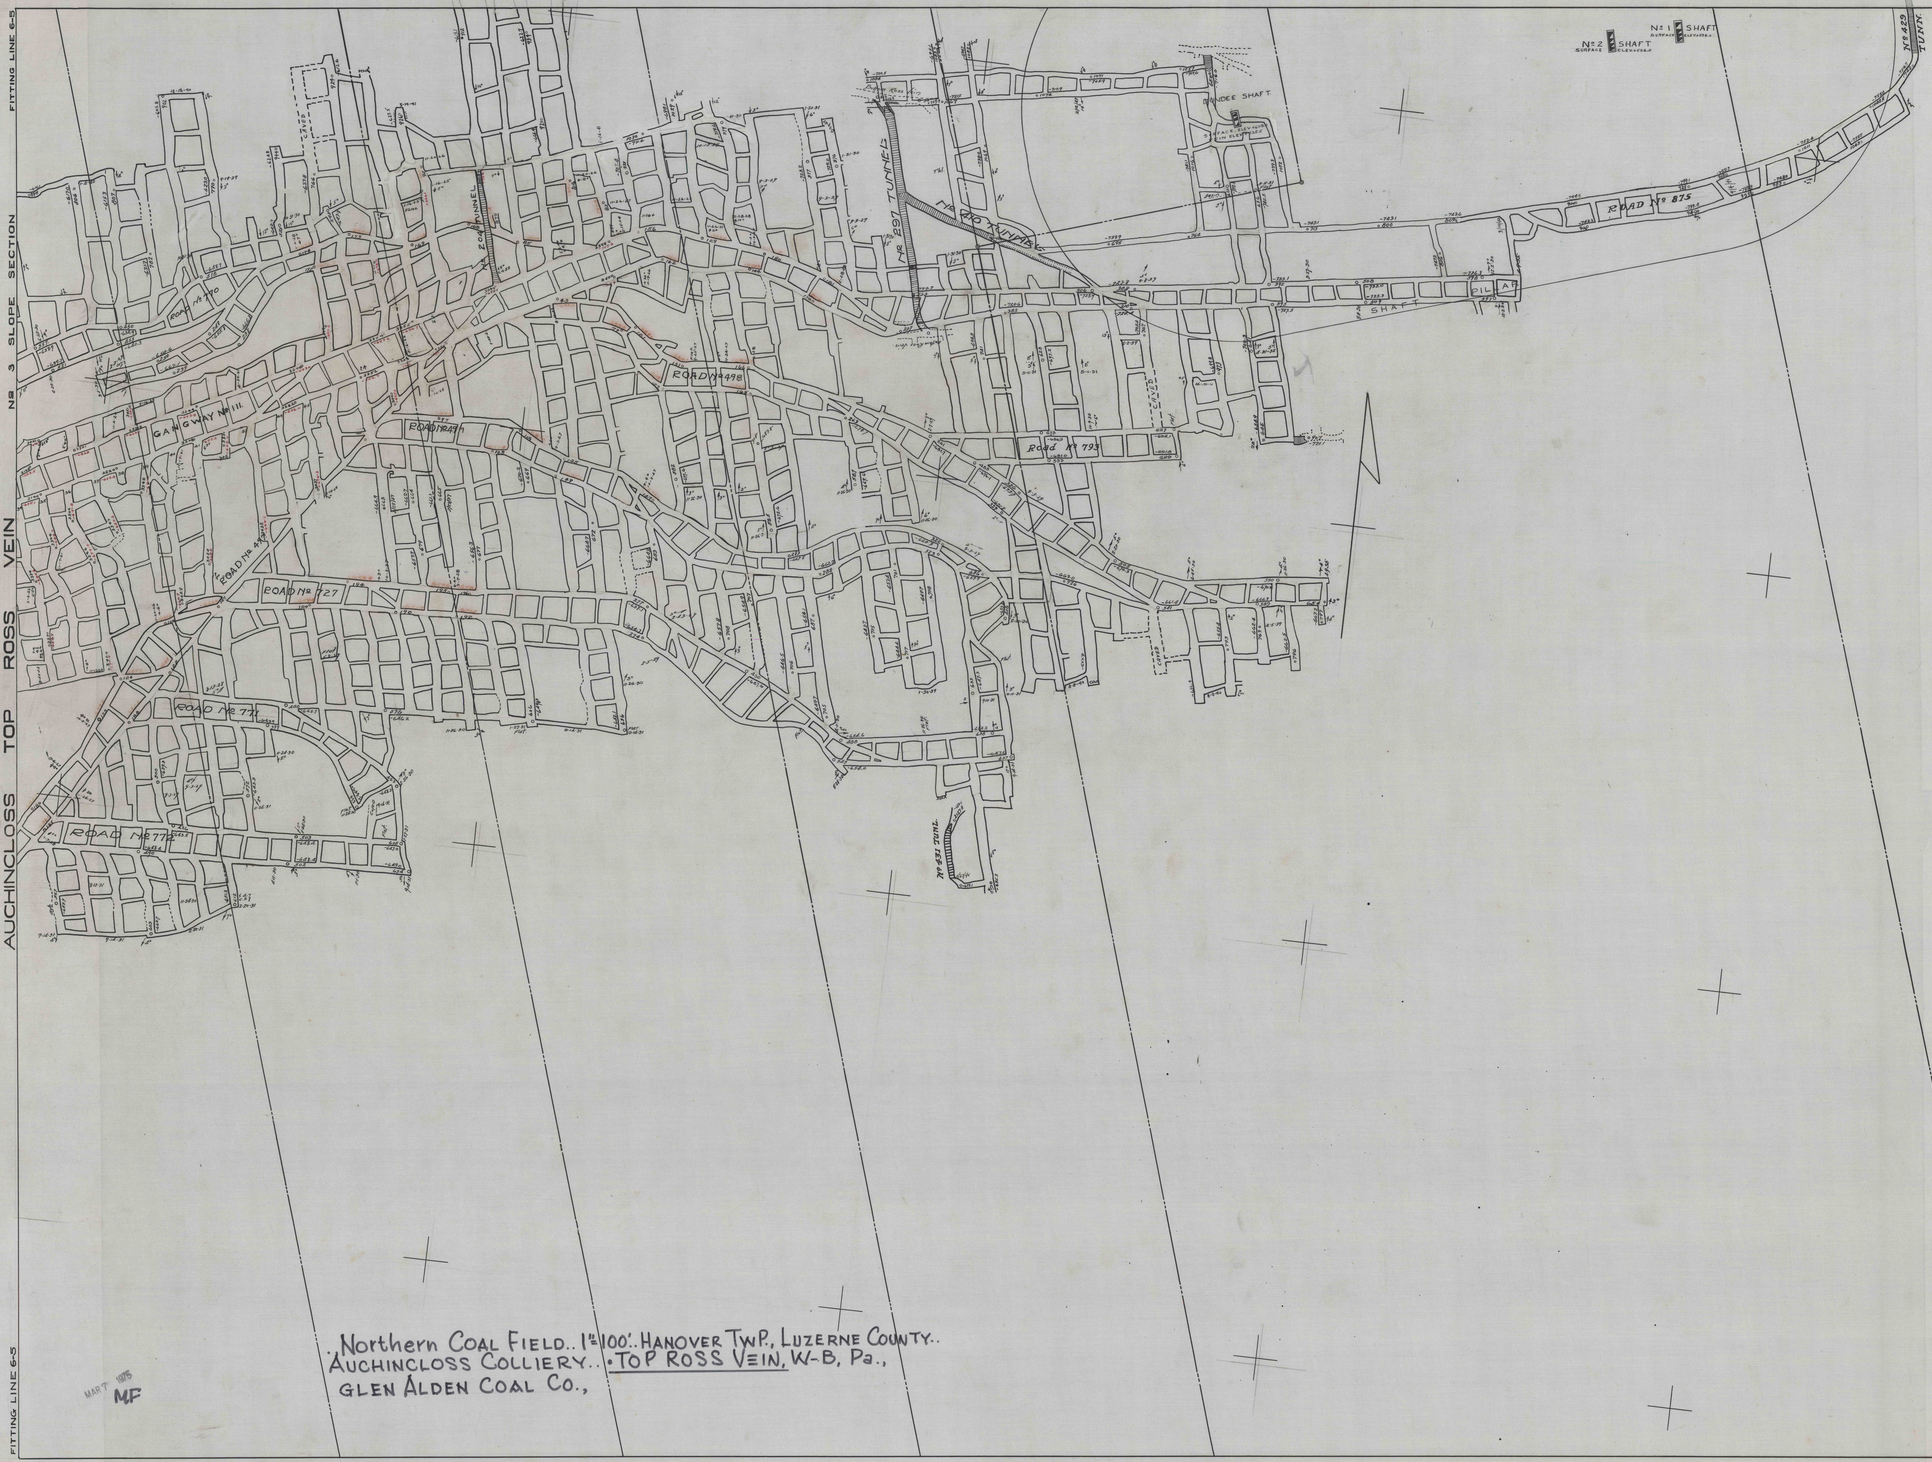

Northern Coal Field.. 1"=100'.. Hanover Twp., Luzerne County..
Auchincloss Colliery.. Top Ross Vein, W-B, Pa.,
Glen Alden Coal Co.,

MAR 7 1975 MF

MAR 7 1975 MF

6

AUCHINCLOSS TOP ROSS VEIN No 3 SLOPE SECTION

6

6 STX