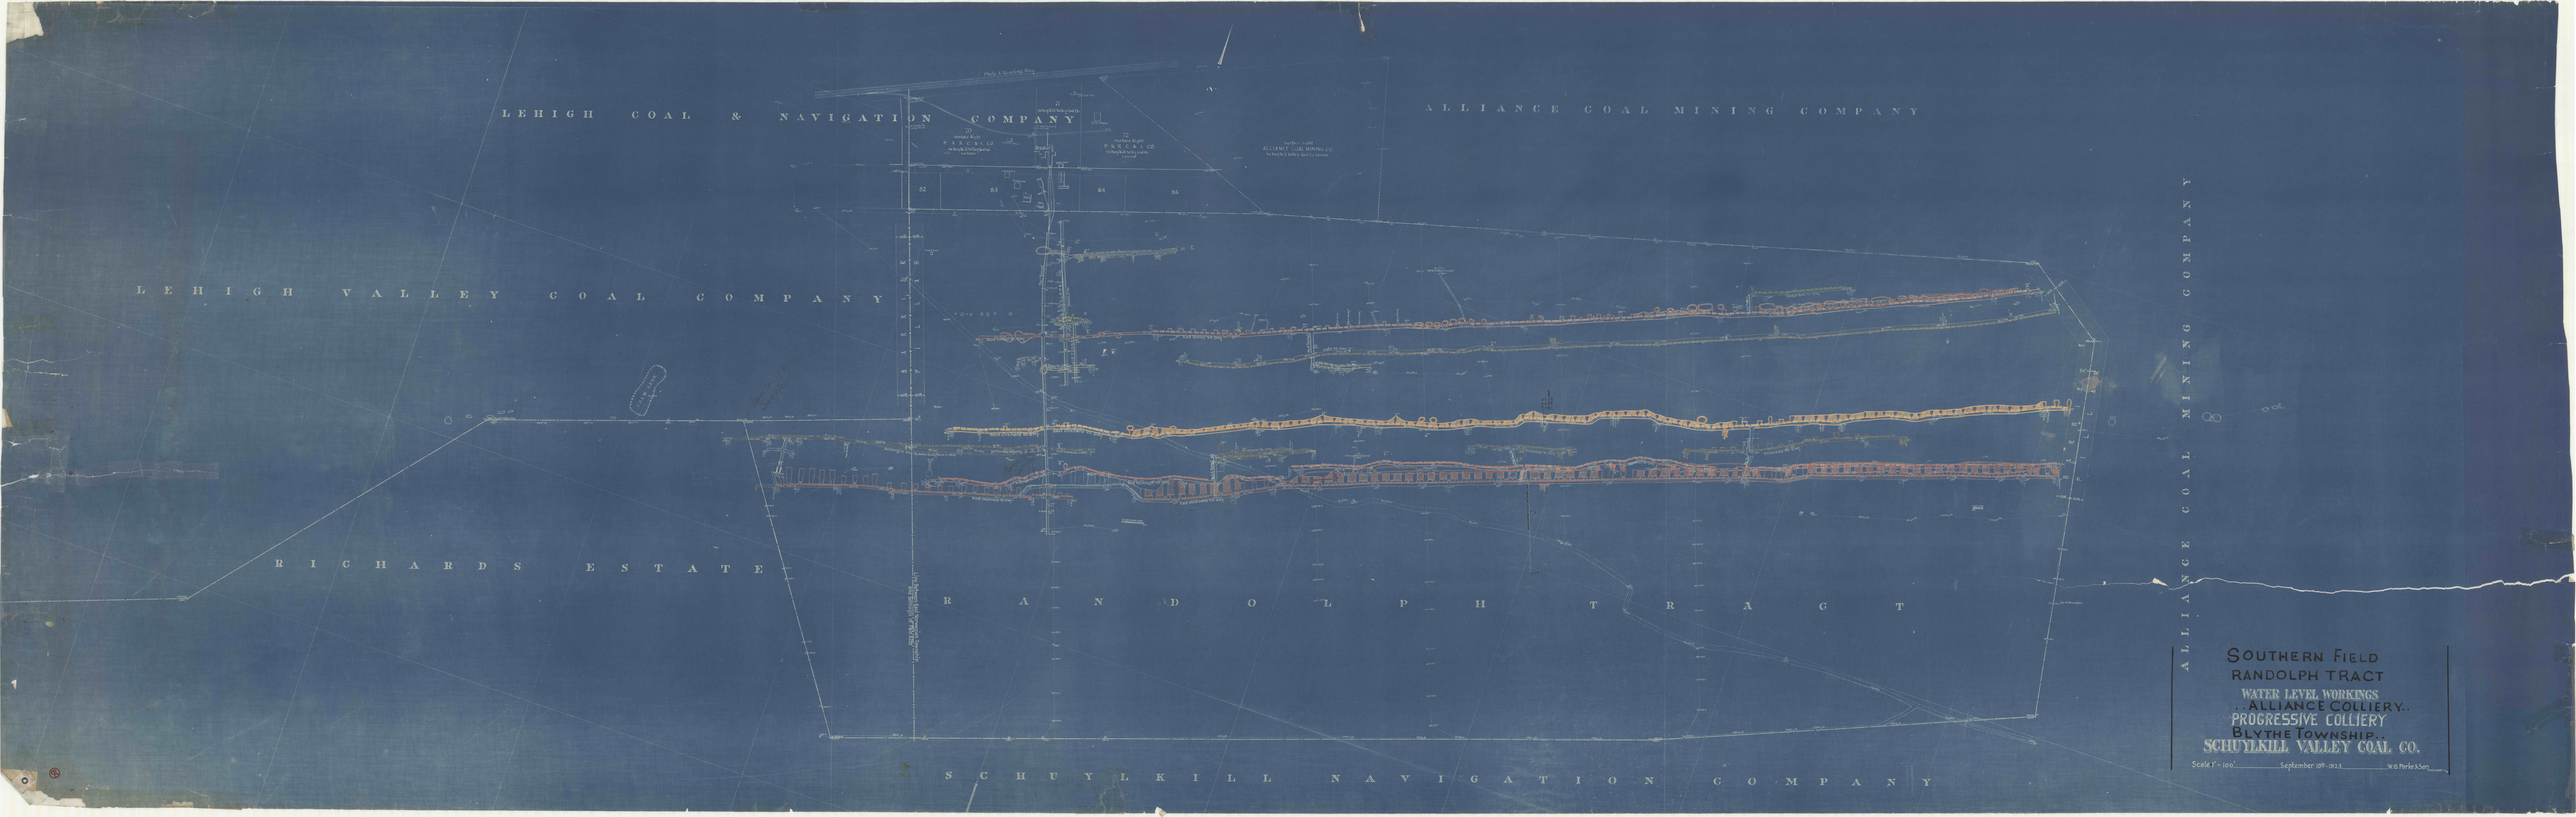
LEHIGH COAL & NAVIGATION COMPANY
ALLIANCE COAL MINING COMPANY
LEHIGH VALLEY COAL COMPANY
RICHARDS ESTATE
RANDOLPH TRACT
SCHUYLKILL NAVIGATION COMPANY
ALLIANCE COAL MINING COMPANY
SOUTHERN FIELD
RANDOLPH TRACT
WATER LEVEL WORKINGS
..ALLIANCE COLLIERY..
PROGRESSIVE COLLIERY
BLYTHE TOWNSHIP..
SCHUYLKILL VALLEY COAL CO.
Scale 1" = 100'
September 10th 1923
W.G. Parker & Son