

Sections Buck Mt. Vein,


ALTAMONT SLOPE No. 2,

Broad Mountain, Pa.


Shamokin, Pa.,

JUNE, 1888.


20' West of Sta. 9.

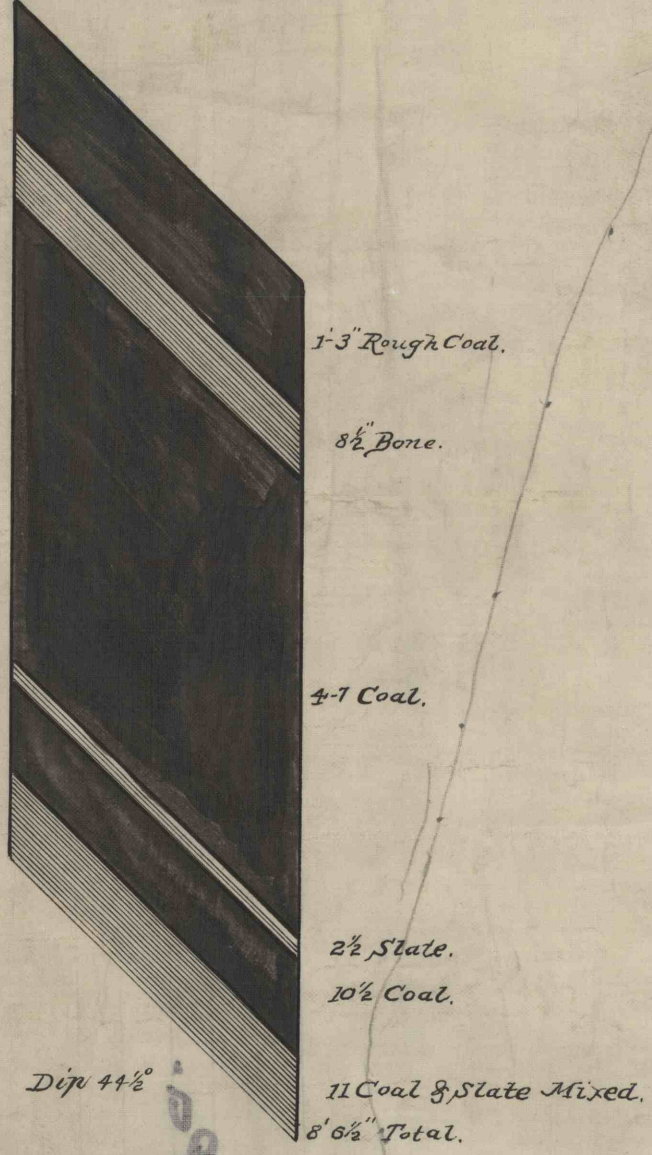


Head No. 3 Slope, Sta. 17.

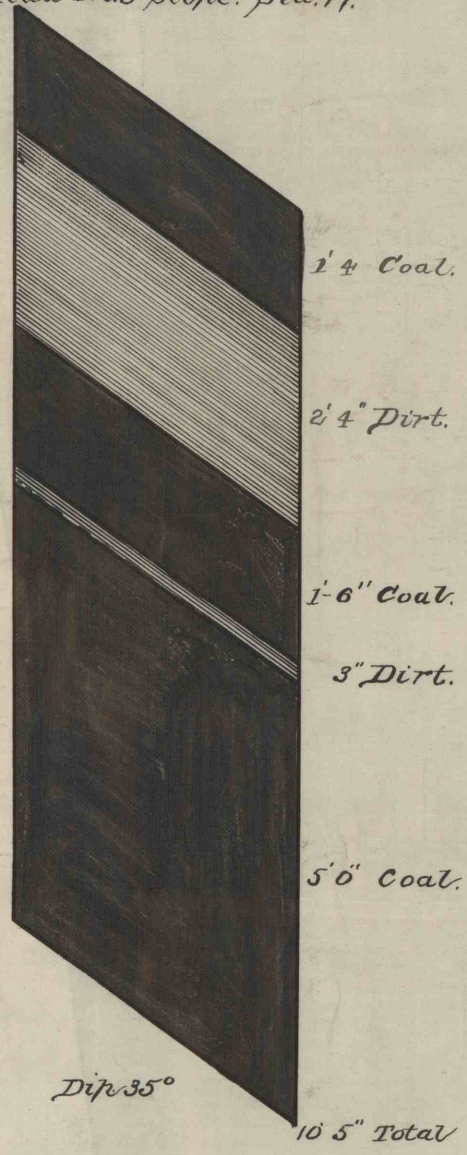


90' Below Station 23 No. 3 Slope.

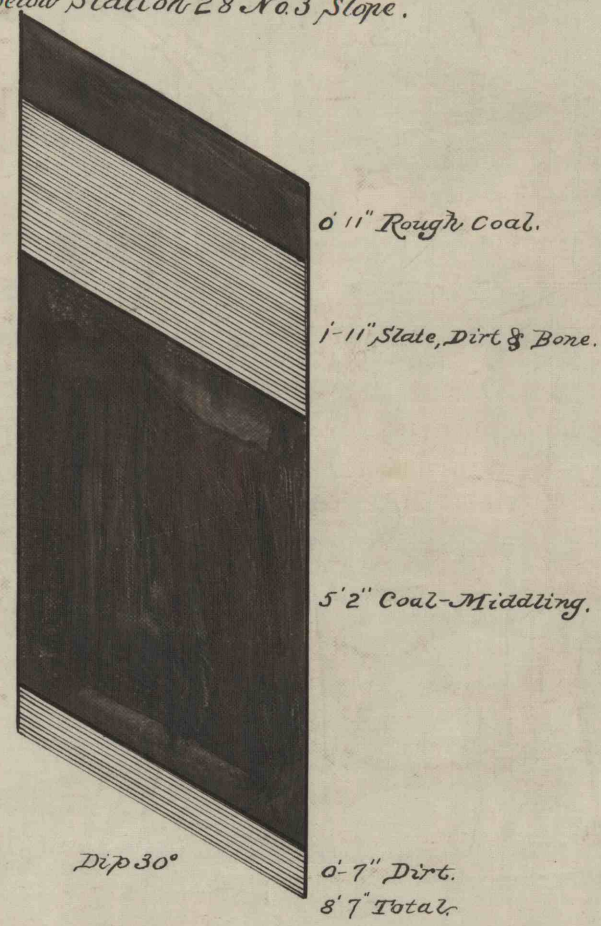


70' East of Station 10.

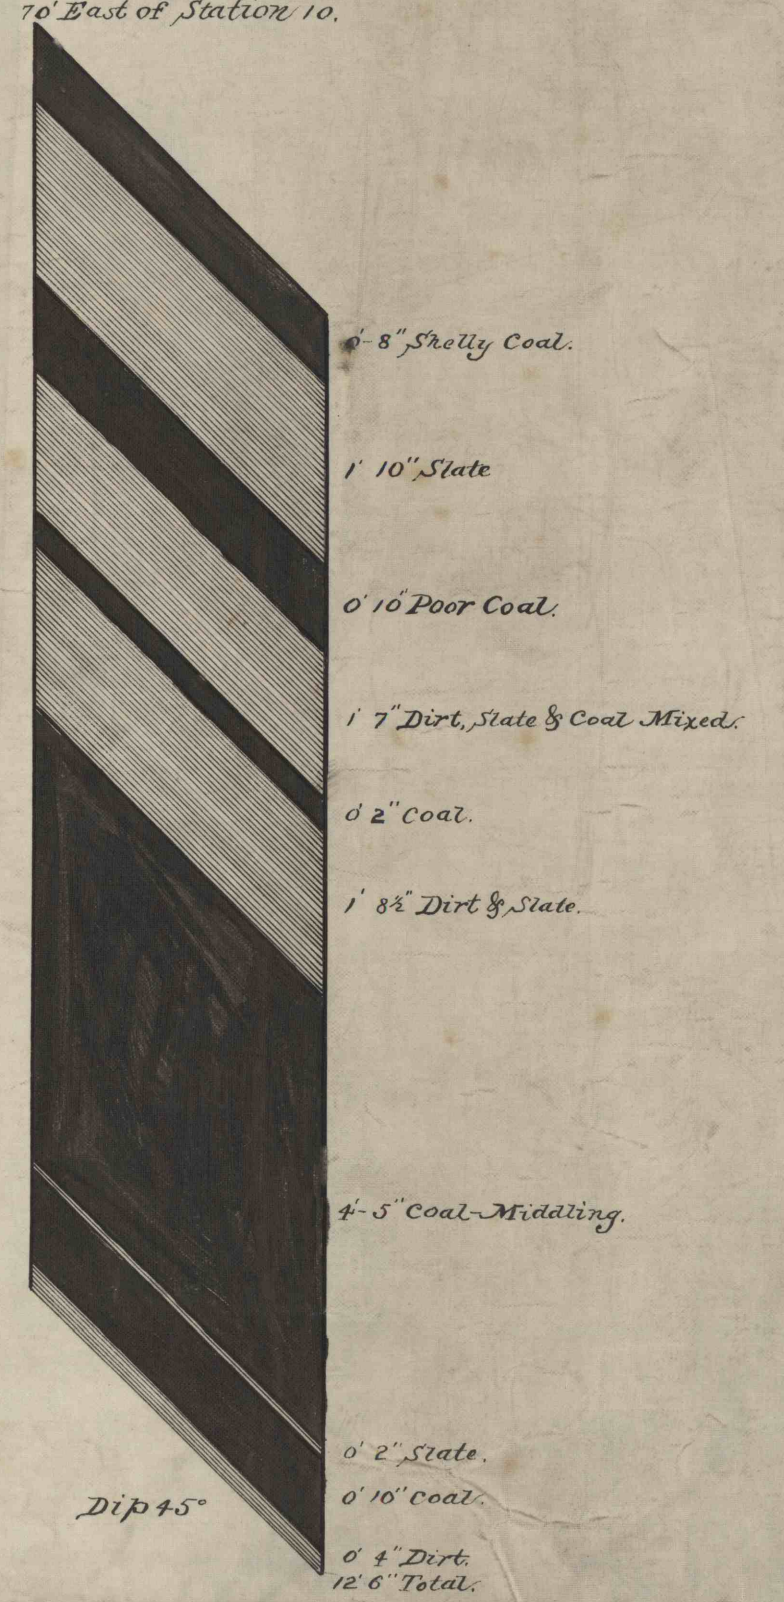


At Station 20.

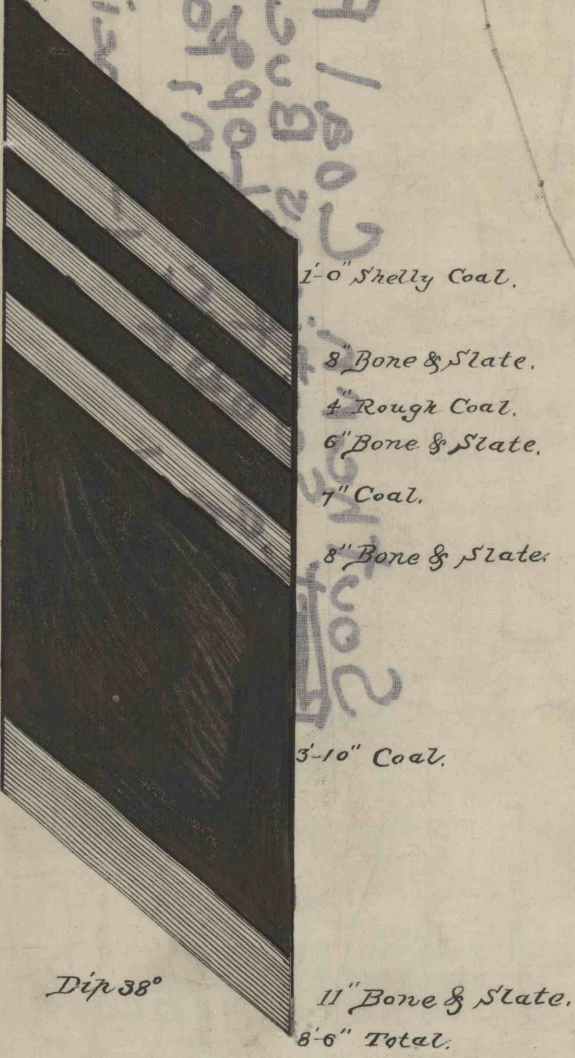

Station 23 No. 3 Slope.

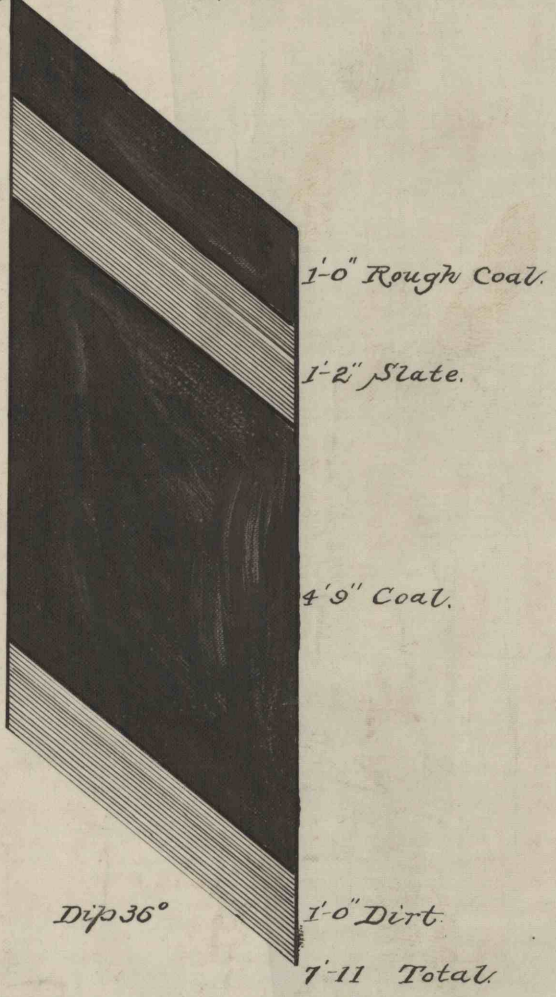

120' East of Station 12.

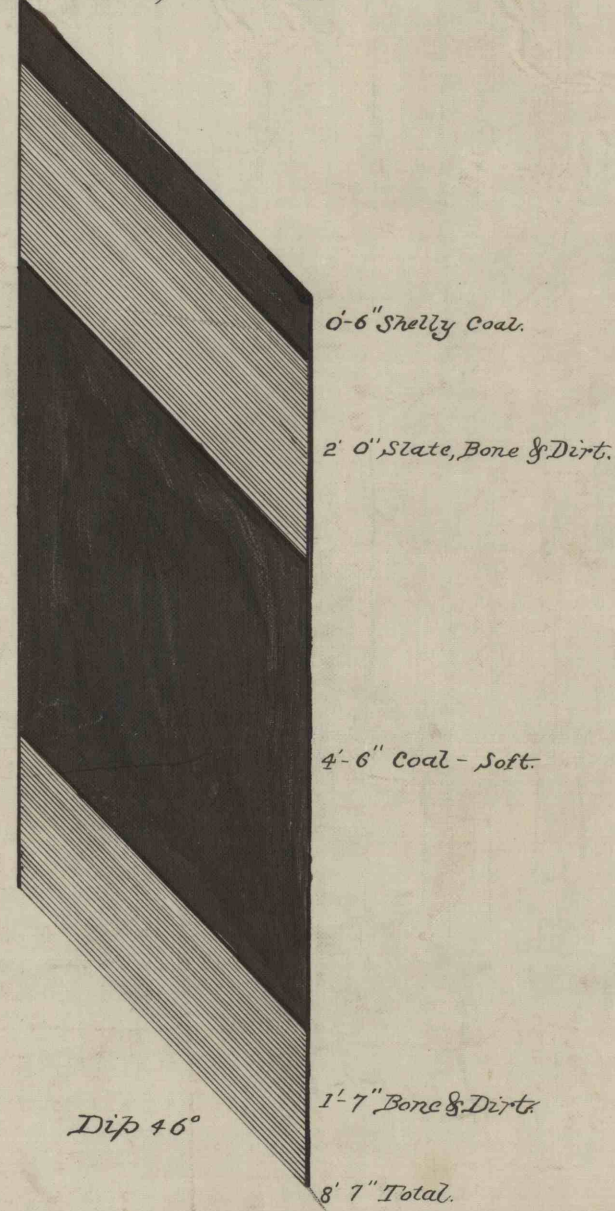

SCALE 3/8 IN = 1 FOOT.

1-11-88
Guest Work
Buck Mt. Vein
Broad Mountain
Coal