

MF
2261 6 MAR 1972
Southern Coal Field:

"X=section-thru-RICKERTS-Tracy Slope

Mine. Branch Twp., Schuylkill County Penna.,
15 West Schuylkill District. Llewellyn.


ALBRIGHT COLLIERY

SECTION ON LINE OF BLACK MINE SLOPE

Scale 1 in. = 100 ft.

COPYED FROM A.B. Cochran & Son

James Archbald, Jr. MINING ENGINEER

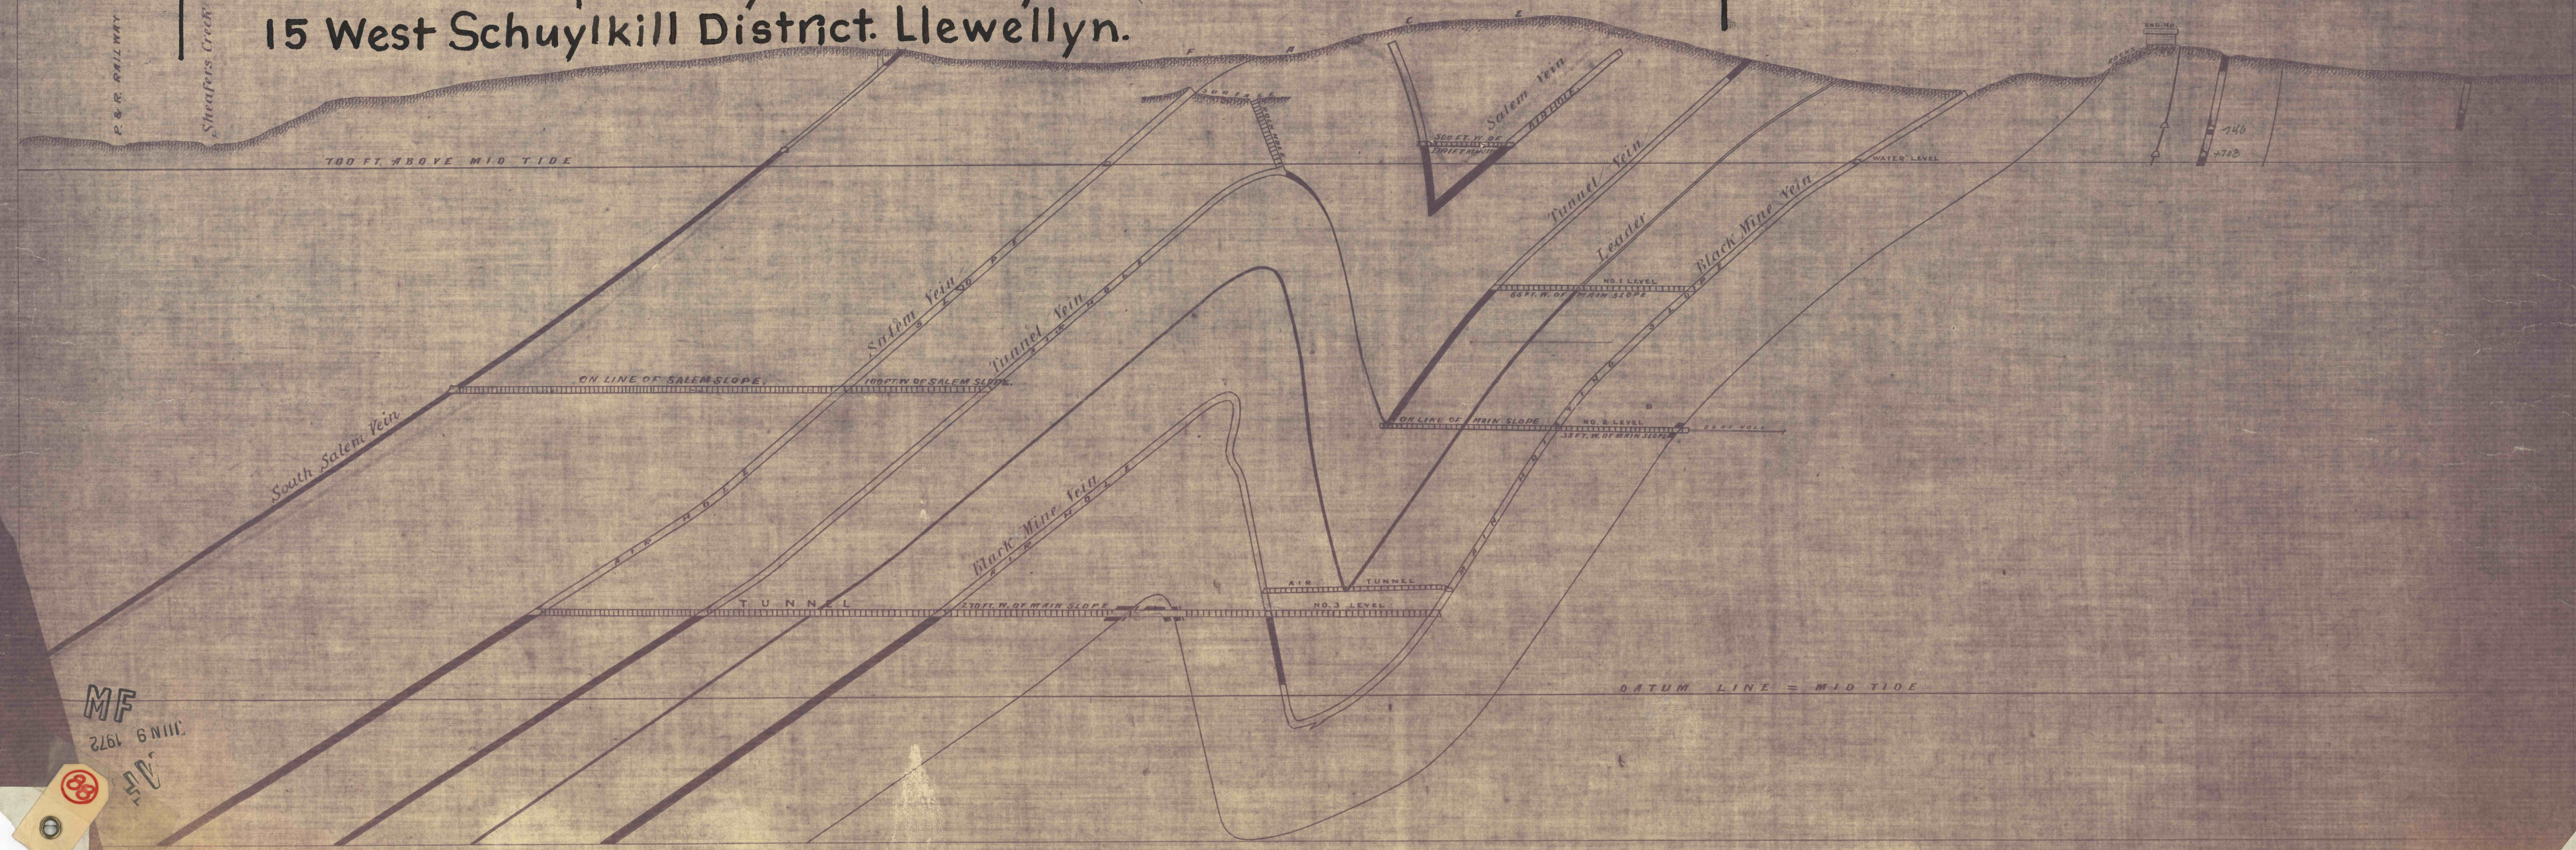

MF

JUN 9 1972

85