

BALTIMORE

COLLIERY
NORTHERN FIELD

PLAINS TWP, LUZERNE COUNTY, WILKES-BARRE, PA.
1:100'

C. BED

MINE INSPECTOR'S TRACING

GLEN

ALDEN

COAL


CO.

CO.

COAL

VALLEY

LEHIGH

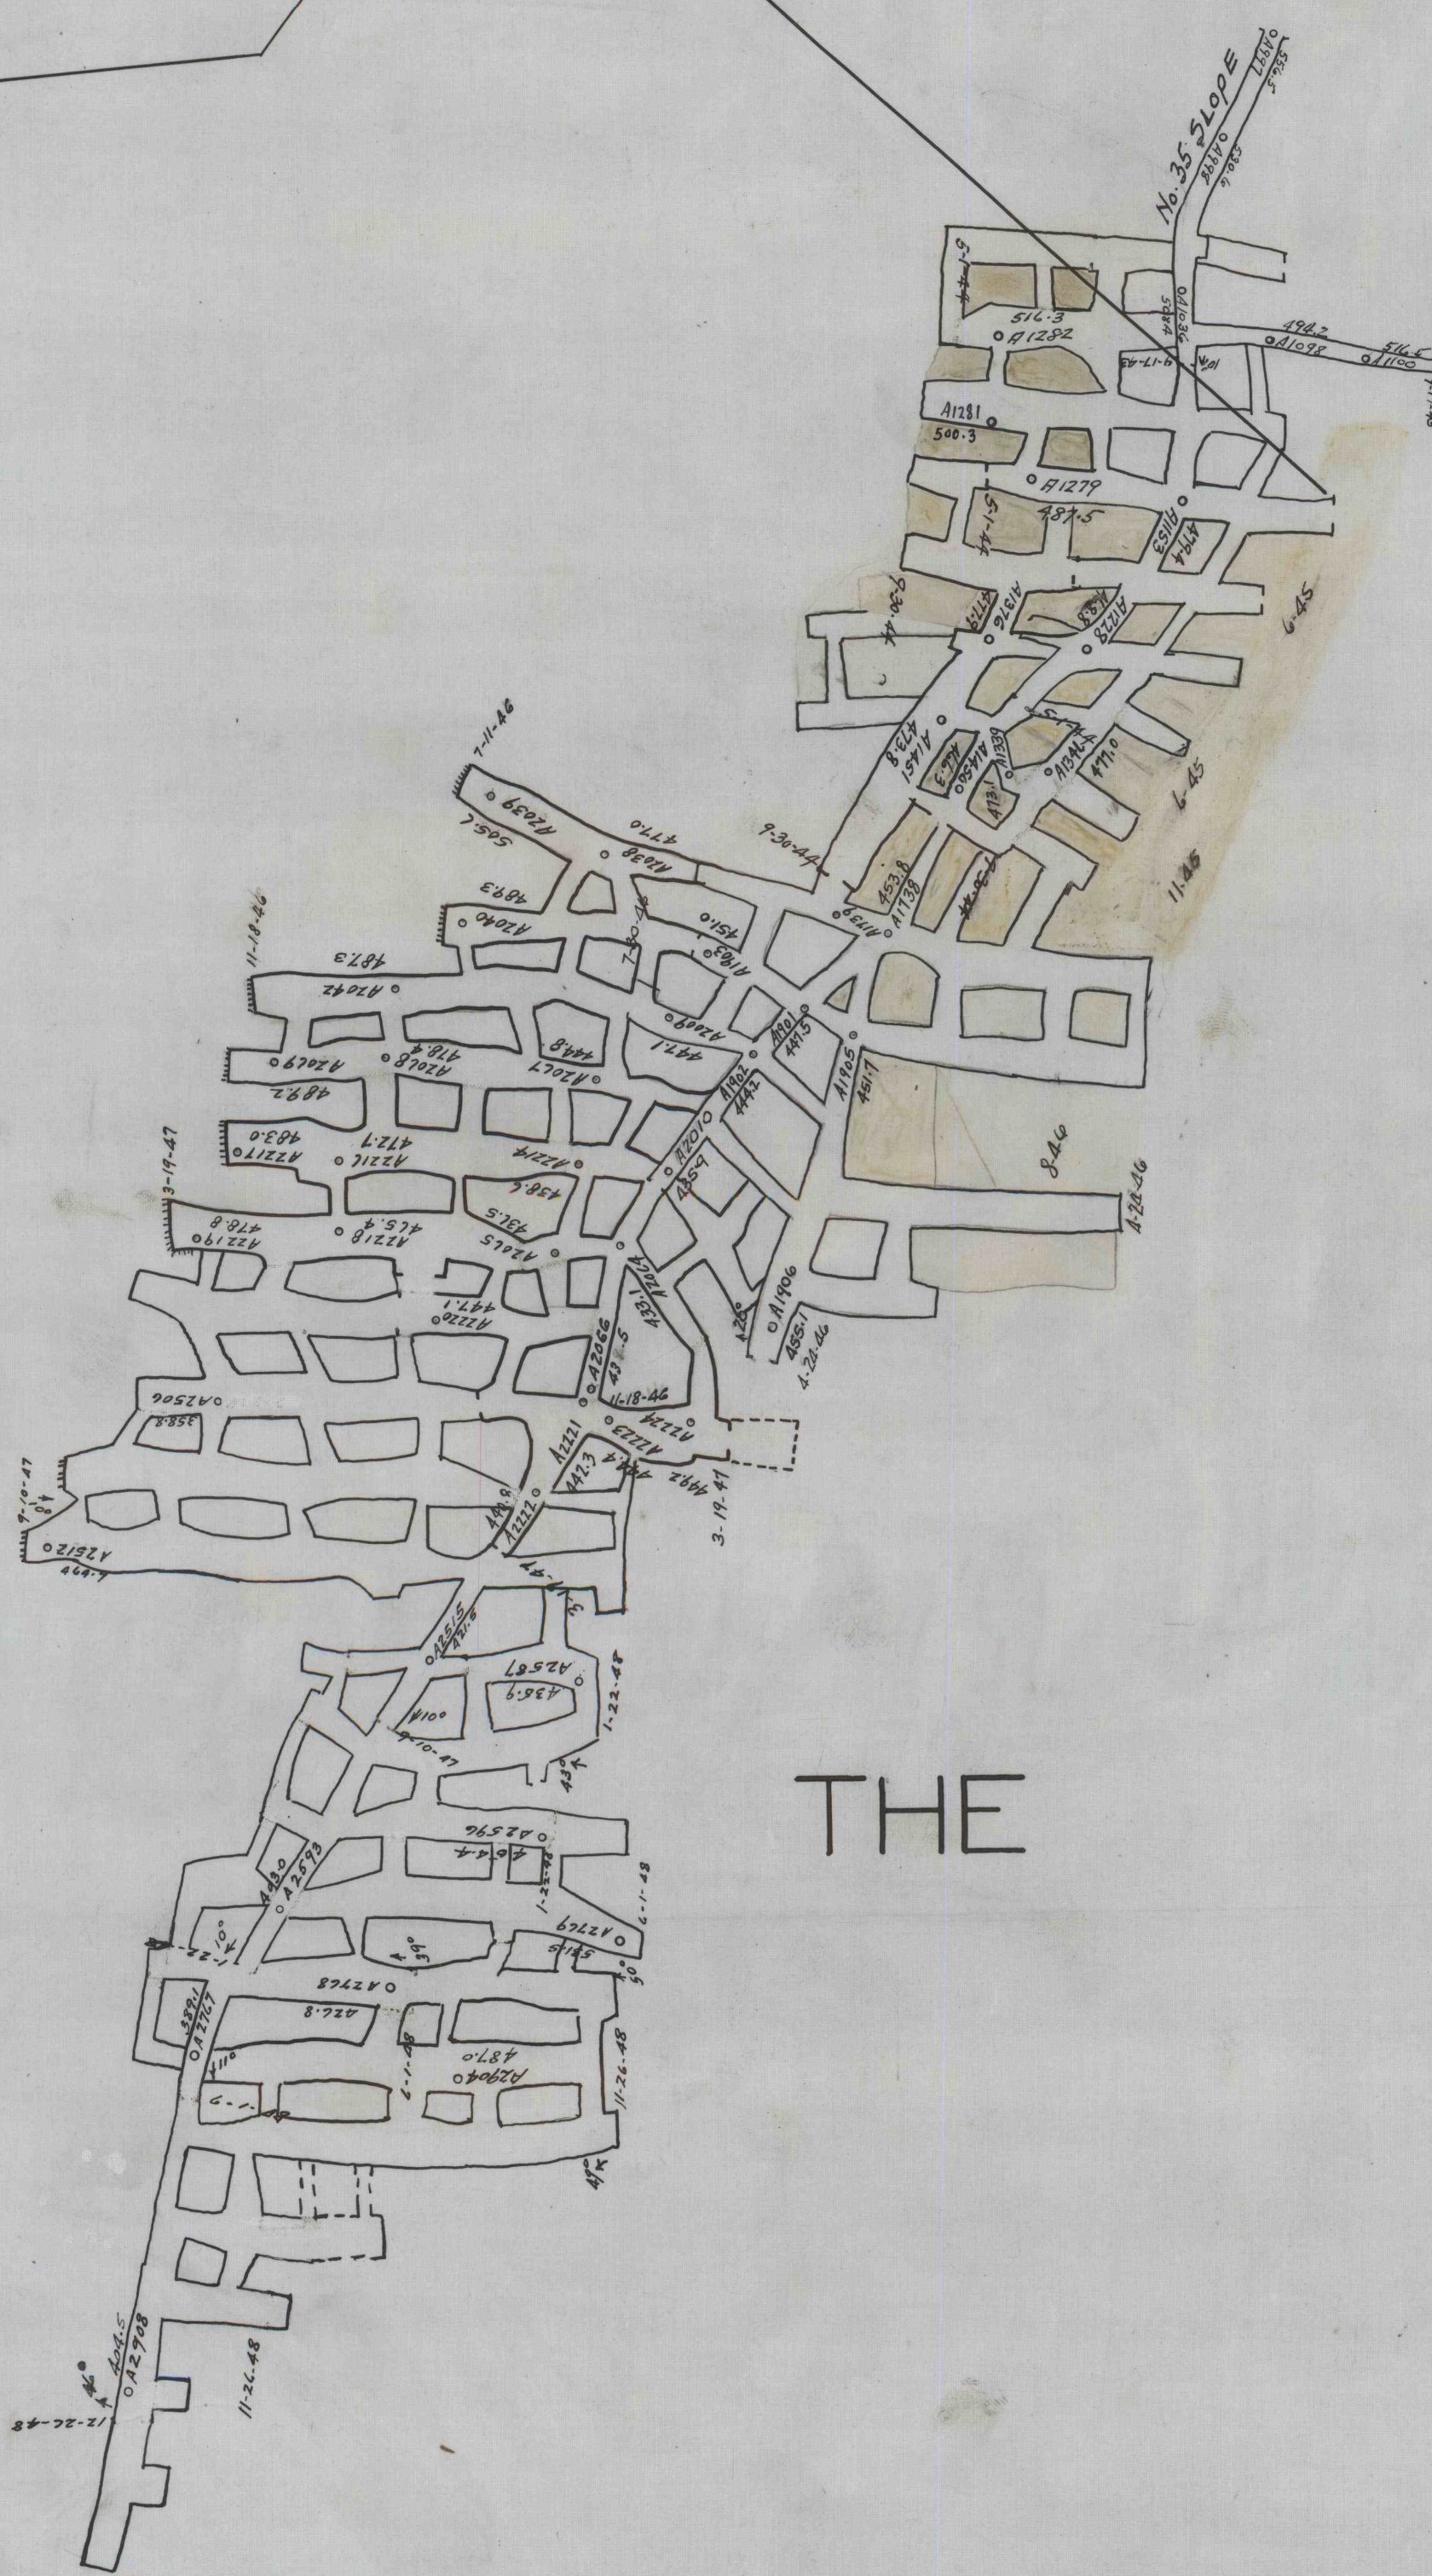

THE

HUDSON

COAL

CO.

CORNYLIUS SHAF

LEHIGH

VALLEY

COAL

CO

TRACING

MINE INSPECTOR'S

NORTHERN FIELD

COLLIERY

BALTIMORE

PLAINS TWP, LUZERNE COUNTY, WILKES-BARRE, PA.

1:100'

C. BED

SEP 21 1935