


THE

DELAWARE

&

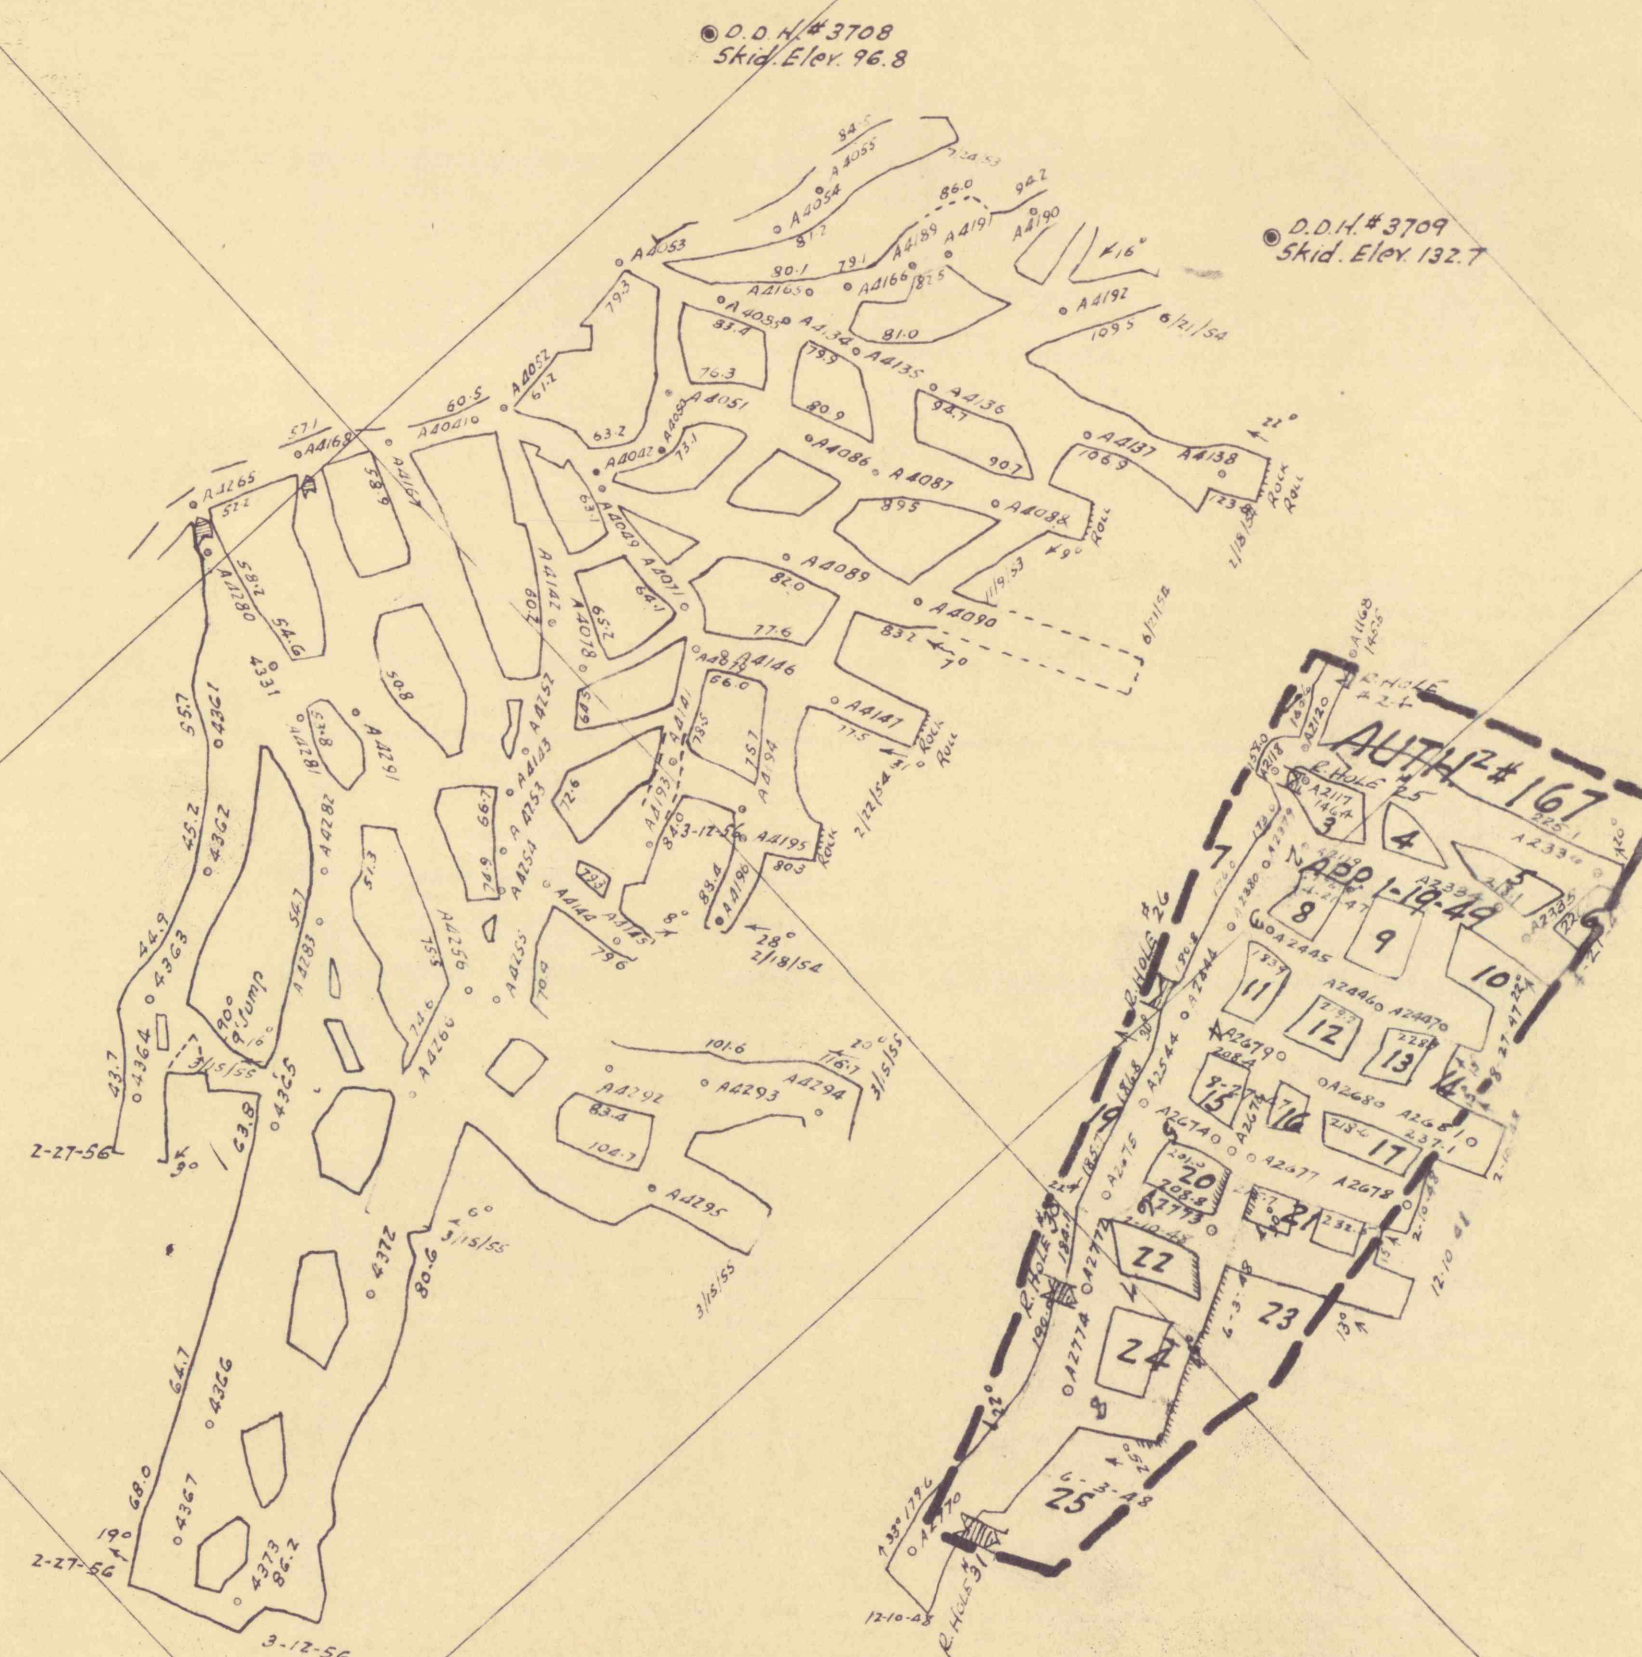

DEL.

NORTHERN FIELD  
BALTIMORE COLLIERY.  
TOP SKIDMORE BED...  
PLAINS TWP., LUZERNE CO.,  
WILKES-BARRE, PA.

HUD.

CO.

DENNIS MACKIN

W. SYMONS