


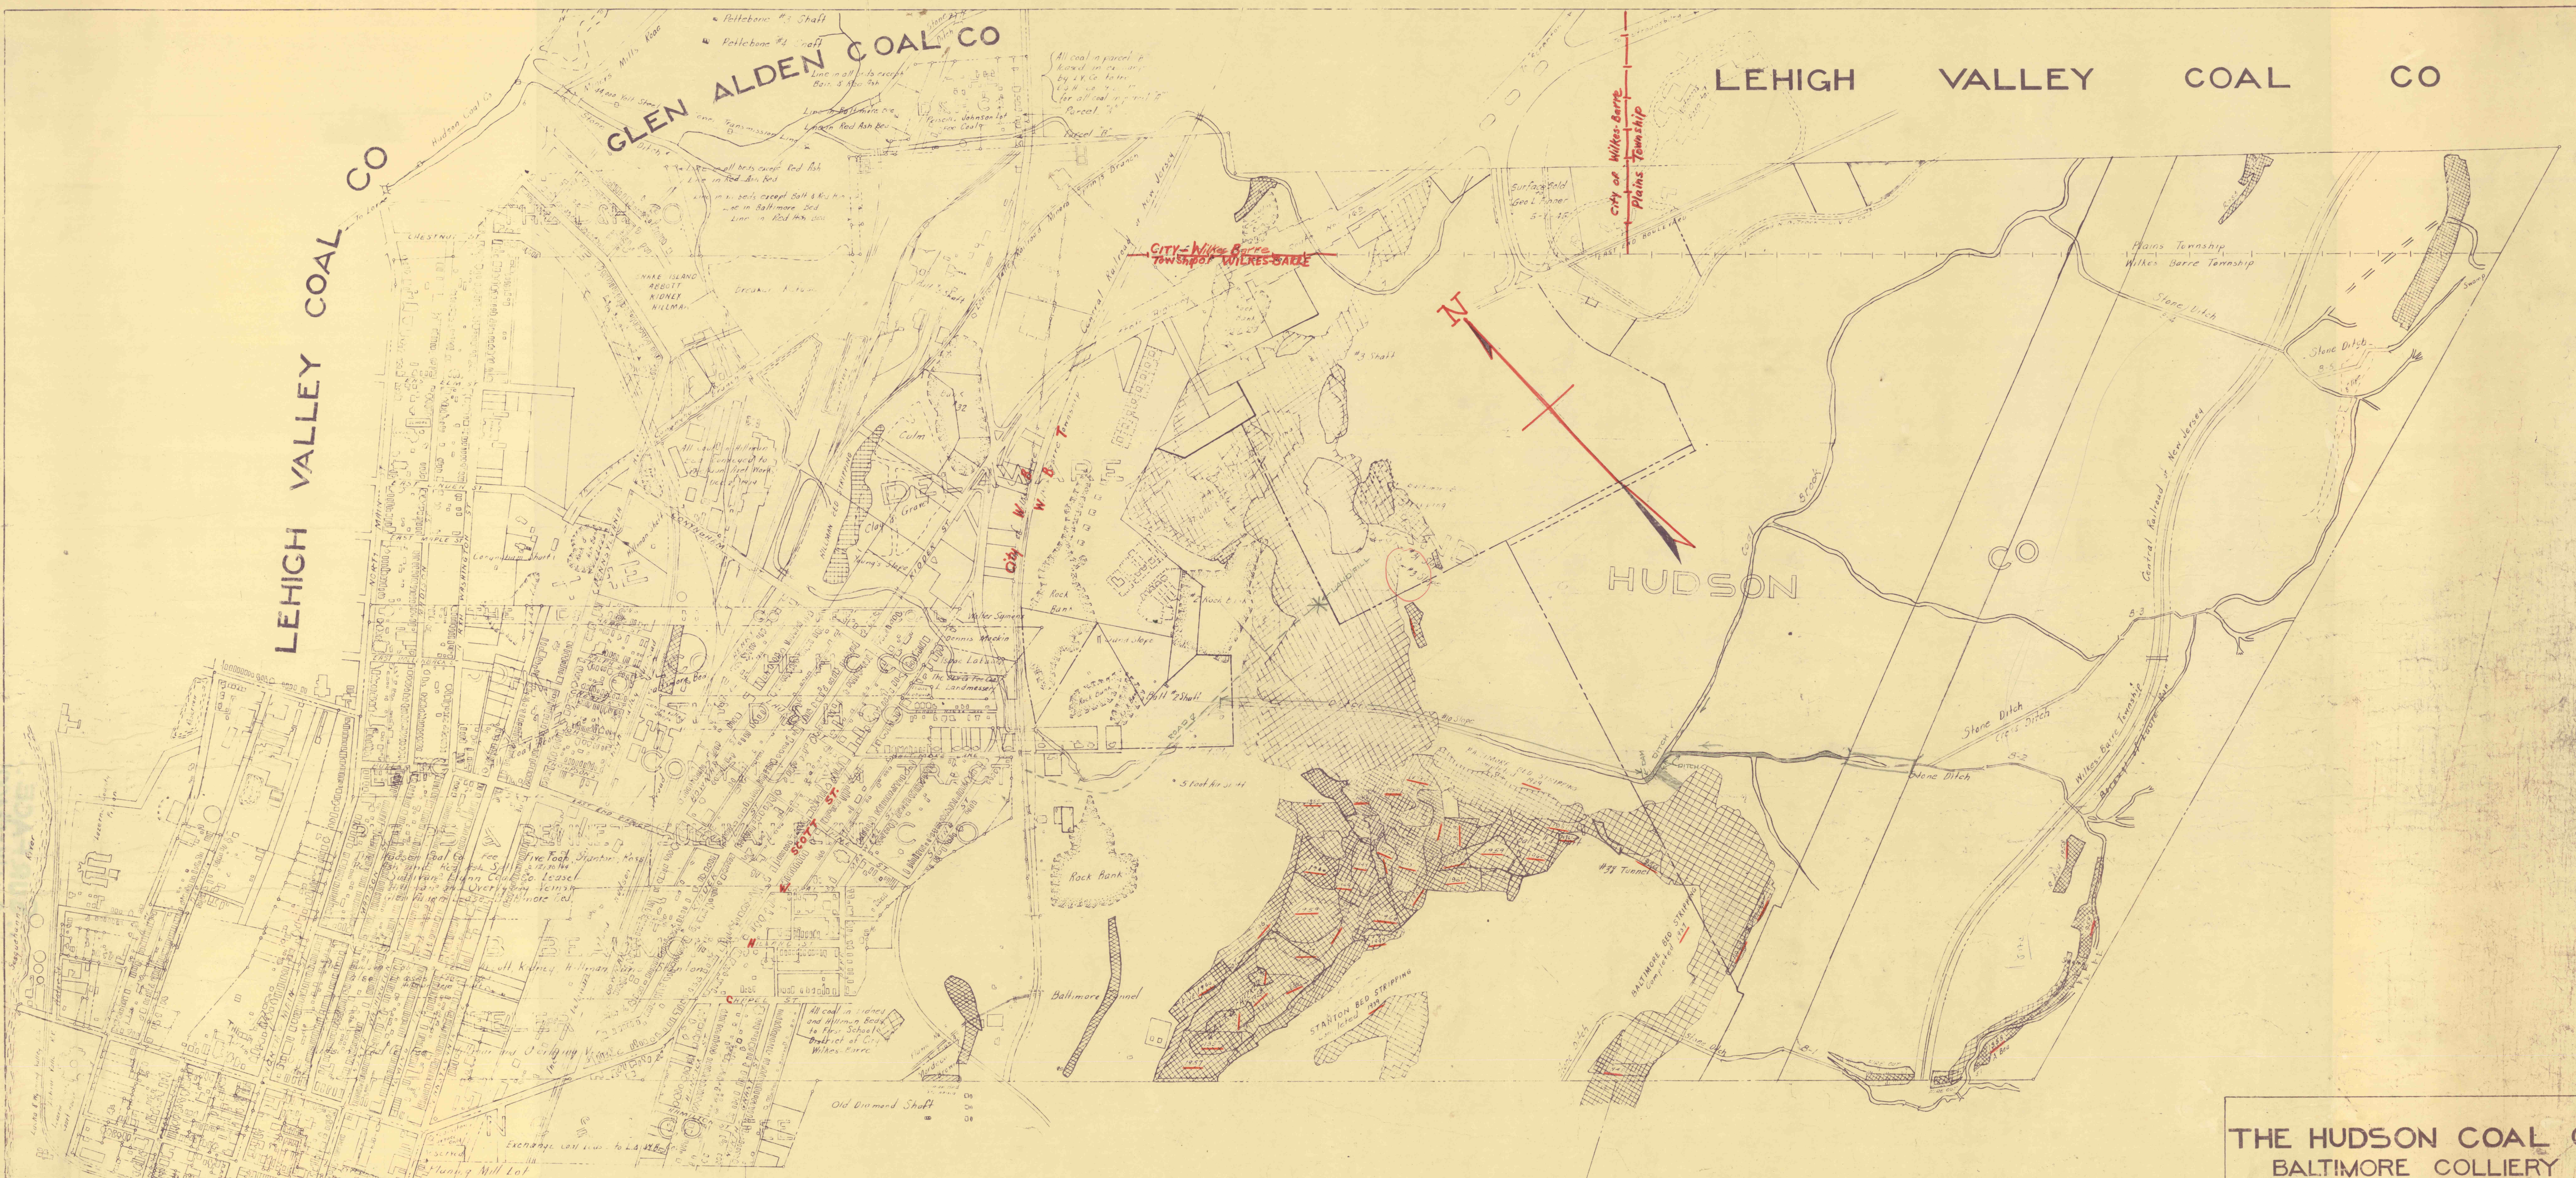

NORTHERN COAL FLD
BALTIMORE-COAL BROOK
LUZERNE COUNTY. 1"=400'
WILKES-BARRE CITY, PA
W-B, TWP.

THE HUDSON COAL CO
BALTIMORE COLLIERY
SURFACE

OFFICE OF THE MINING ENGINEER
SCRANTON, PA.

SCALE 1"=400'

DEC. 1944