
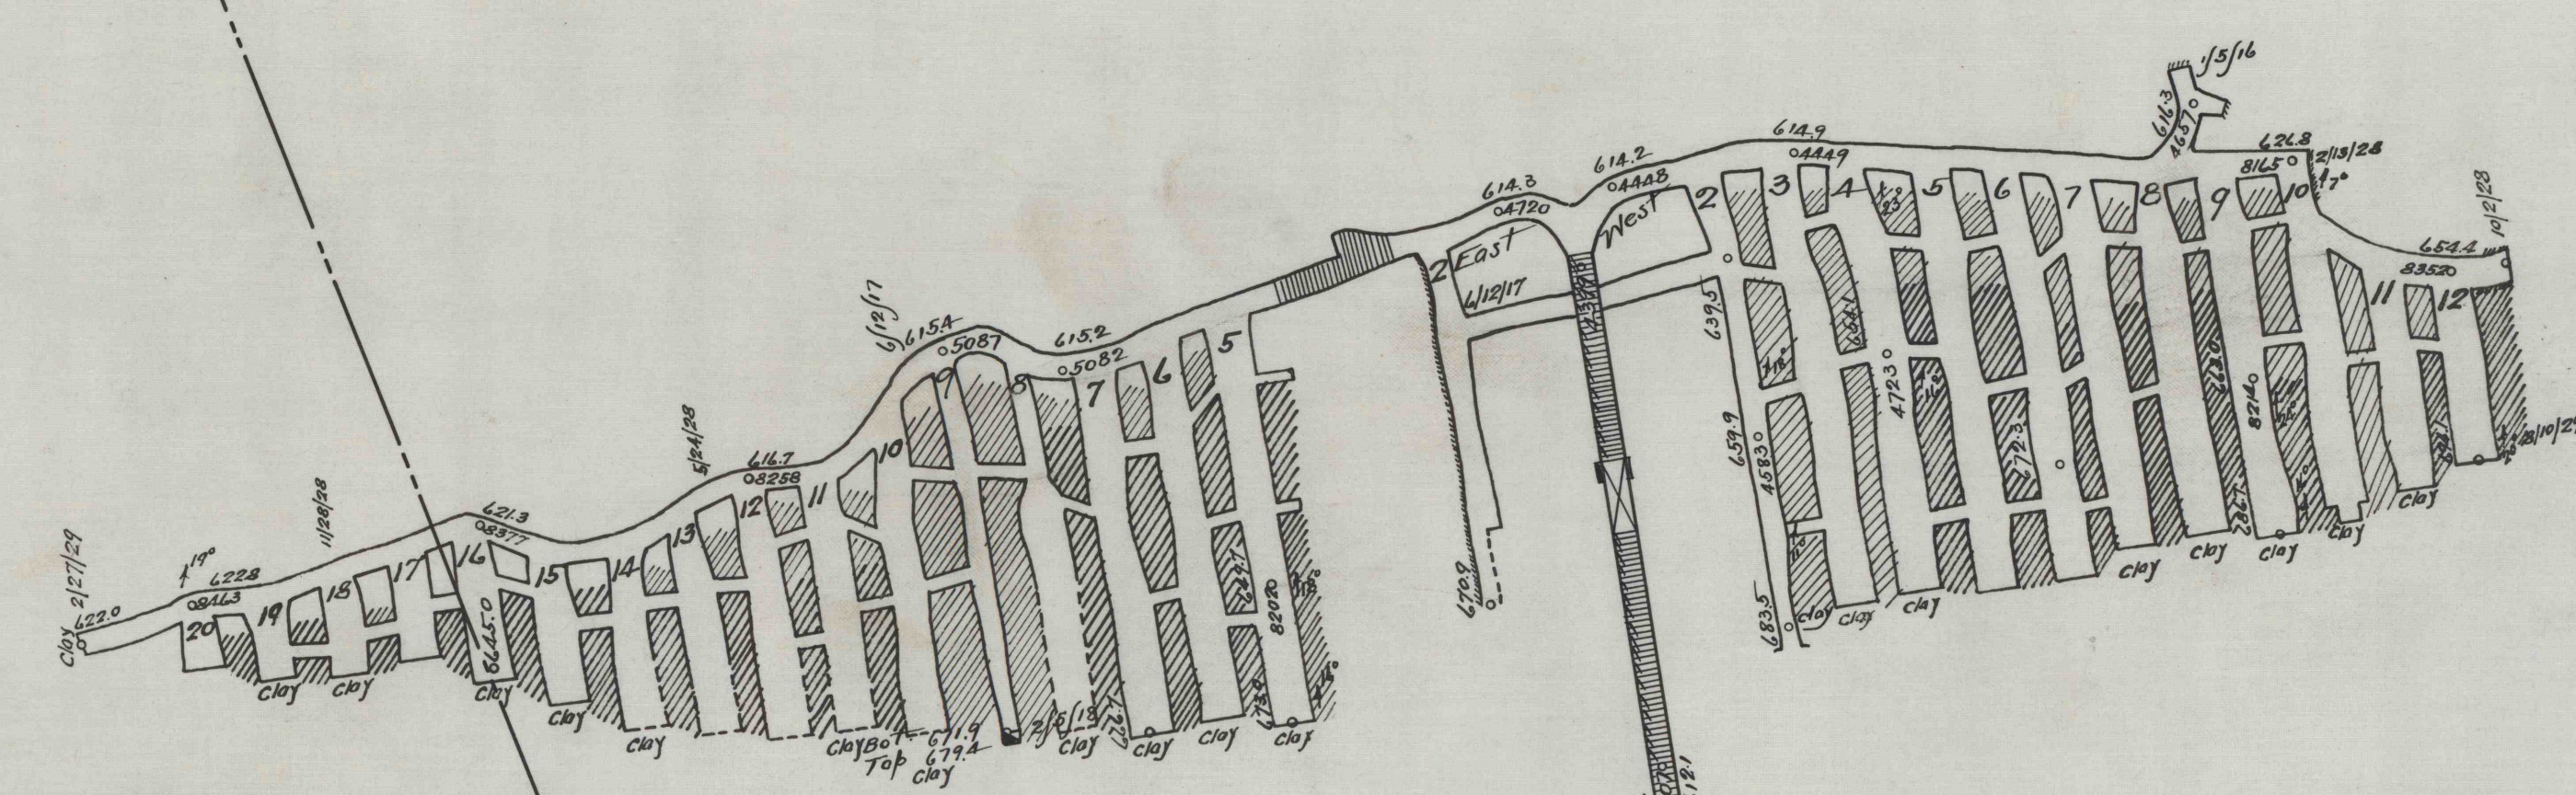


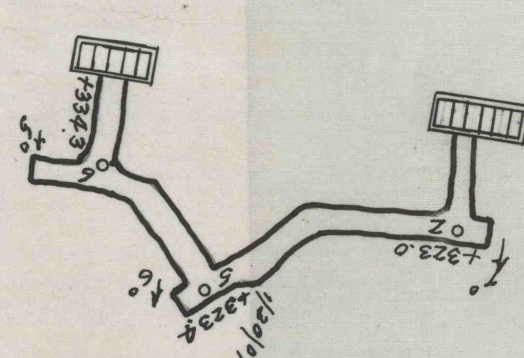

Extended Top	2	1920
"	20	1921
"	4	1922
"	2.1	1923
"		1924
"		1925
"		1926
"		1927
"		1928
"	17	1929
"	17	1930
COLLIERY
 No. 6. VEIN
 NORTHERN ANTHRACITE FIELD

F. K. Kite

..1 of 5..

All in Hanover Twp.
 No. 6 Vein

Go down to No. 3 Vein