


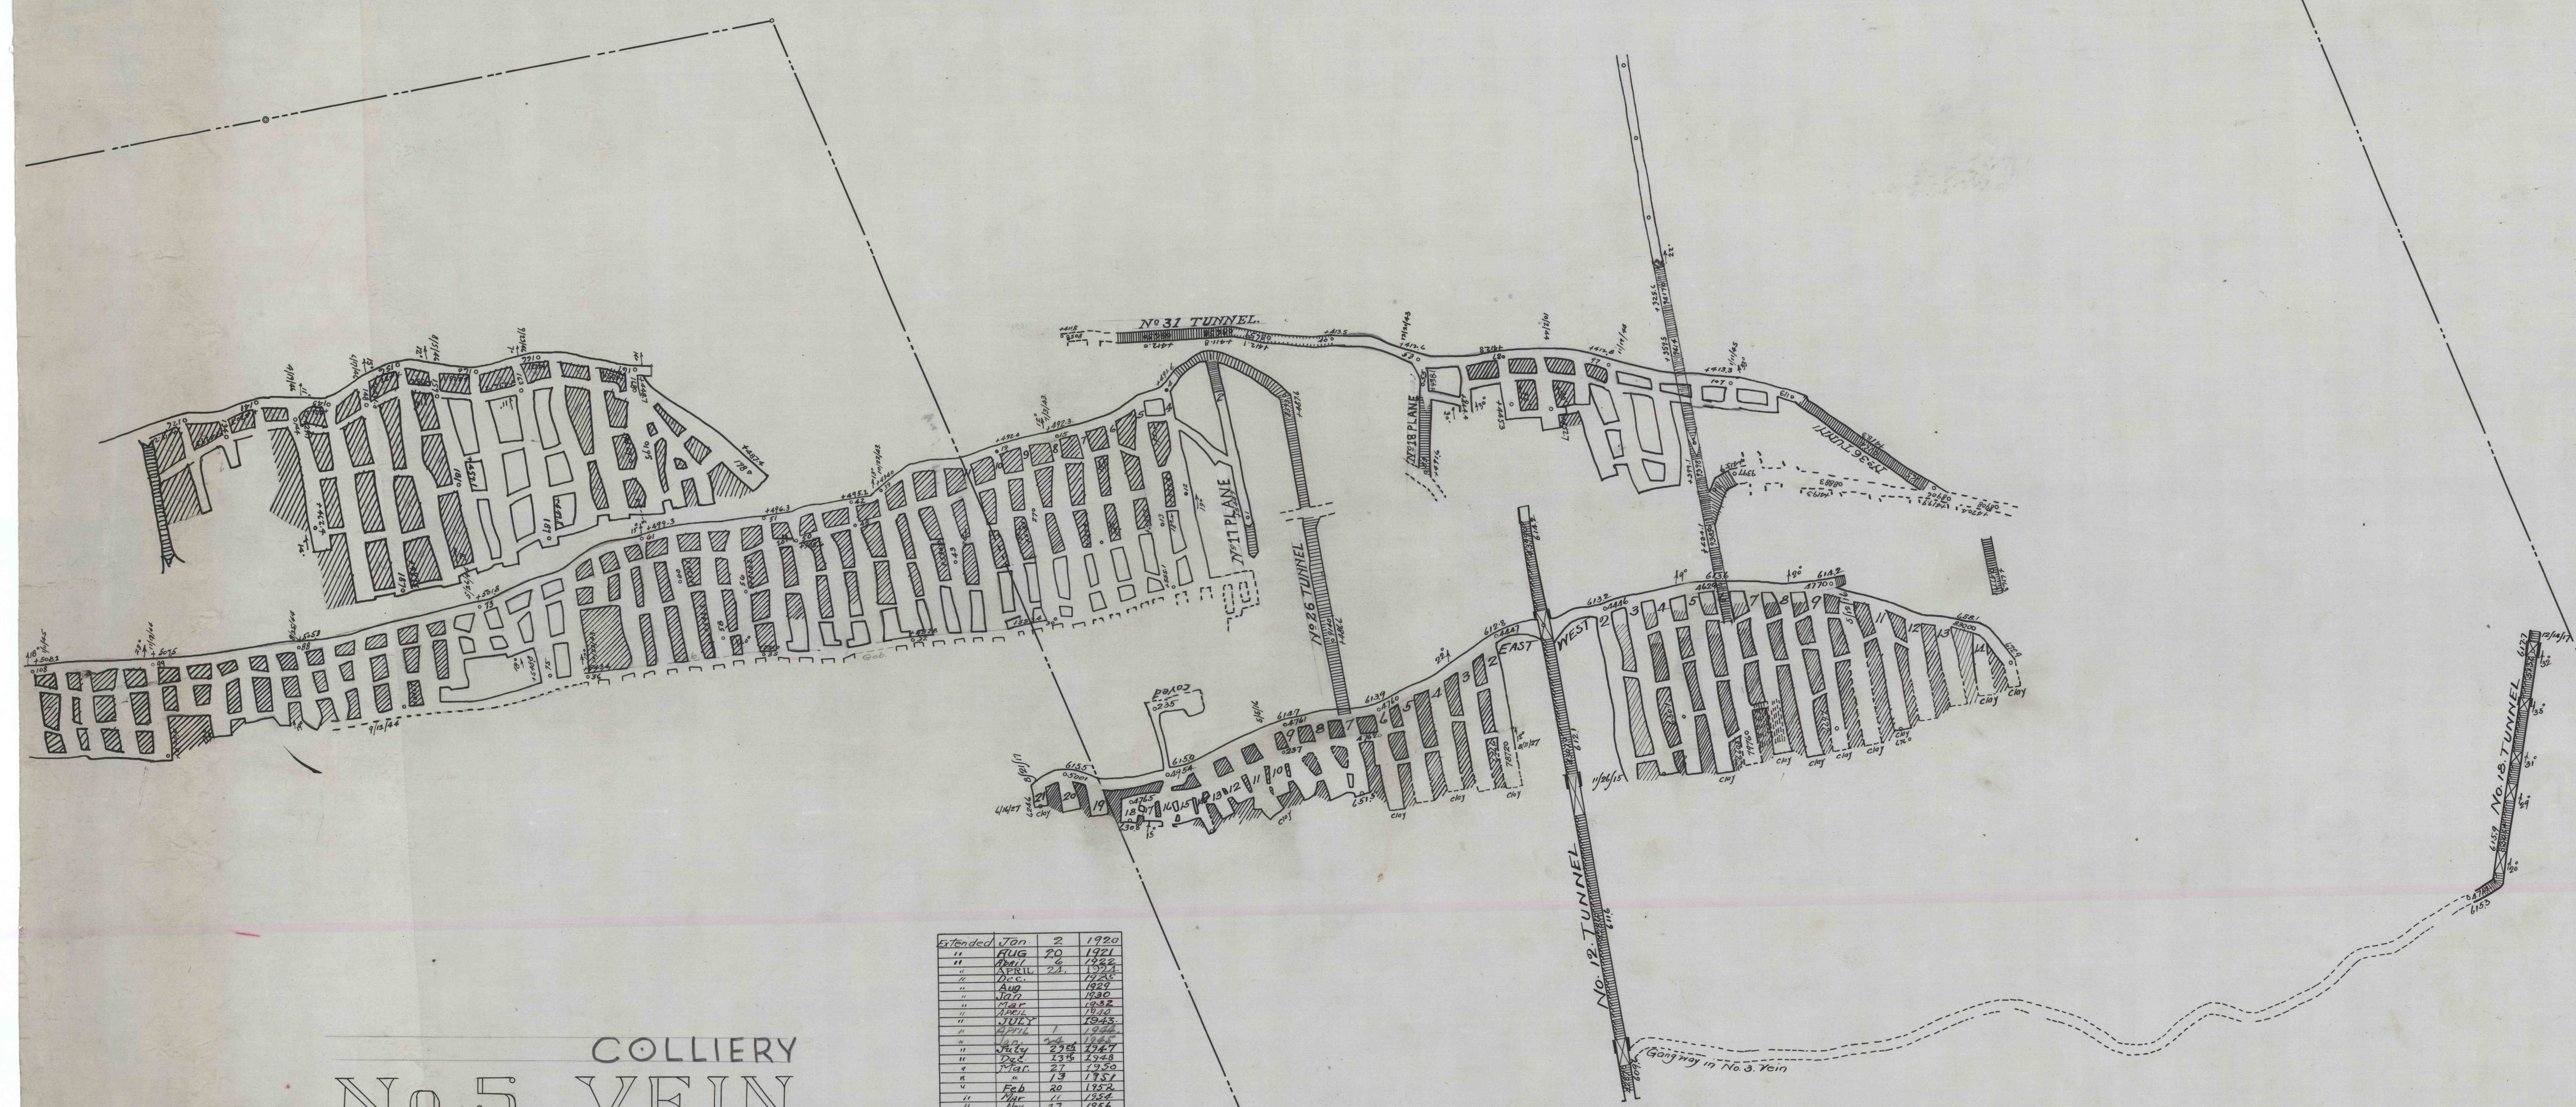

COLLIERY
No. 5. VEIN
 NORTHERN ANTHRACITE FIELD
 HANOVER TWP.
 F. Kille

Checked	Jan	2	1920
"	Aug	20	1921
"	Dec	23	1921
"	Aug		1922
"	Nov		1922
"	Dec		1922
"	Jan		1923
"	Feb		1923
"	Mar		1923
"	Apr		1923
"	May		1923
"	Jun		1923
"	Jul		1923
"	Aug		1923
"	Sep		1923
"	Oct		1923
"	Nov		1923
"	Dec		1923
Checked	Nov	27	1929

All in Hanover Twp.