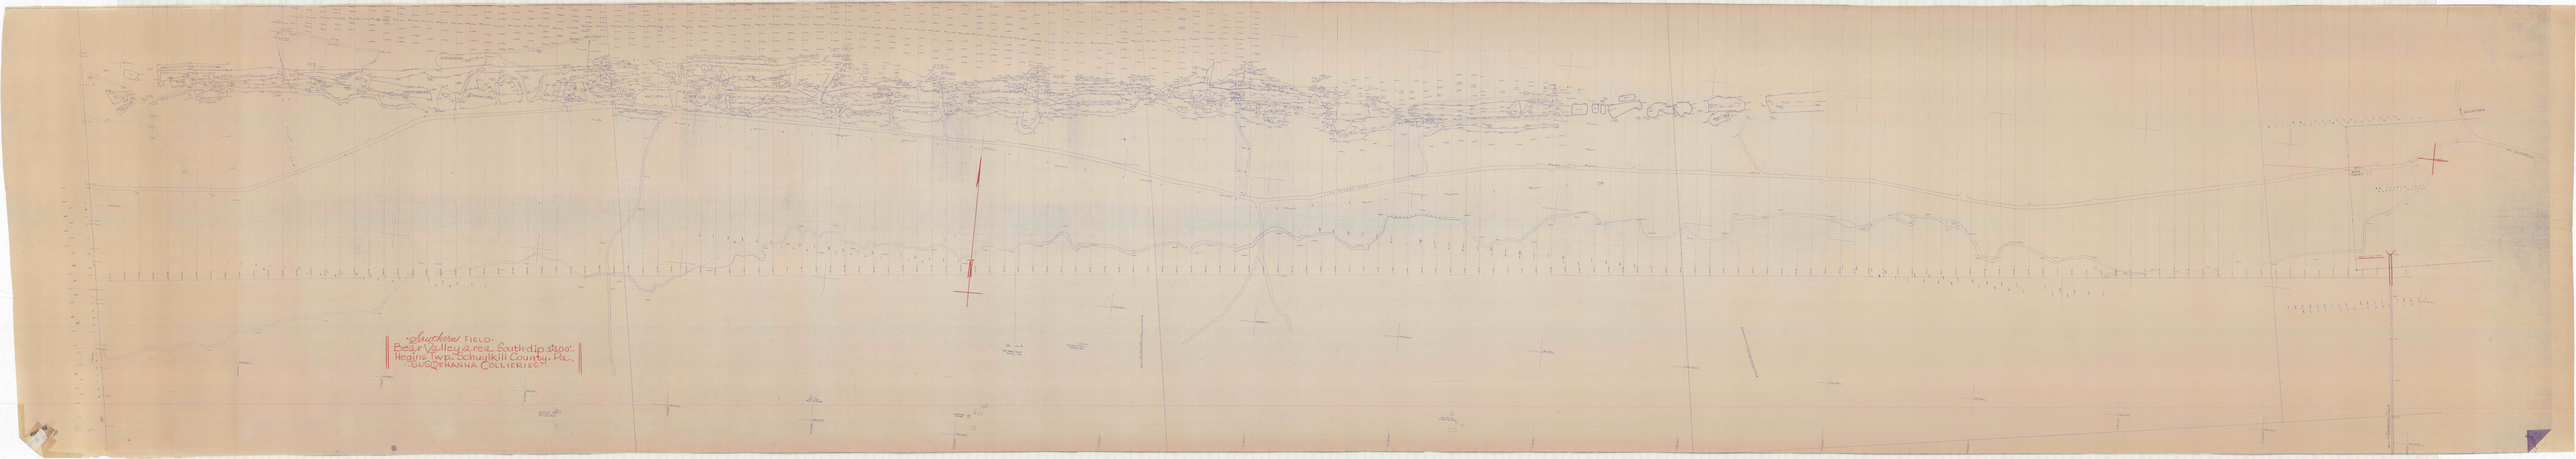
Southern Field.
Bear Valley area. South dip 4°00'.
Hegins Twp. Schuylkill County, Pa.,
Susquehanna Collieries